



PARENT PARCEL: 14-00-026-000-013
CHILD PARCEL: --SAME--
STARTING POINT: NE CORNER OF O.L. 26

07-01533-X

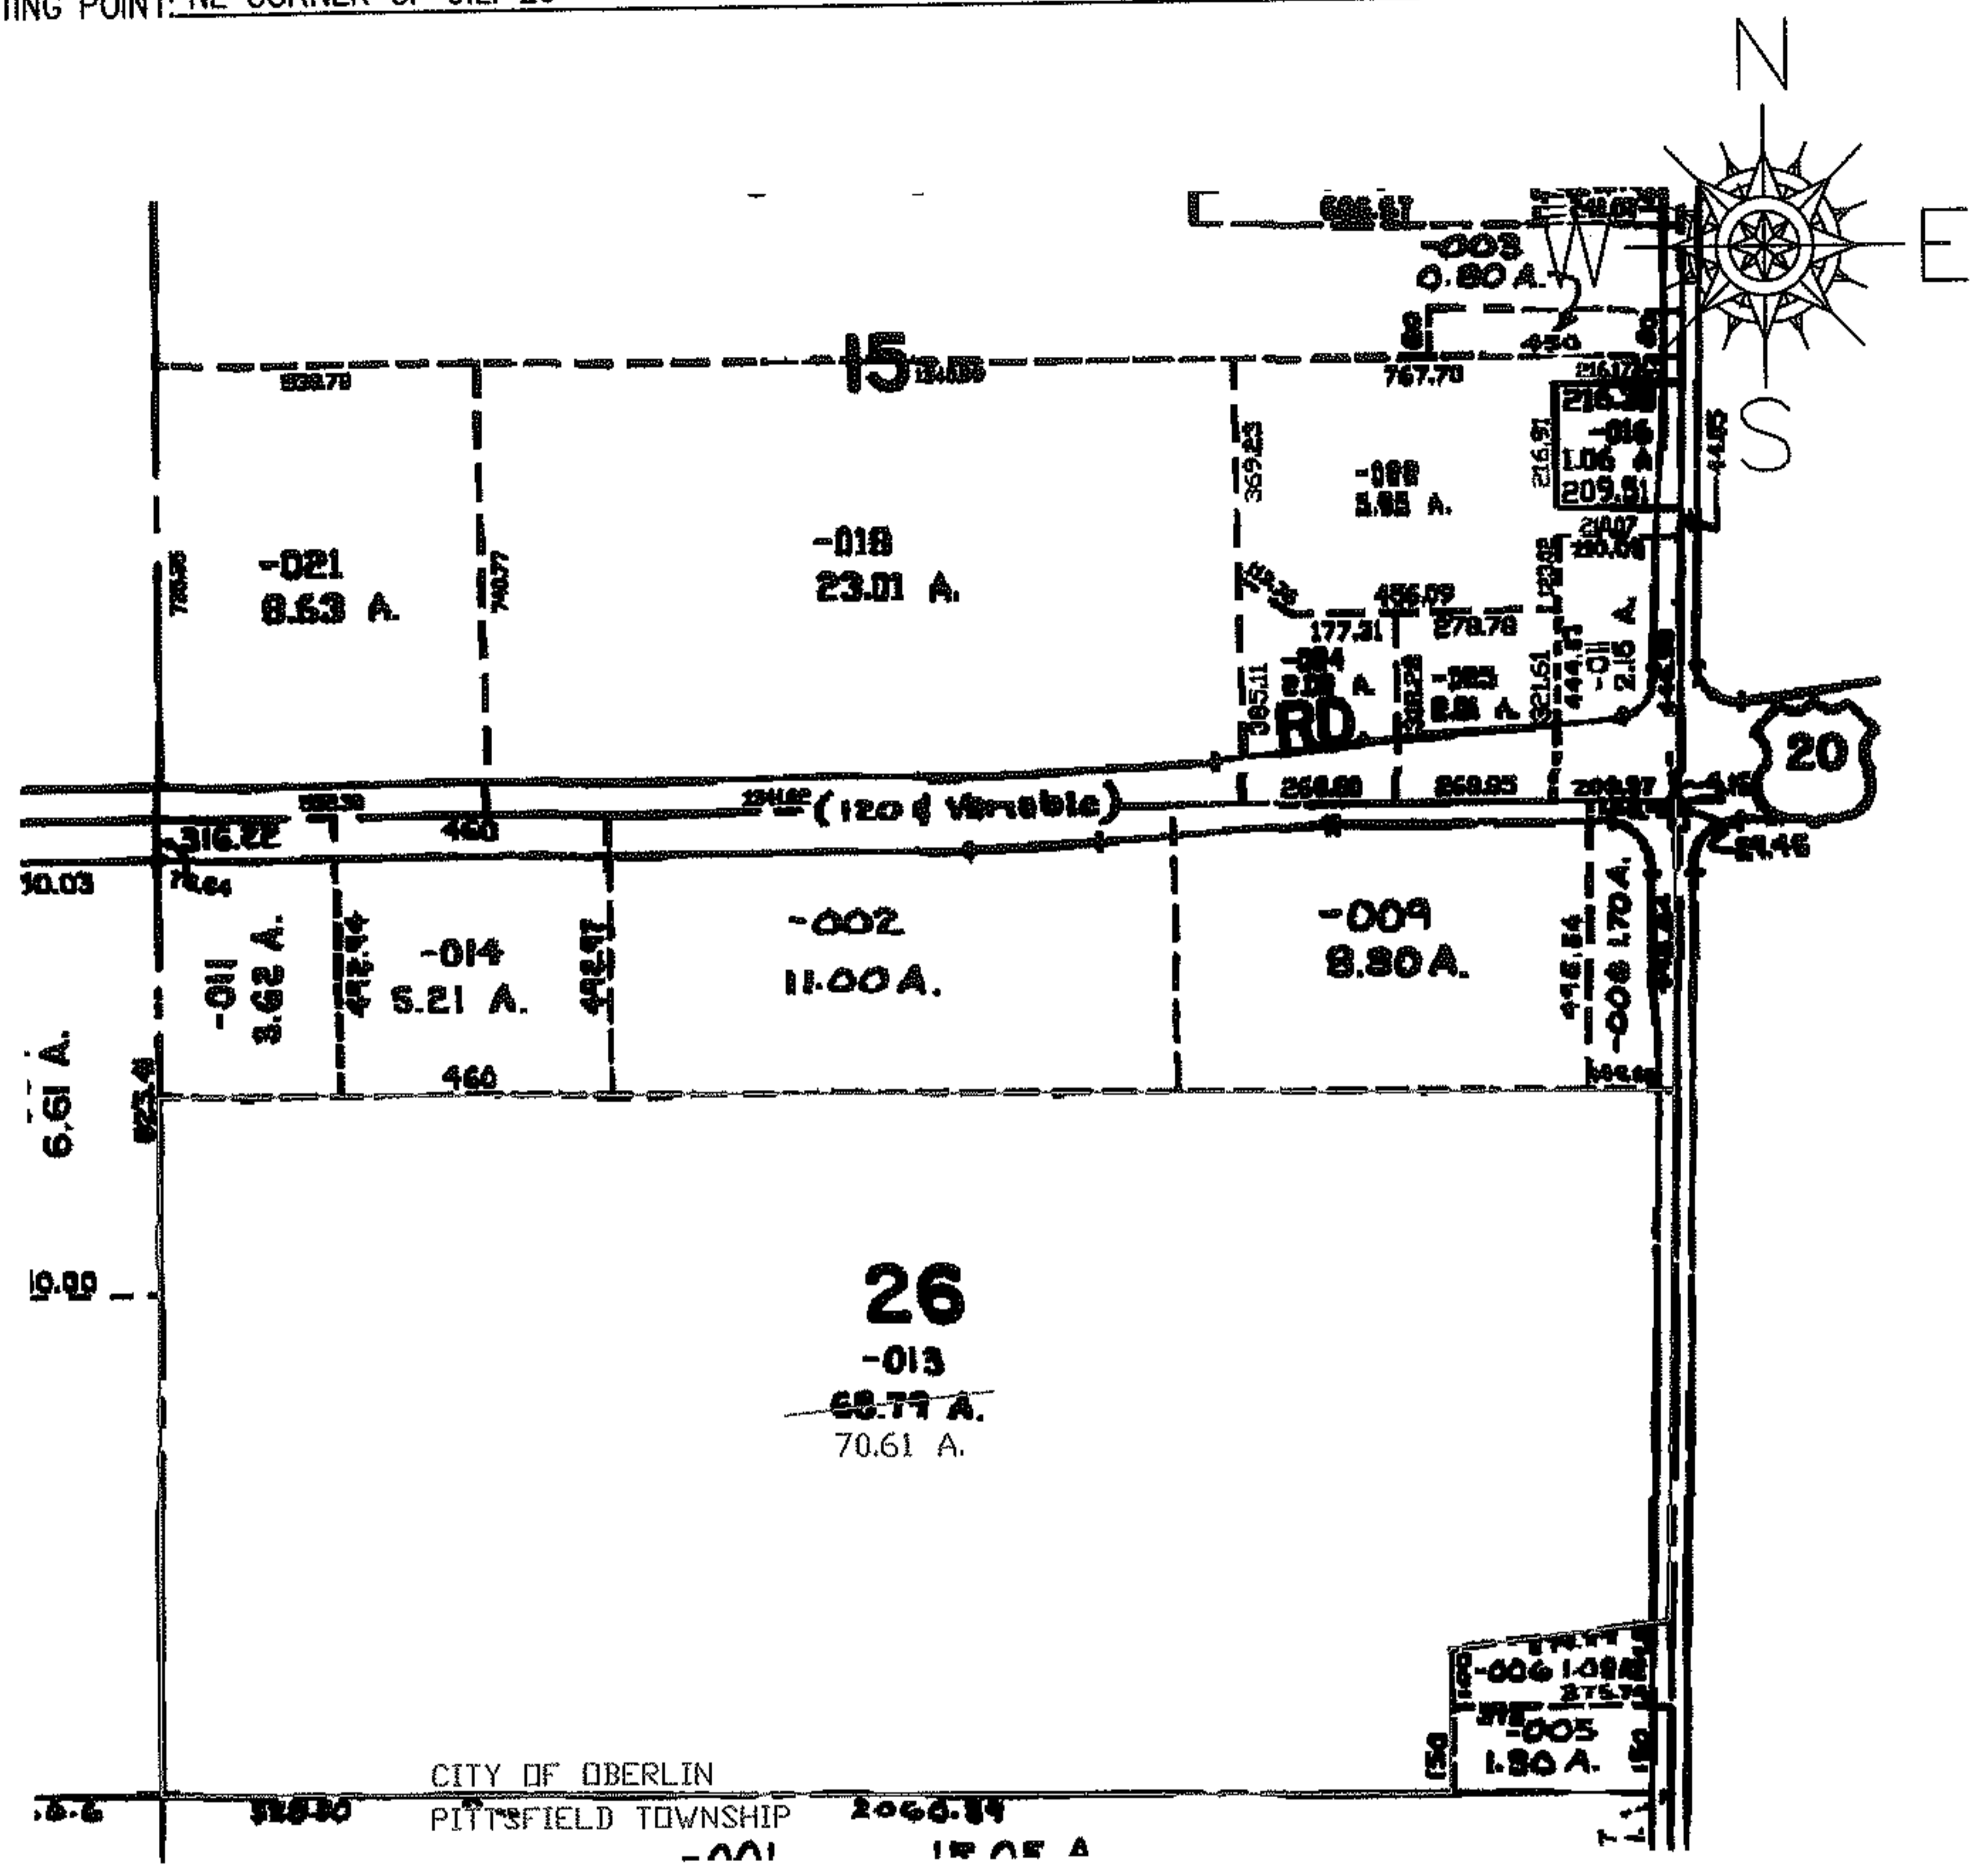

ANNEXATION 70.61 A. FROM
PITTSFIELD TO OBERLIN
AC. CORR. PER SURVEY
ERIC NELSON

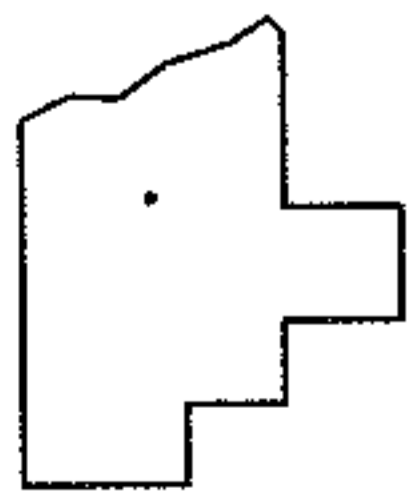

SPLITS/DEEDS PROCESSED
LORAIN COUNTY TAX MAP DEPARTMENT
226 MIDDLE AVE. ELYRIA, OHIO

SURVEYED BY: ERIC NELSON
CLOSURE: 1:10.000
MAP PAGE(S): 14-00-026-B
APPROVED BY: DRH DATE: 10/12/2007
SCALE: 1" = 100 PRIOR INSTRUMENT: OR 1406/530