




RASTER

PARENT PARCEL: 07-00-044-102-041

07-01537-A

CHILD PARCEL: SAME

STARTING POINT: SIDELINE OF BURNS RD & RIDGEVILLE TWP LINE

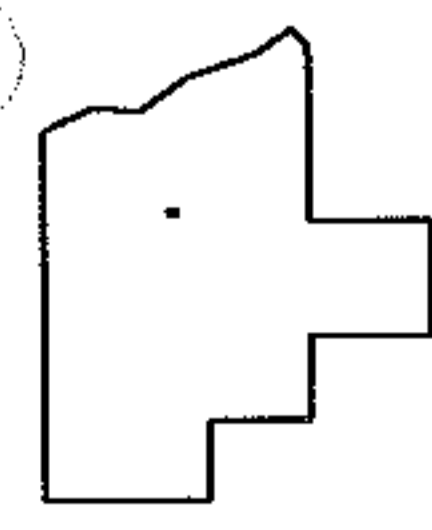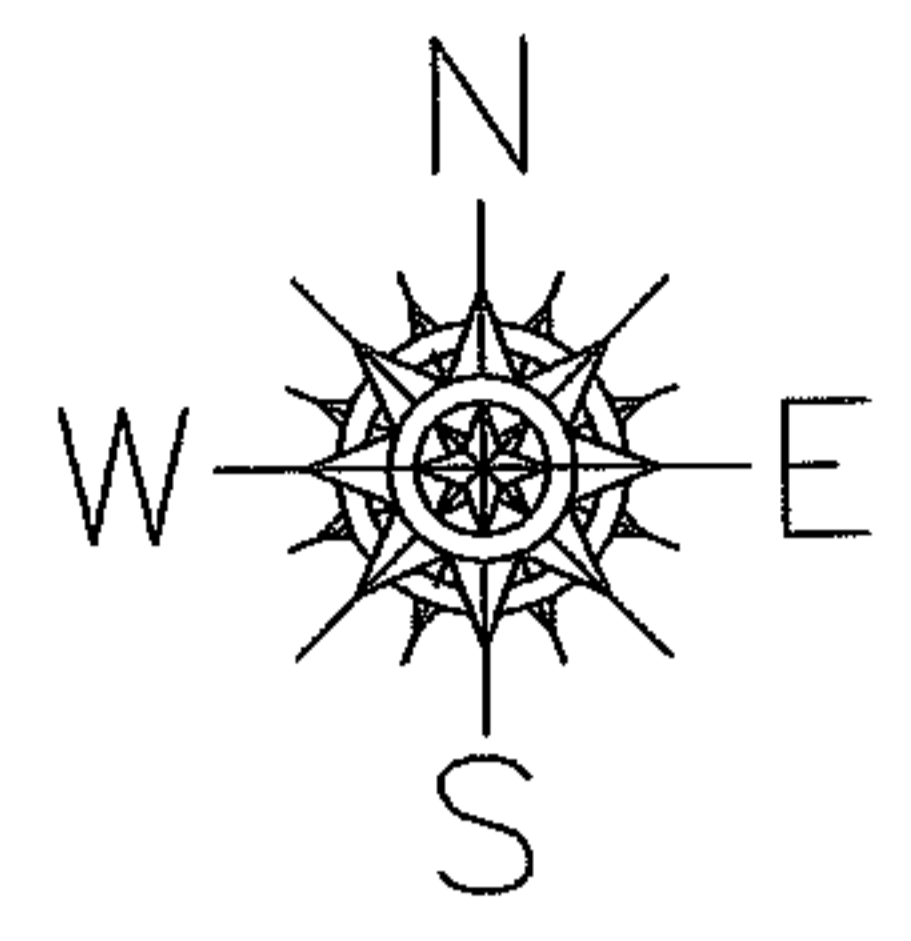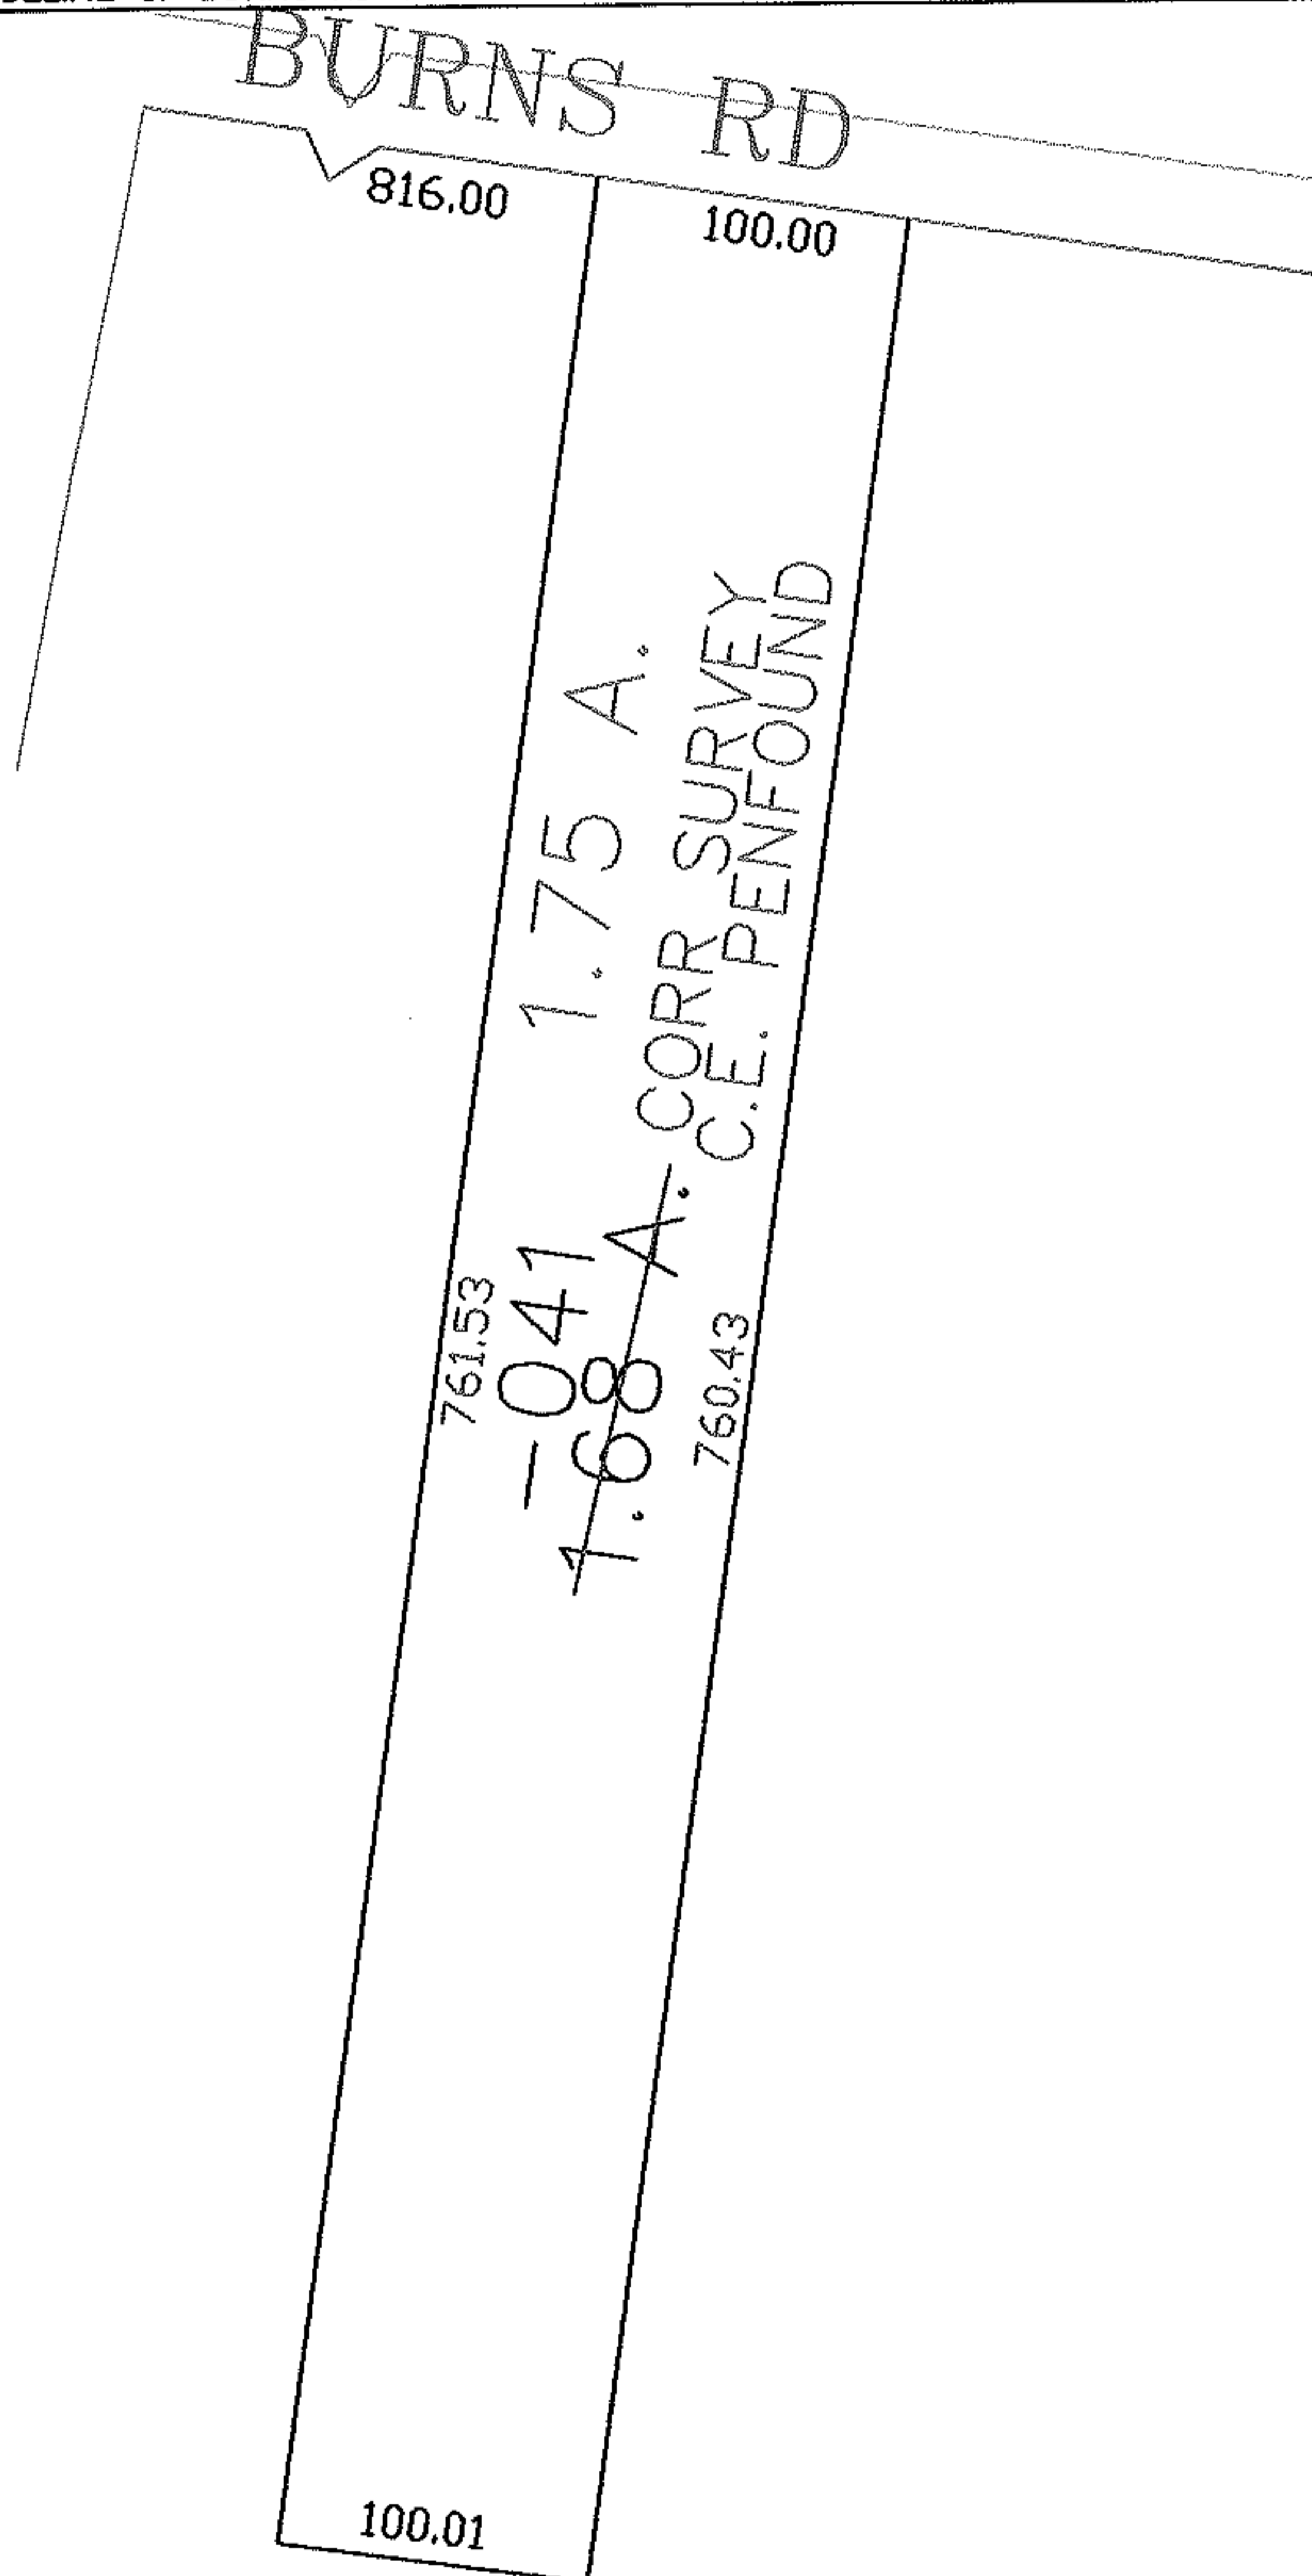

SPLITS/DEEDS PROCESSED

LORAIN COUNTY TAX MAP DEPARTMENT
226 MIDDLE AVE. ELYRIA, OHIO

SURVEYED BY: C.E. PENFOUND

CLOSURE: 0.00 : 10.000

MAP PAGE(S): 07-00-044-A

APPROVED BY: JAH DATE: 10-04-07

SCALE: 1" = 100 PRIOR INSTRUMENT: DV 546/20