




PARENT PARCEL: 15-00-020-000-045

07-01541-A

CHILD PARCEL: --SAME--

STARTING POINT: INT CL NICKLE PLATE DIAGONAL AND KIPTON NICKLE PLATE

AC. CORR.
PER SURVEY
RICHARD CARLSON

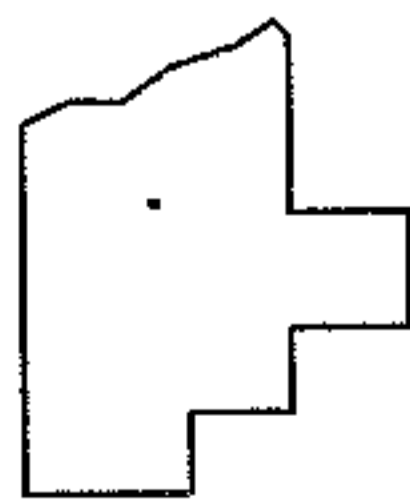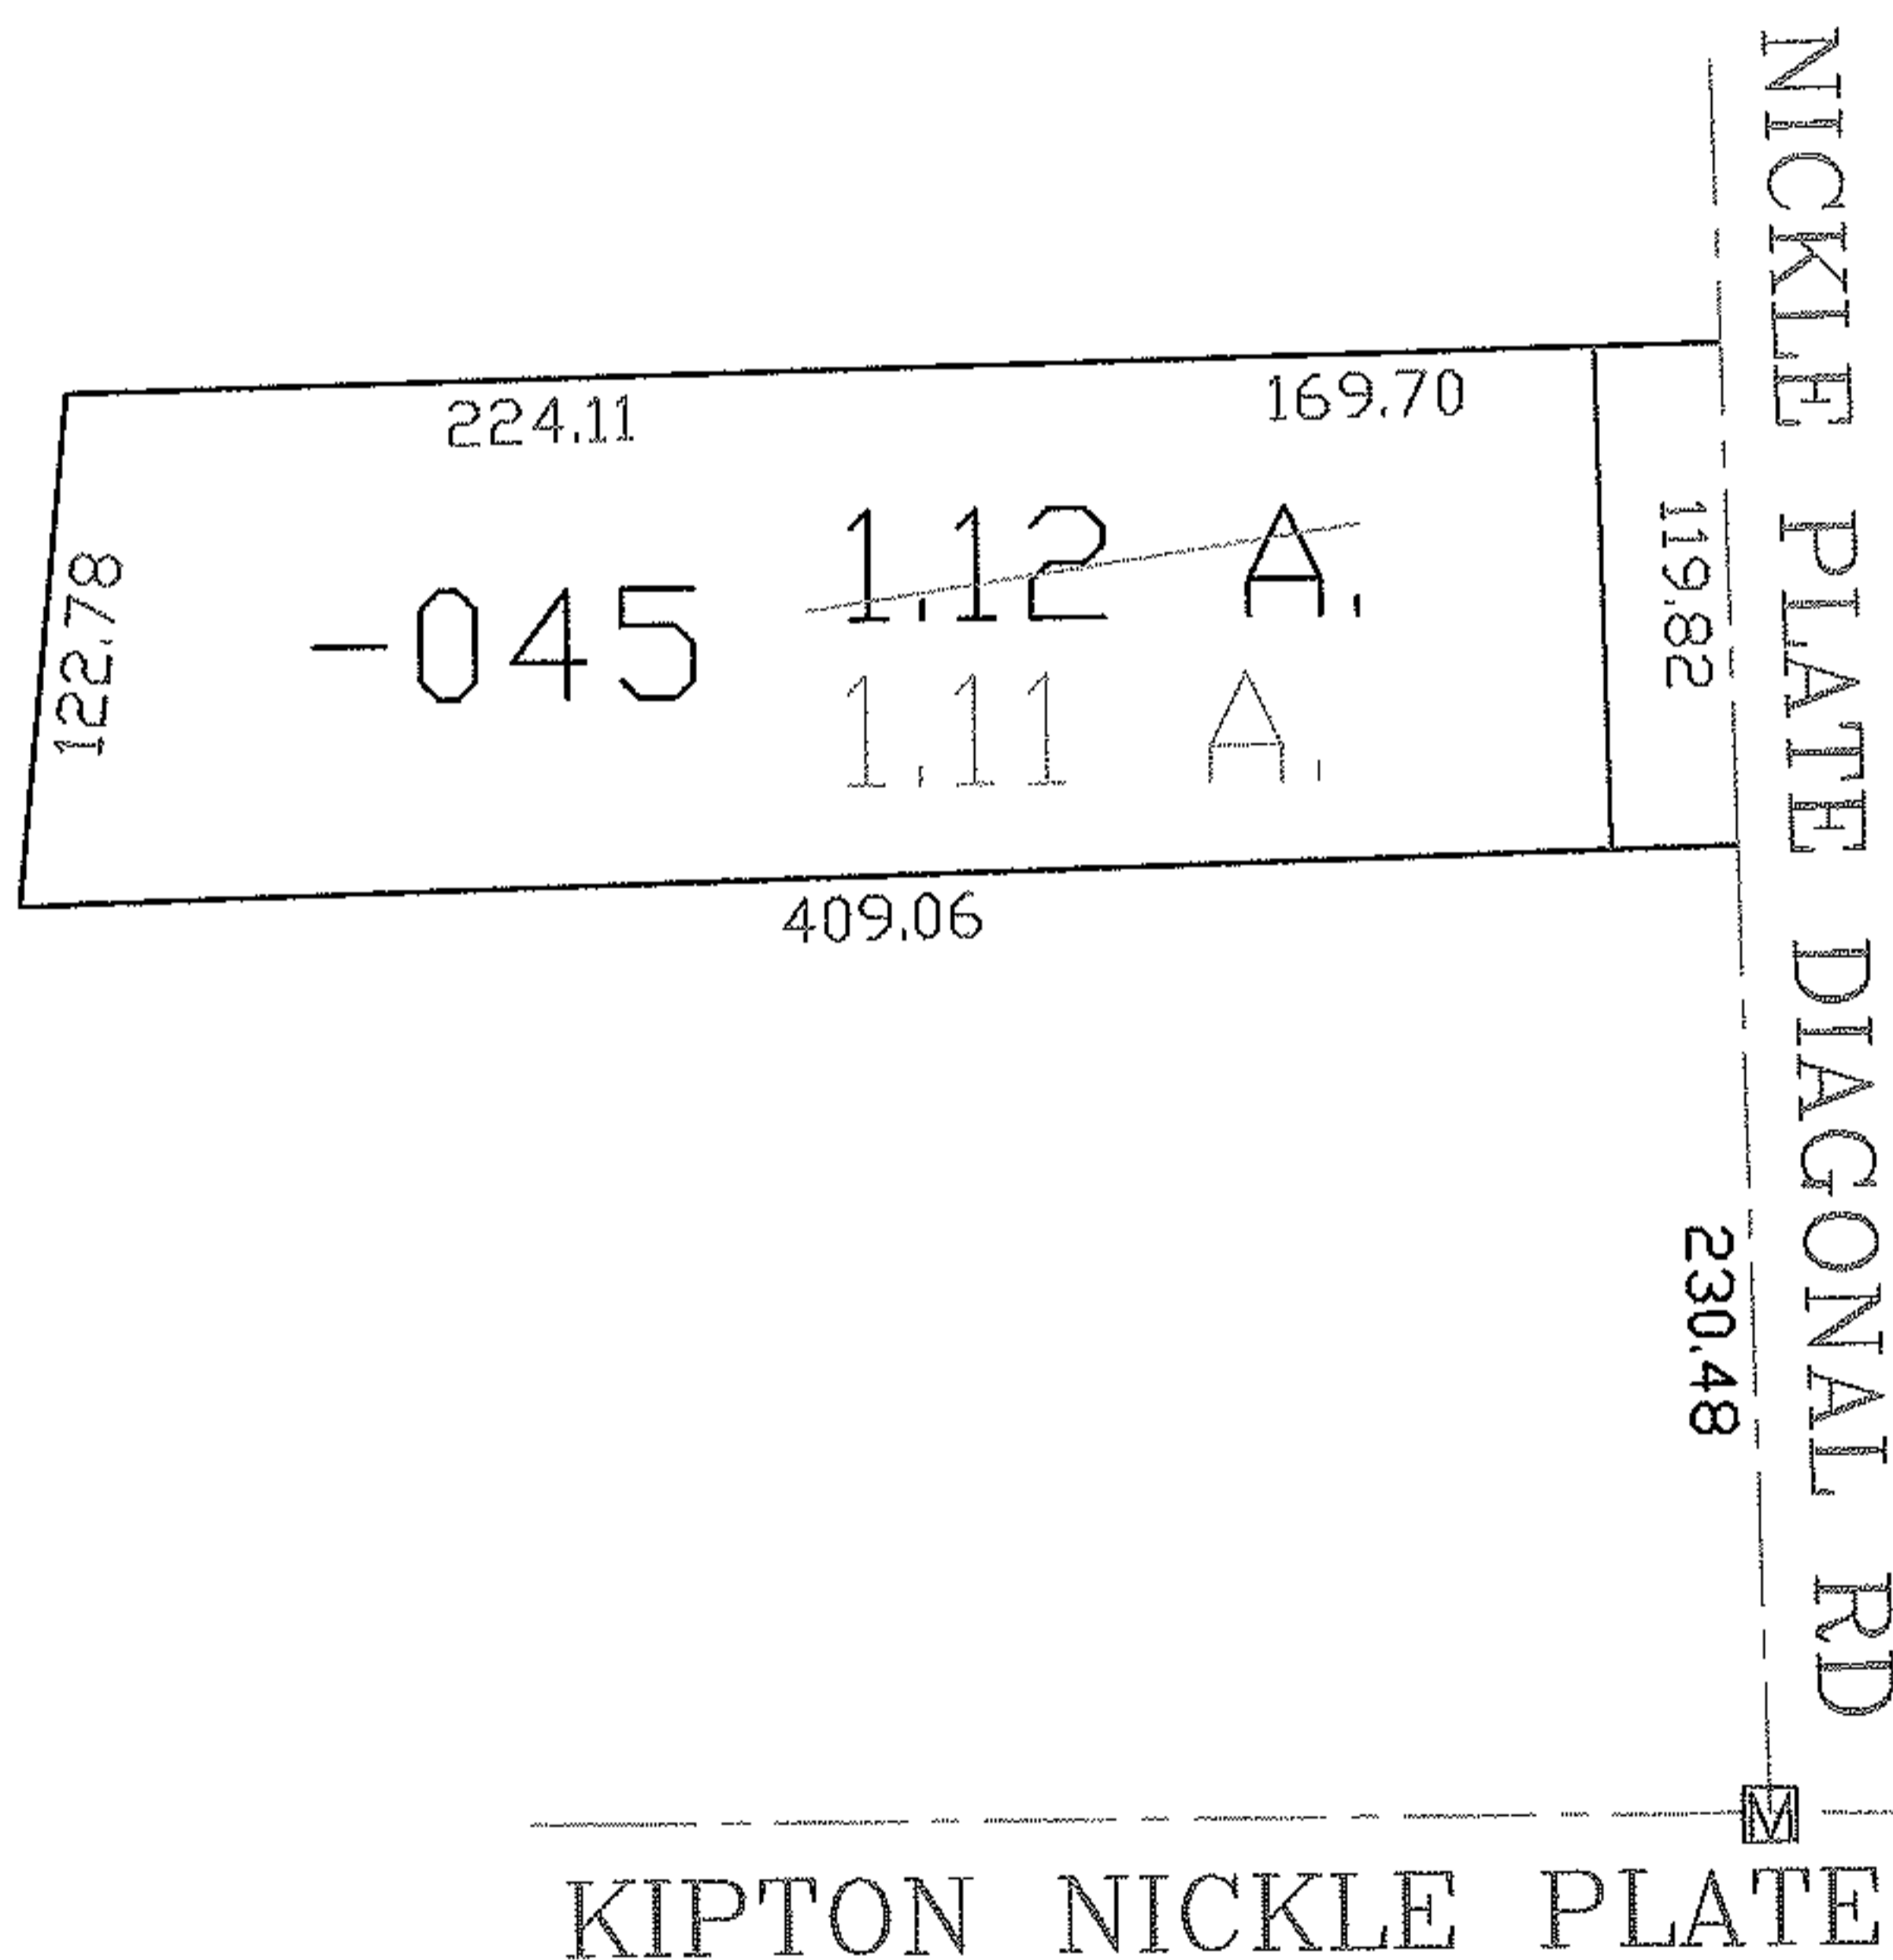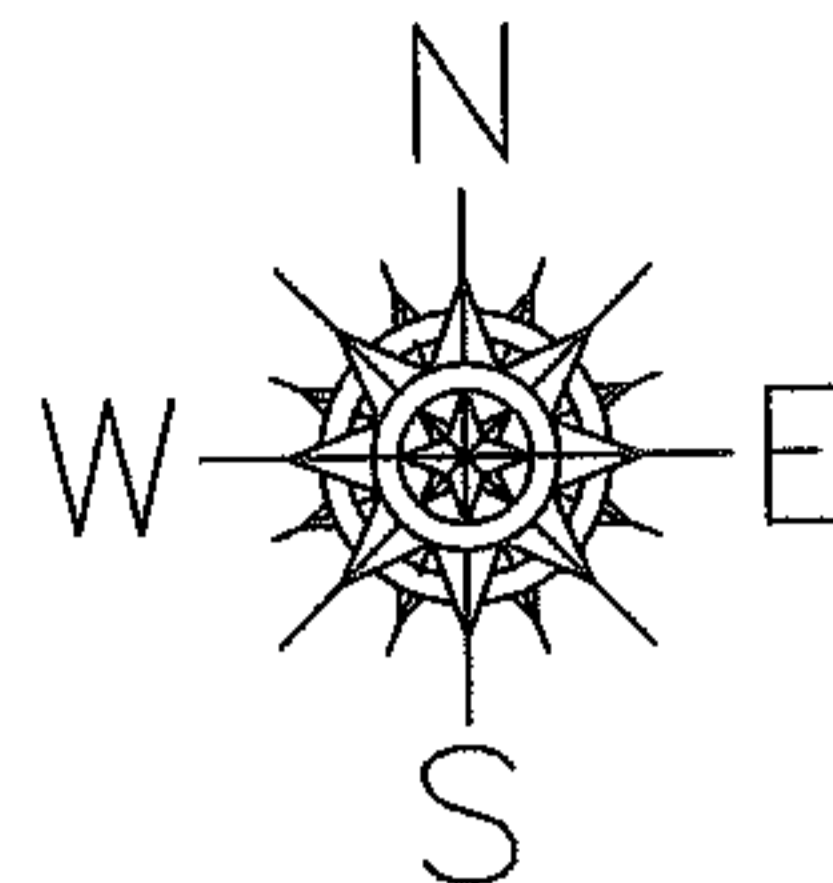

SPLITS/DEEDS PROCESSED

LORAIN COUNTY TAX MAP DEPARTMENT
226 MIDDLE AVE. ELYRIA, OHIO

SURVEYED BY: RICHARD D CARLSON

CLOSURE: 1:10,000

MAP PAGE(S): 15-00-020-B

APPROVED BY: DRH DATE: 10/4/2007

SCALE: 1" = 100 PRIOR INSTRUMENT: DV 1293/622