

PARENT PARCEL: 08-00-087-000-016, 08-00-090-000-041


07-01544-C

CHILD PARCEL:

STARTING POINT: MON BOX AT INT. CL OF RUSSIA RD WITH CL BAUMHART RD

MILAN ELYRIA RD 66'

BAUMHART RD

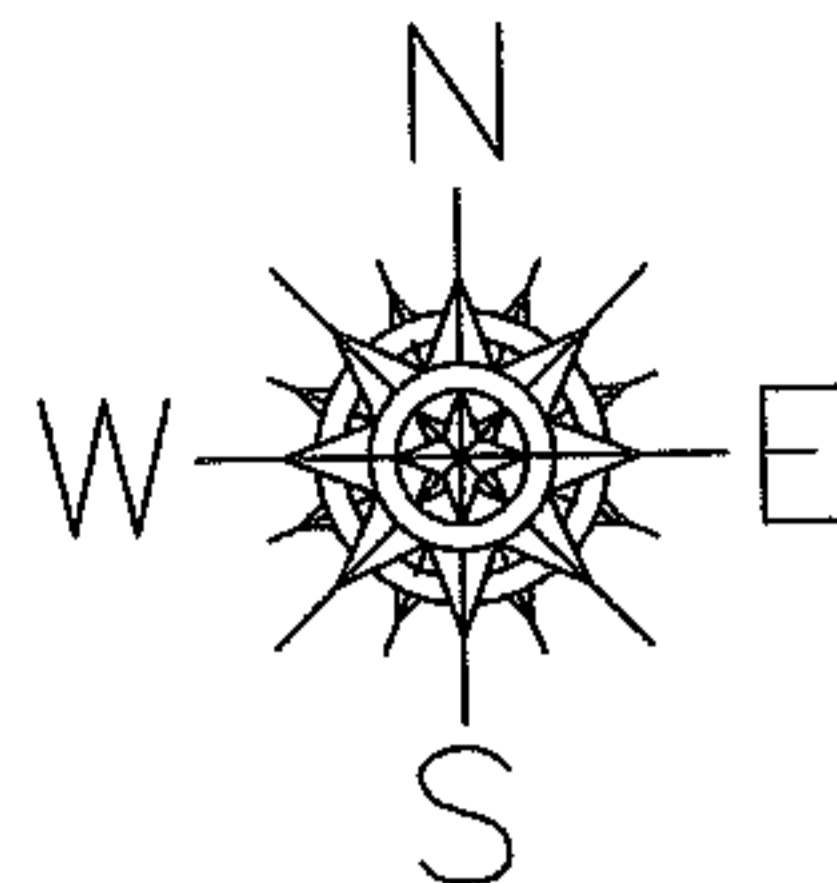

-016

~~12.77~~ A.

16.04 A.

AC. CORR PER SURVEY CHARLES P. WARYU

O.L. 87

O.L. 88

O.L. 90

O.L. 89

-041

~~33.97~~ A.

29.59 A.

RD

923.34

-040
7.87 A.

375.00

125

537.23

60'

561.20

RUSSIA RD 60'

RD 60'


SURVEYED BY: CHARLES P. WARYU

CLOSURE: 1:33000

MAP PAGE(S): 8-D

APPROVED BY: DRH DATE: 10/10/2007

SCALE: 1" = 400 PRIOR INSTRUMENT: 1143/426

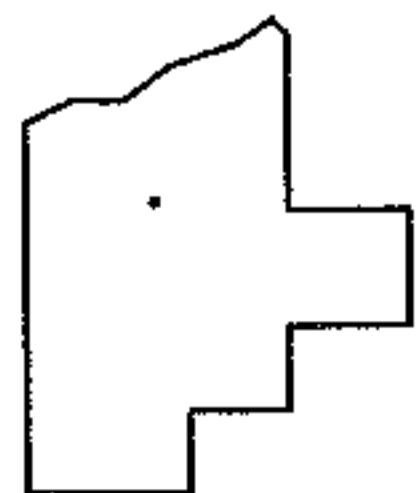

SPLITS/DEEDS PROCESSED
LORAIN COUNTY TAX MAP DEPARTMENT
226 MIDDLE AVE. ELYRIA, OHIO