




PARENT PARCEL: 10-00-008-101-012, -013

07-01547-C

CHILD PARCEL: --SAME--

STARTING POINT:

AC. CORR. PER DEED

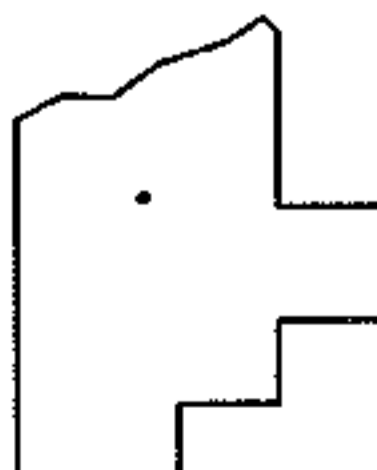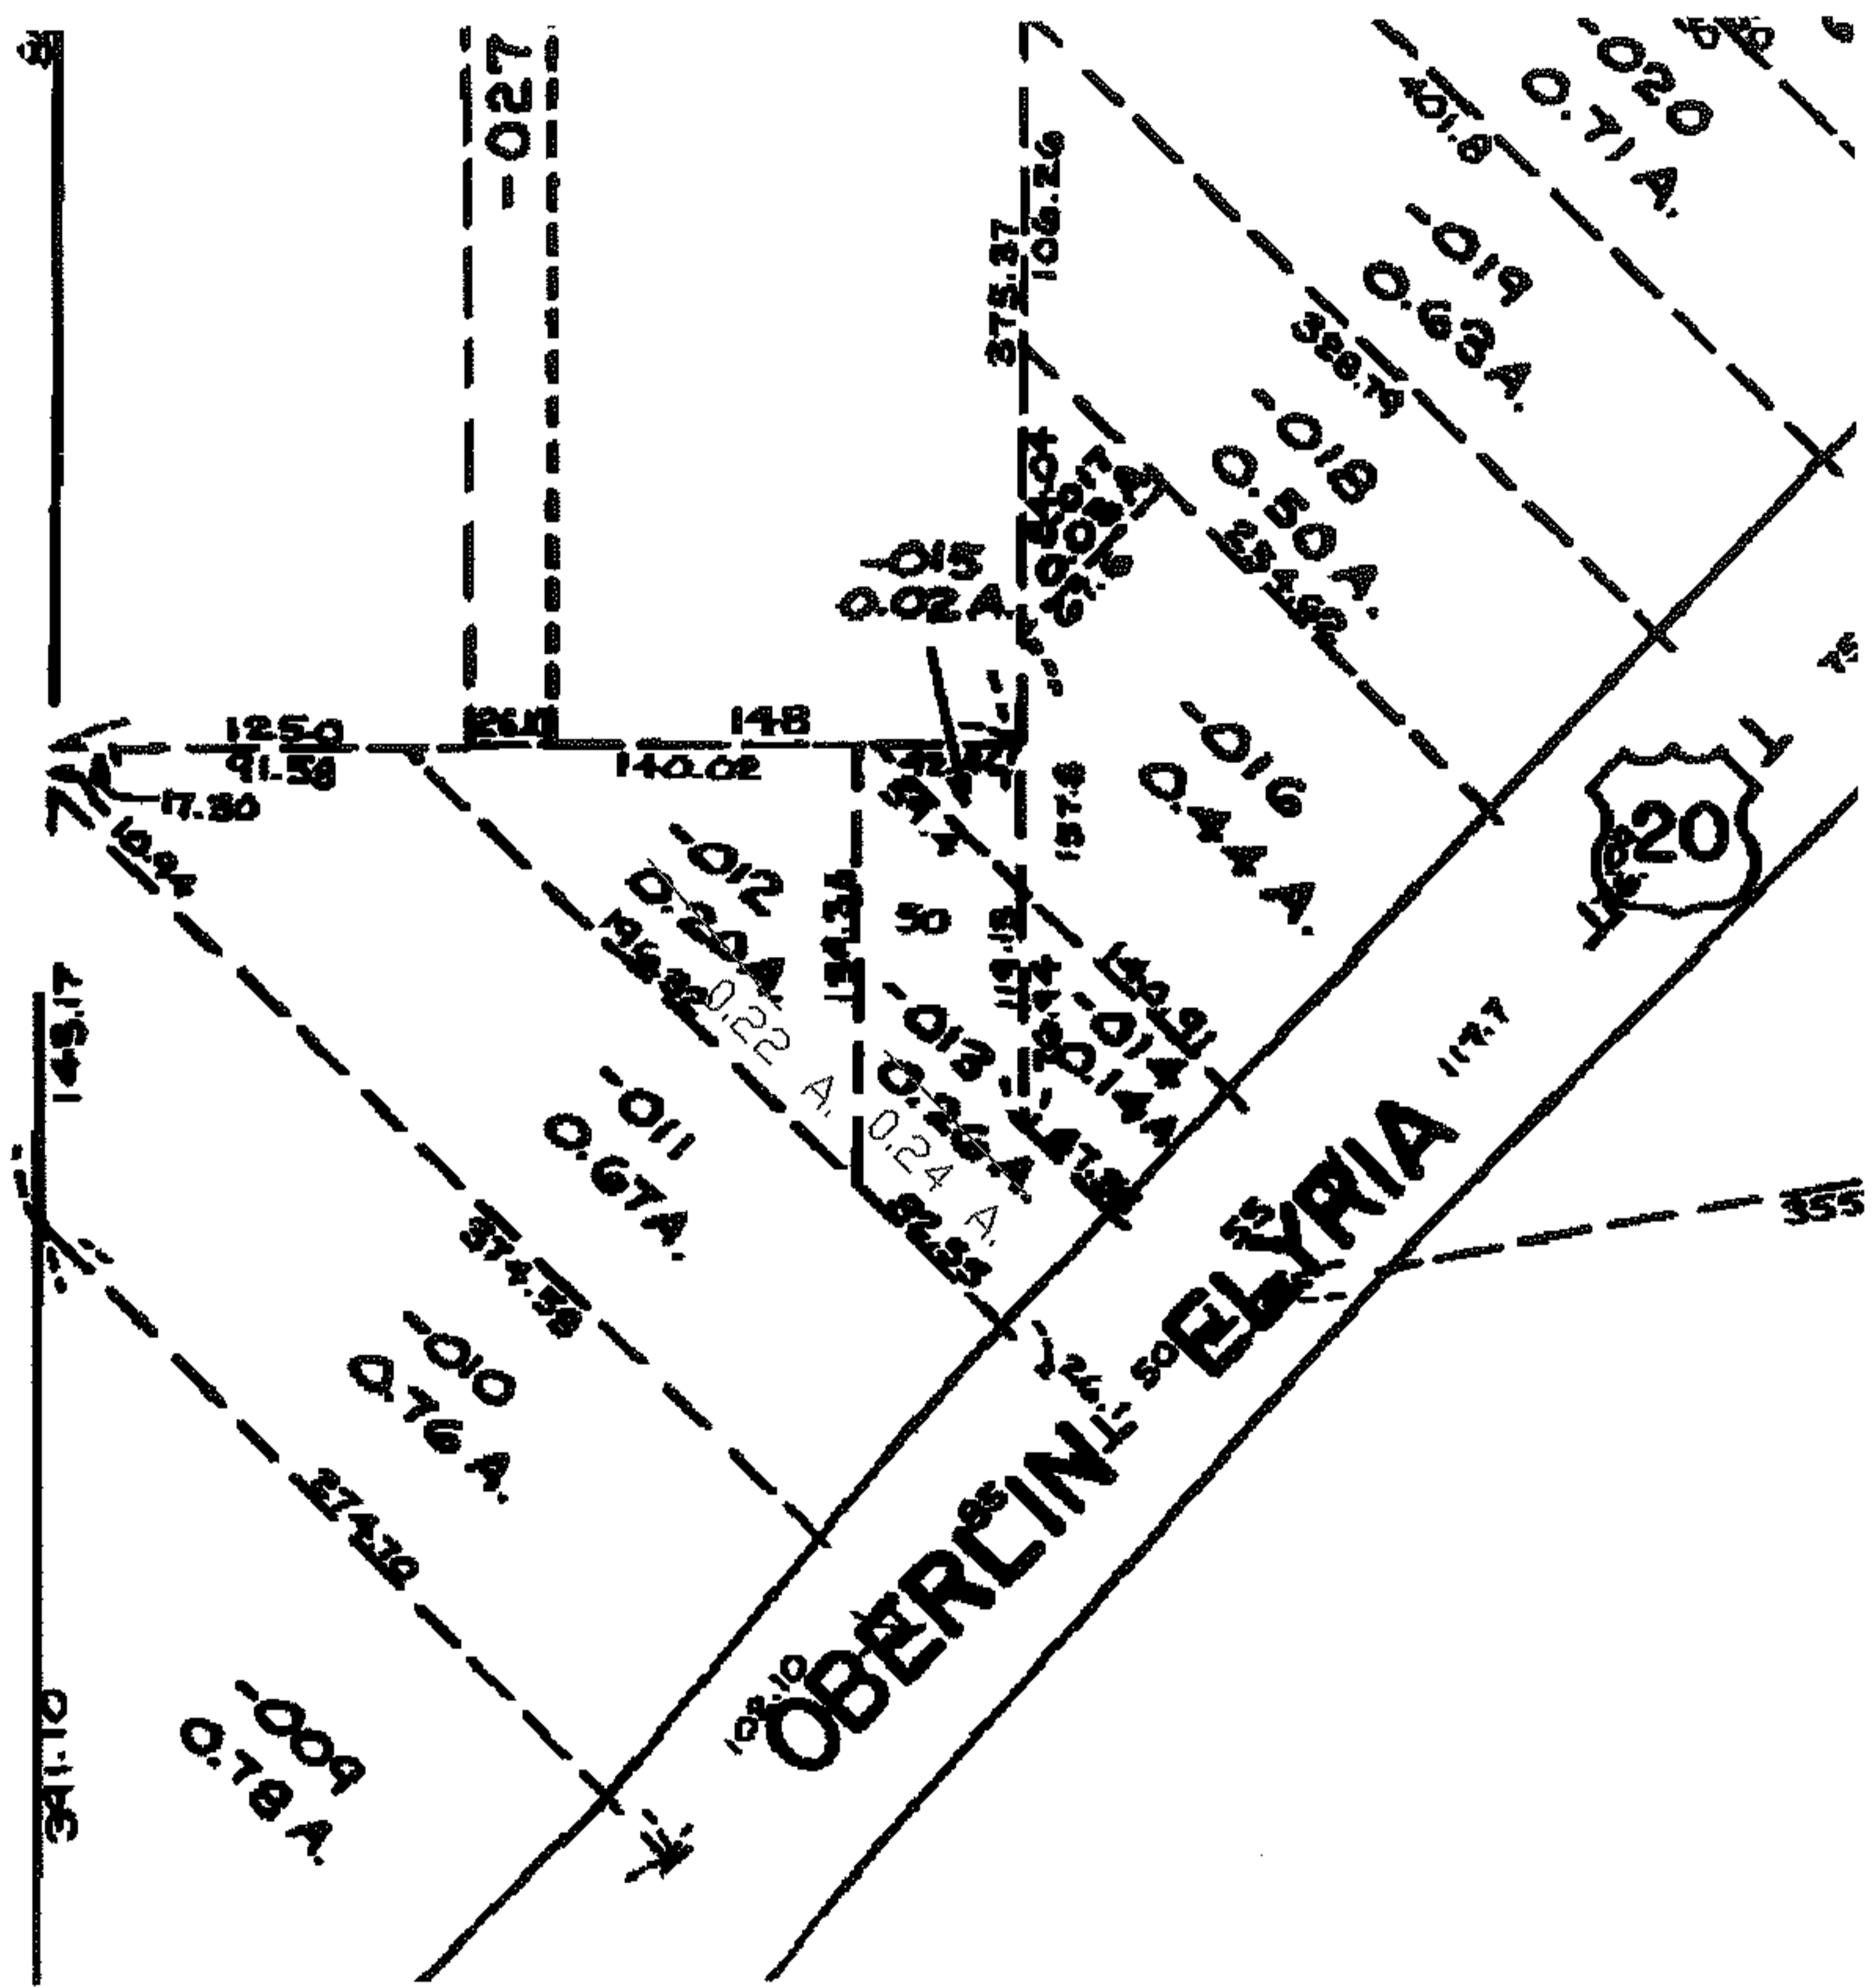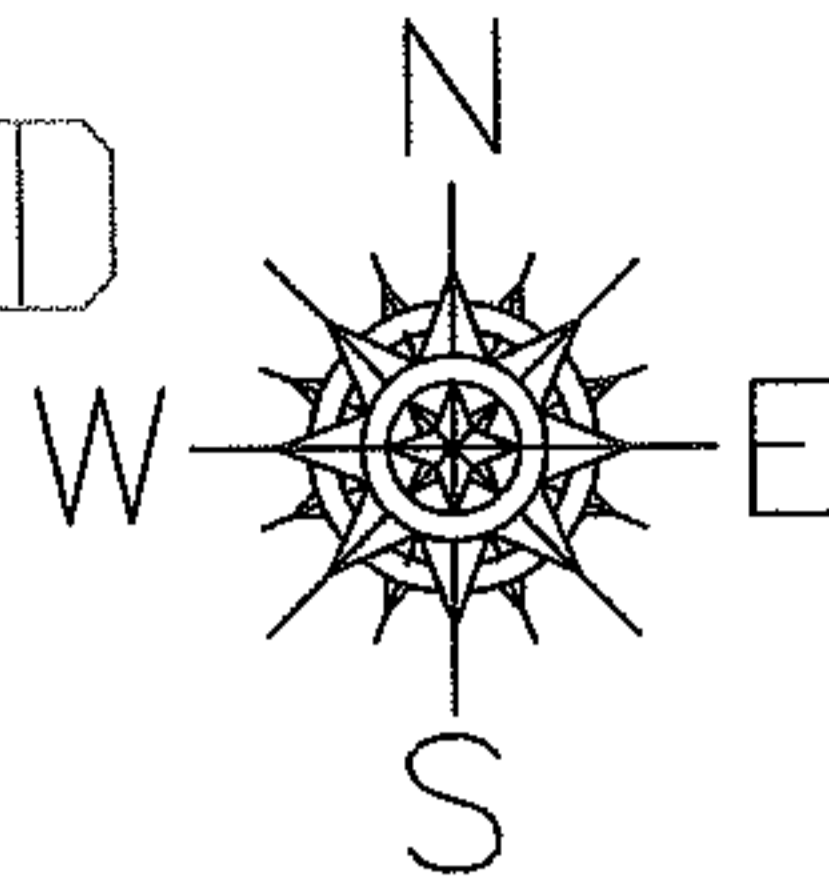

SPLITS/DEEDS PROCESSED

LORAIN COUNTY TAX MAP DEPARTMENT
226 MIDDLE AVE. ELYRIA, OHIO

SURVEYED BY: N/A
CLOSURE: N/A
MAP PAGE(S): 10-00-008-A
APPROVED BY: DRH DATE: 10/11/2007
SCALE: NOT TO SCALE PRIOR INSTRUMENT: 186/721