


PARENT PARCEL: 04-00-029-000-085 & -094

CHILD PARCEL: 04-00-029-000-782

STARTING POINT: MON BOX INT CL WALKER RD AND LEAR NAGLE RD

NO. 01553-C

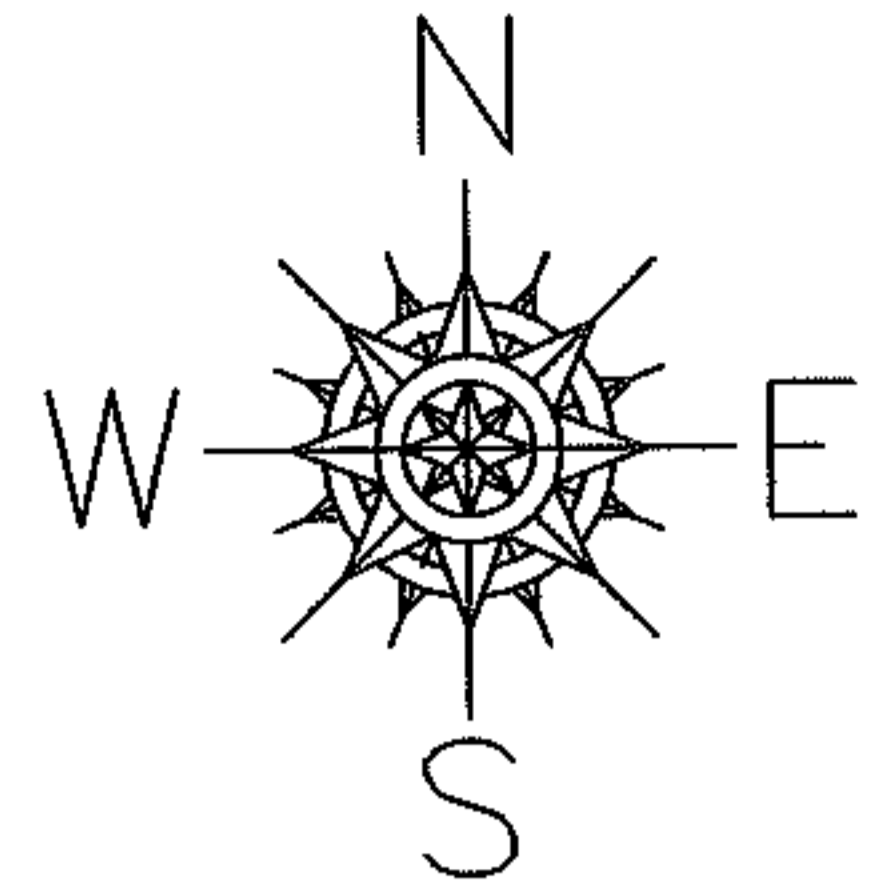

LEAR NAGLE RD

2289.50

WALKER RD

125

50

36.68

862

~~094~~

~~0.85 A.~~

~~0.25 A.~~


862

-782

~~1.10 A.~~

1.16 A.

161.68

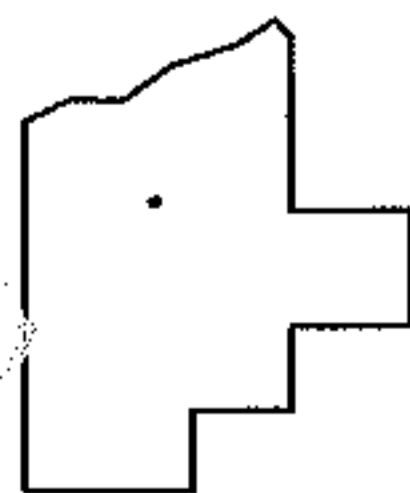

SPLITS/DEEDS PROCESSED

LORAIN COUNTY TAX MAP DEPARTMENT
226 MIDDLE AVE. ELYRIA, OHIO

SURVEYED BY: MICHAEL STRAUB

CLOSURE: 1:10,000

MAP PAGE(S): 04-00-029-B

APPROVED BY: DRH DATE: 5/20/2005

SCALE: 1" = 100 PRIOR INSTRUMENT: 20050068545