

RASTER




PARENT PARCEL: 06-25-163-000-021, -022, -023

07-01555-D

CHILD PARCEL: --SAME--

STARTING POINT: S.L. 522, 523, 524 SPRING VALLEY SUB. NO 5

DEPTH CORR. PER MAP  
MAP CORR PER DEED

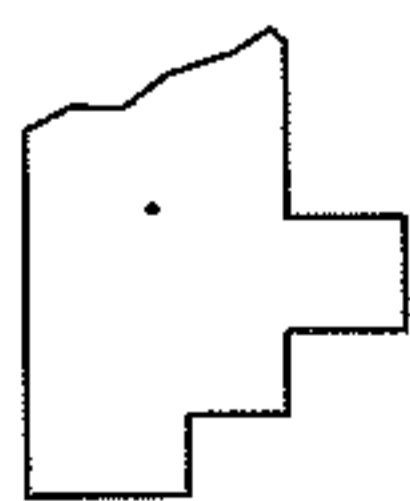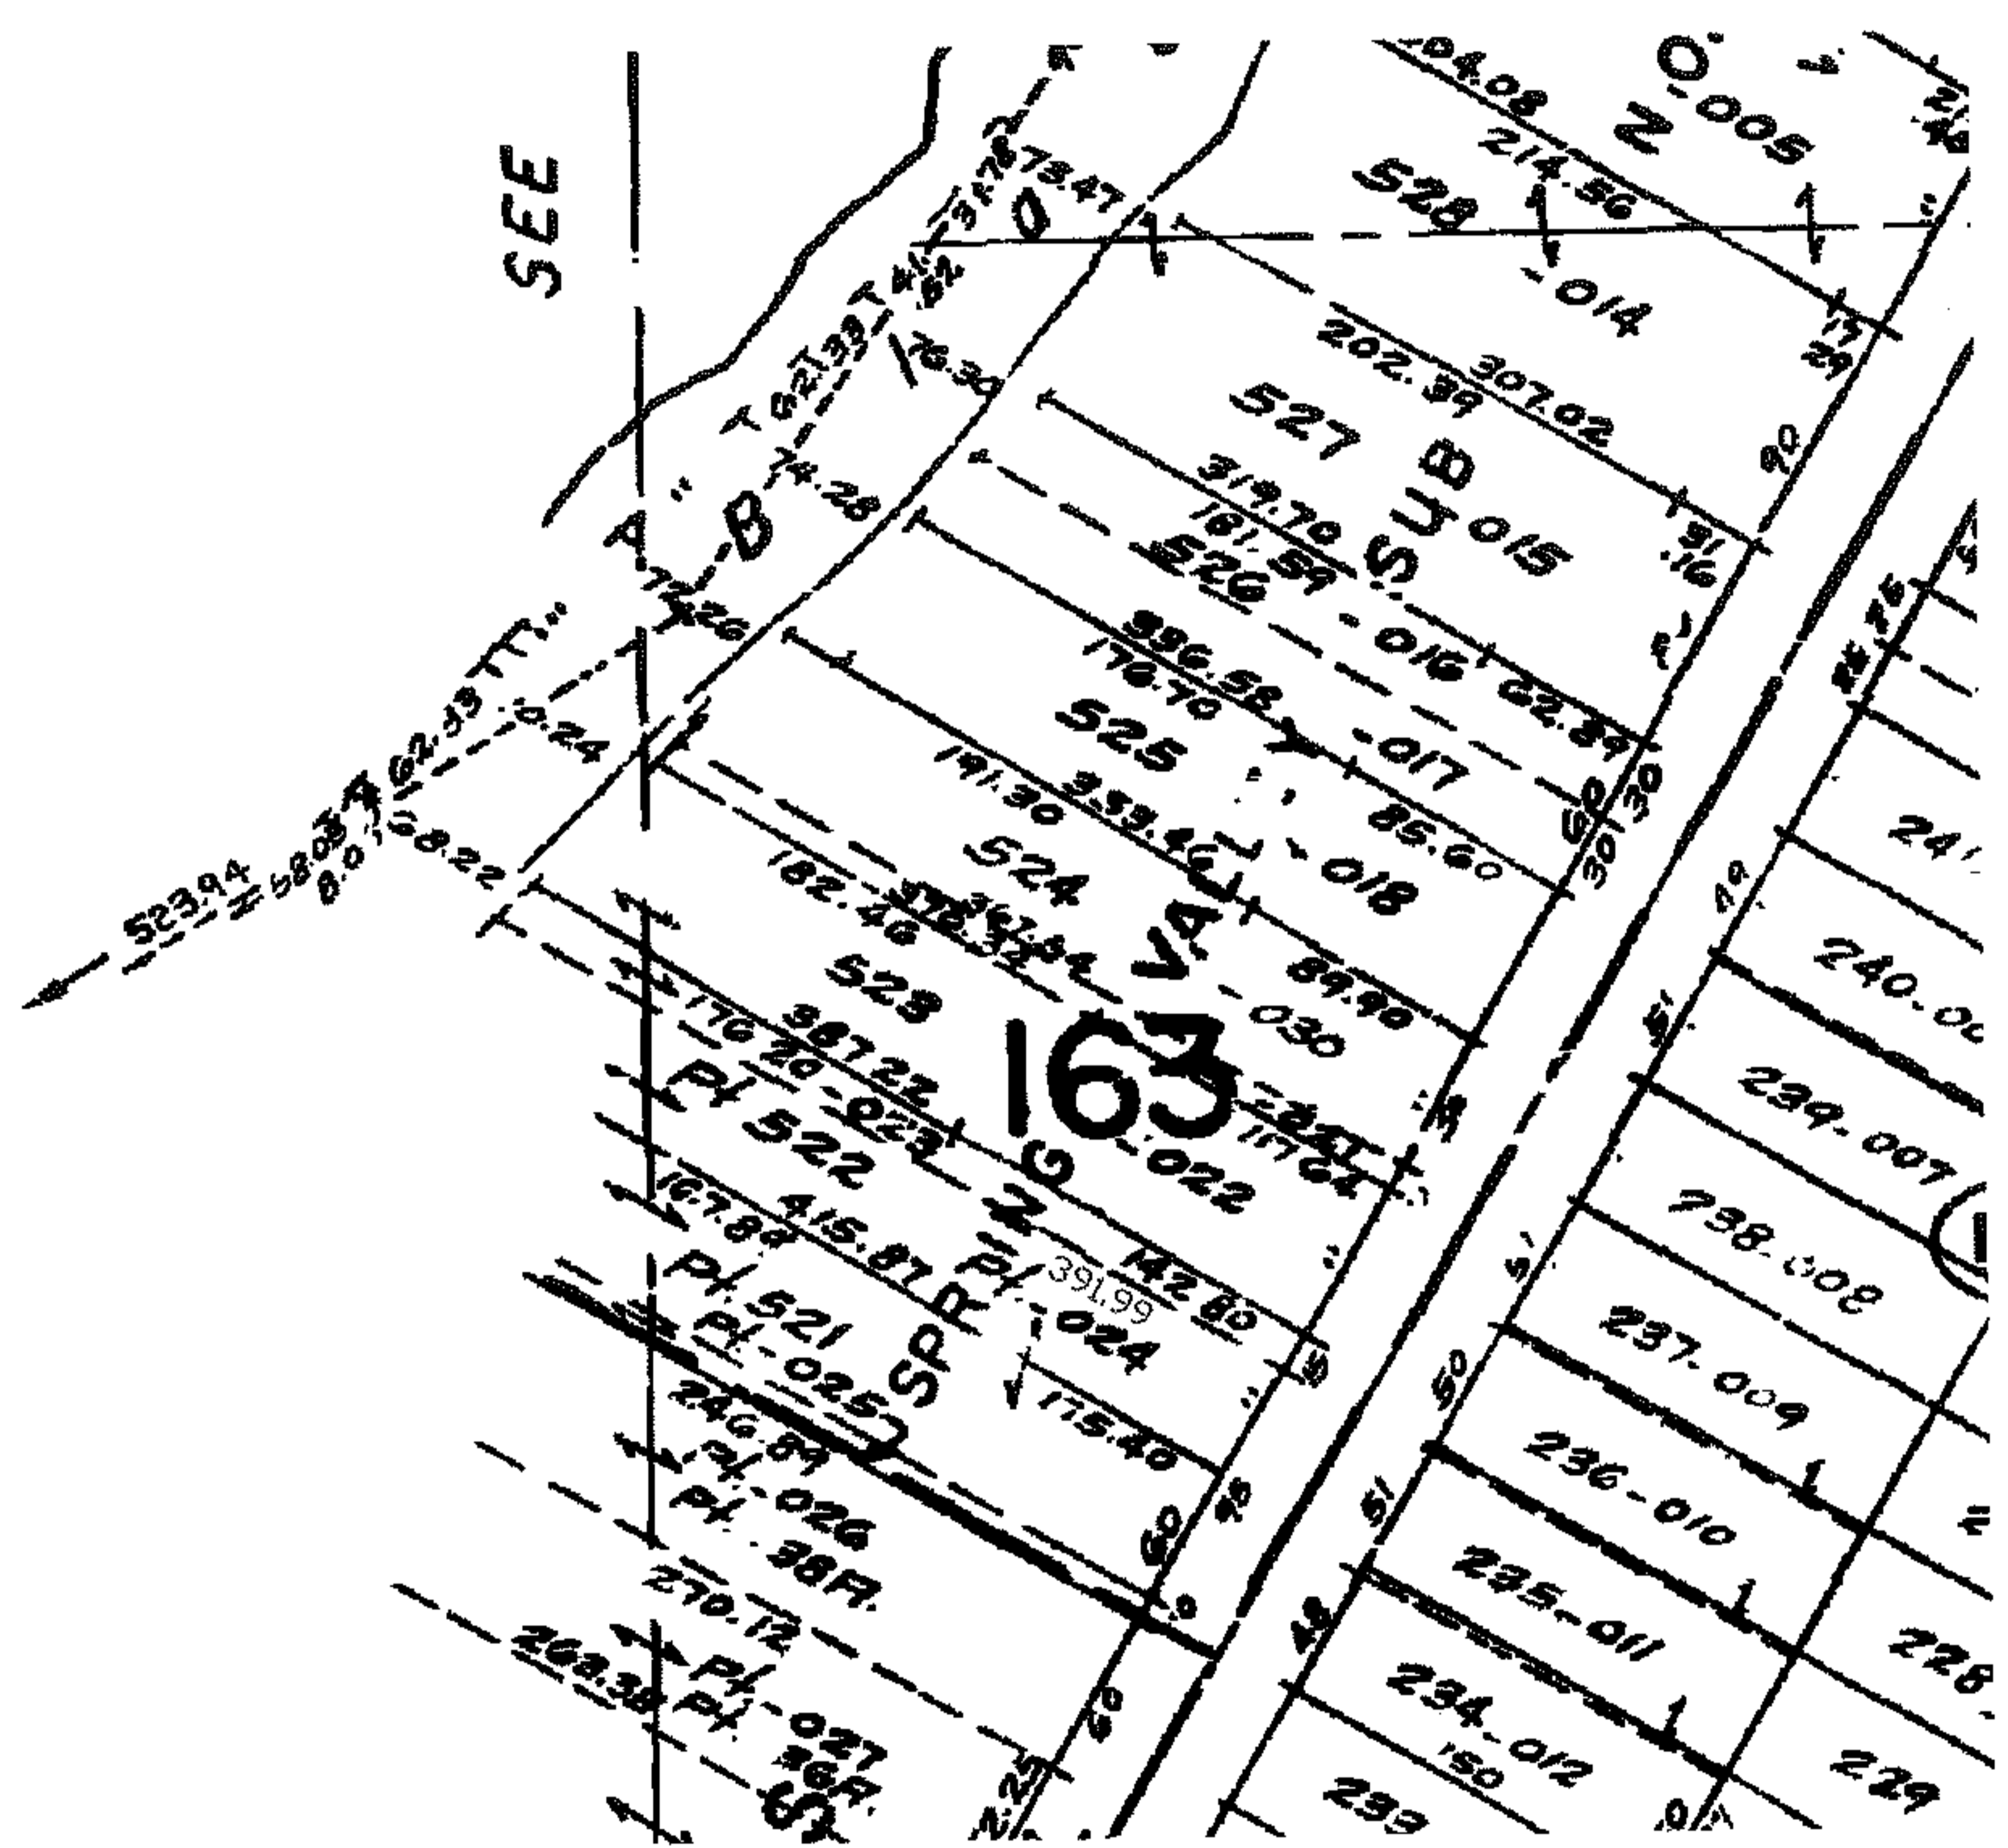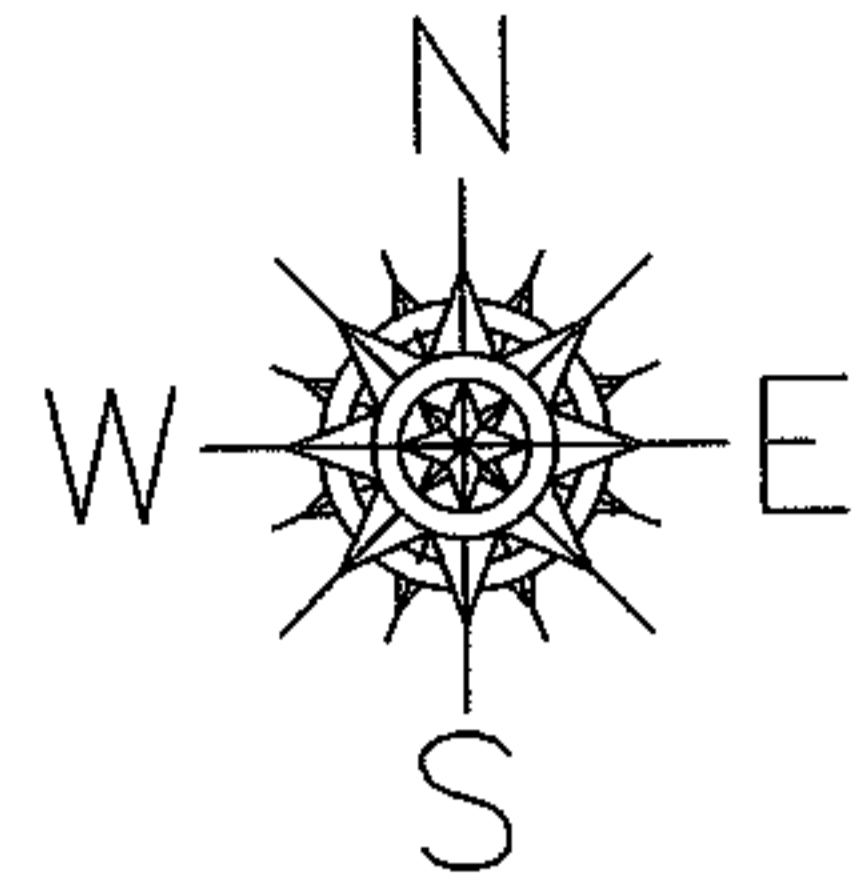

SPLITS/DEEDS PROCESSED  
LORAIN COUNTY TAX MAP DEPARTMENT  
226 MIDDLE AVE. ELYRIA, OHIO

SURVEYED BY: N/A  
CLOSURE: N/A  
MAP PAGE(S): 06-68  
APPROVED BY: DRH DATE: 11/7/2007  
SCALE: NOT TO SCALE. PRIOR INSTRUMENT: 20010755469