

Raster




PARENT PARCEL: 04-00-002-102-056

CHILD PARCEL: --SAME--

STARTING POINT: MON BOX INT CL CASE RD AND MOON RD

07-01557-C

AC. CORR.
PER SURVEY
SUSAN L EICHHORN

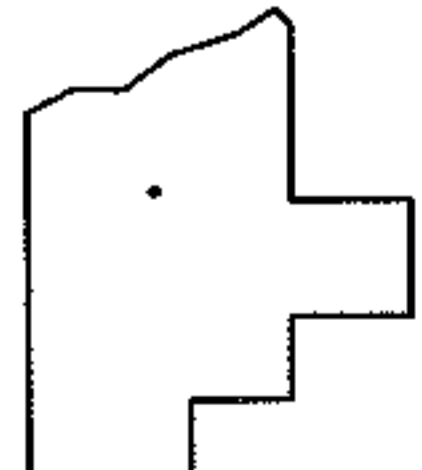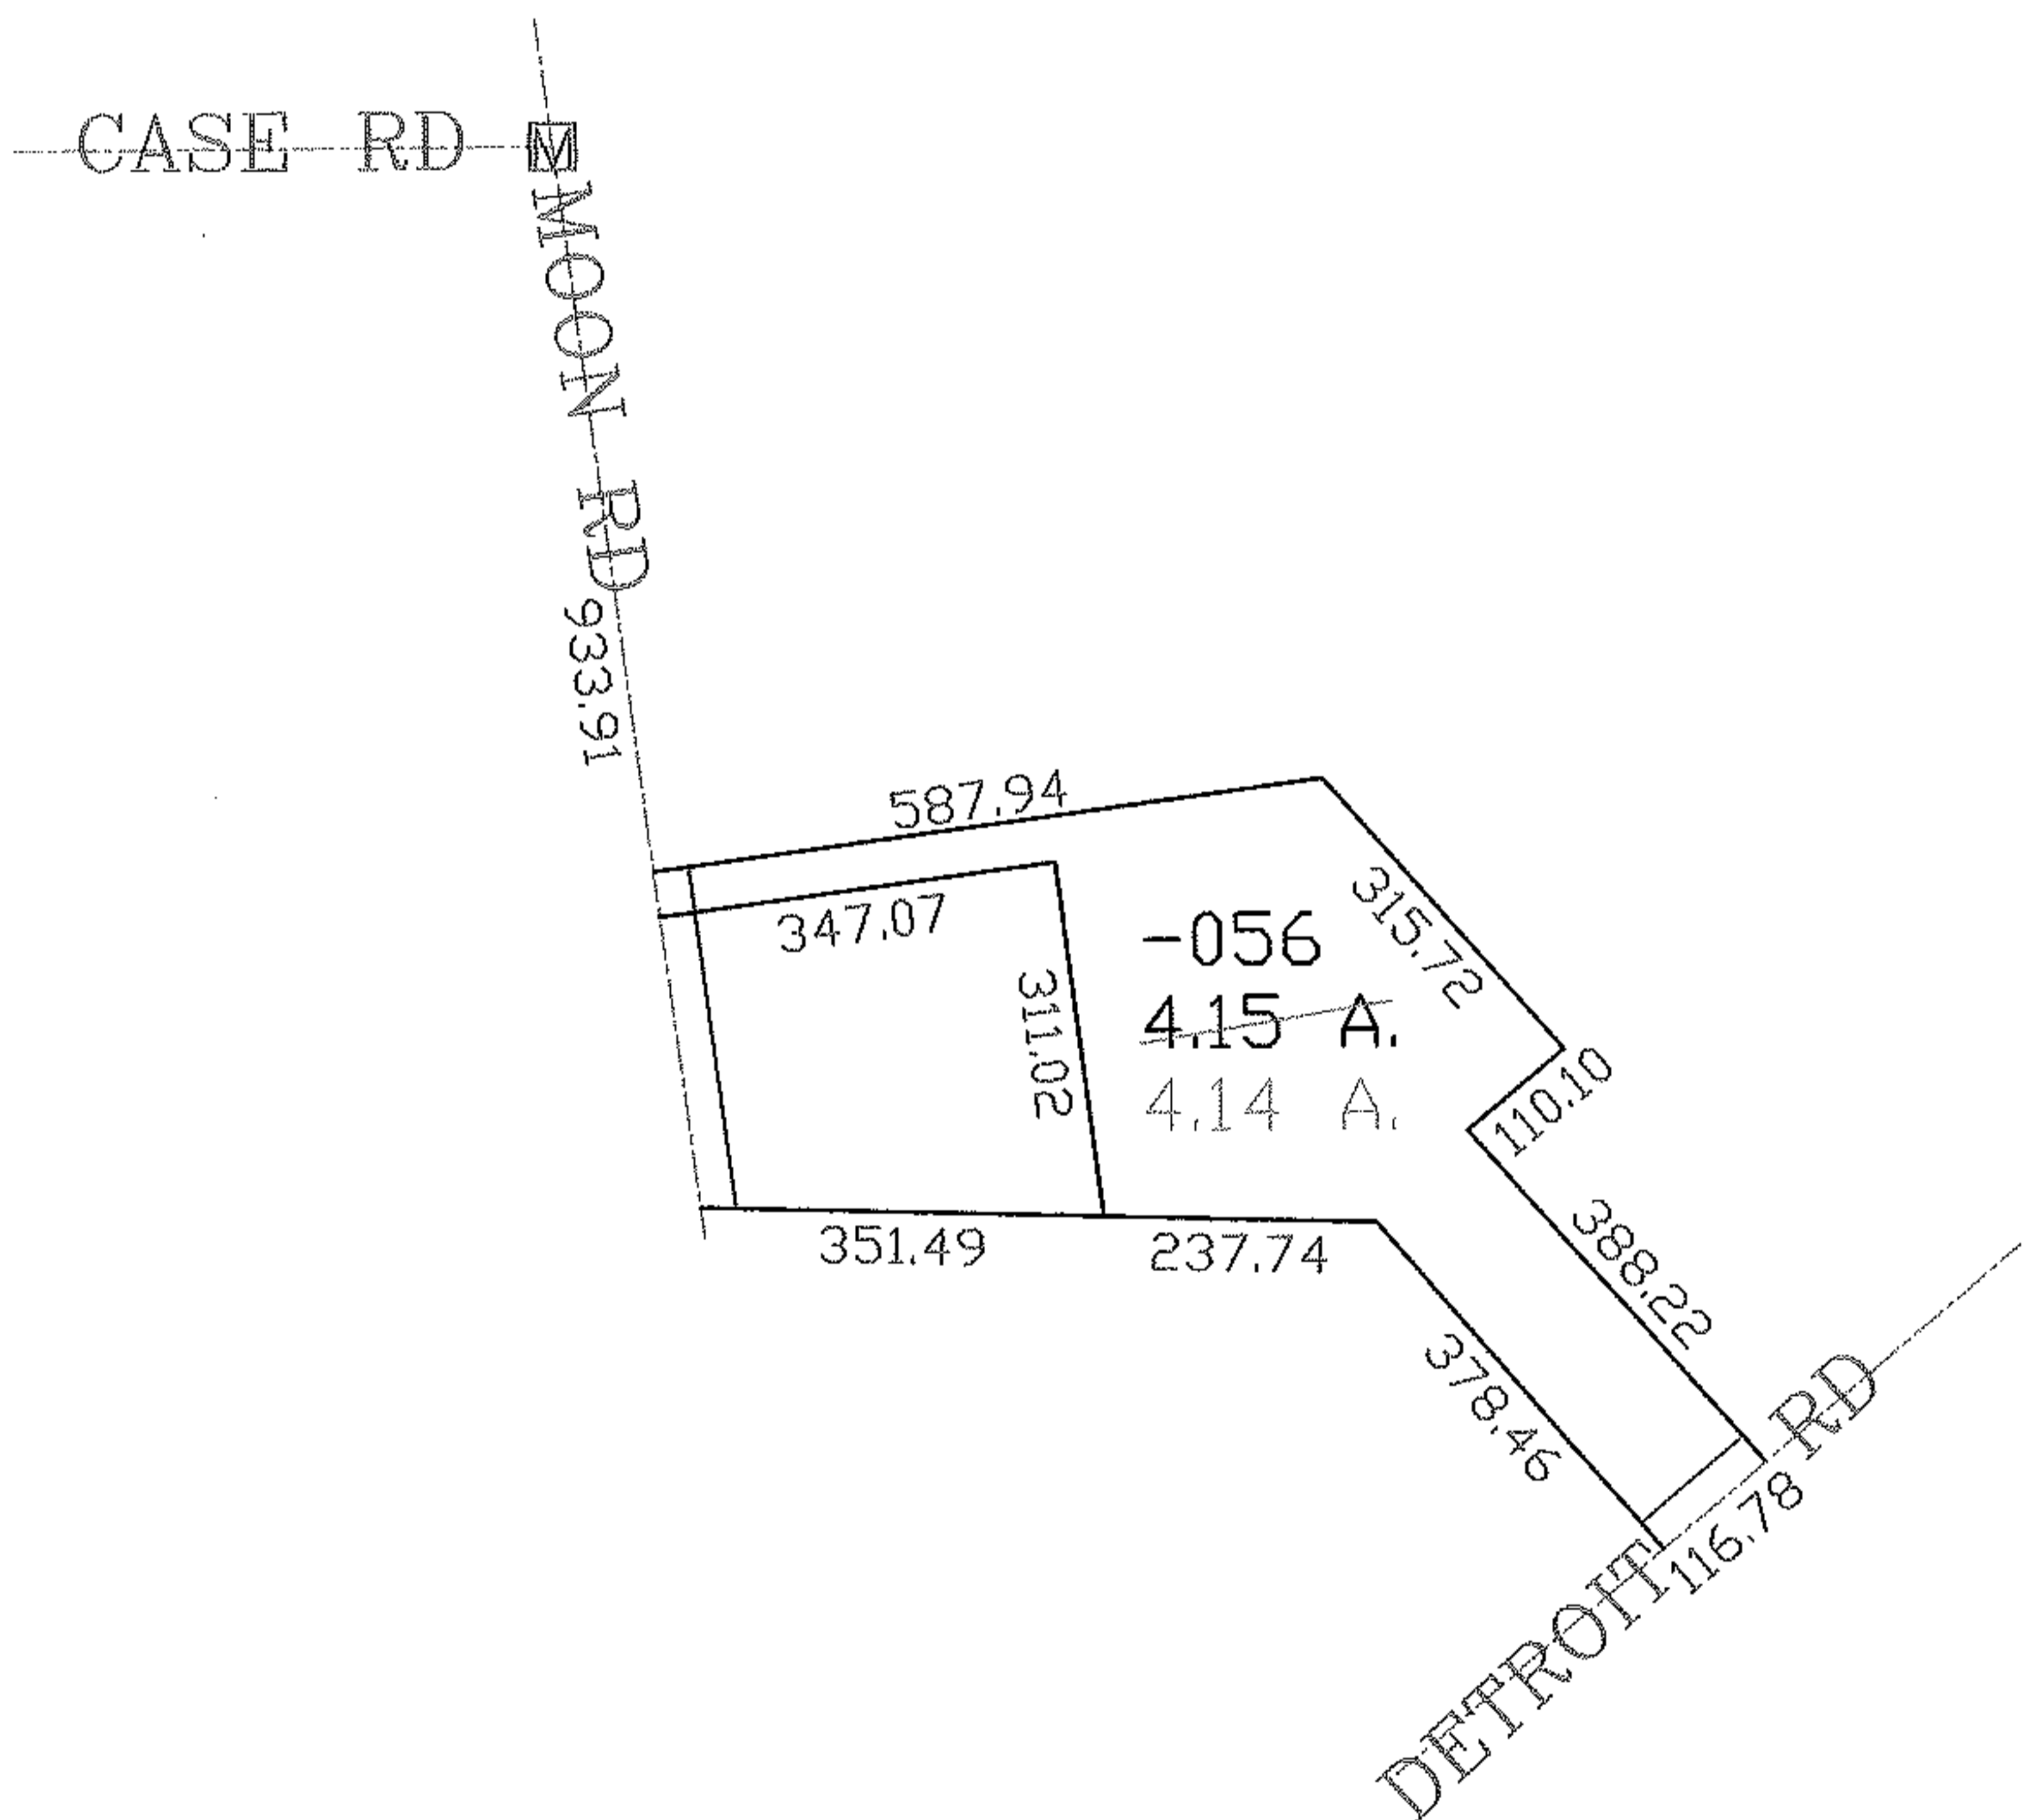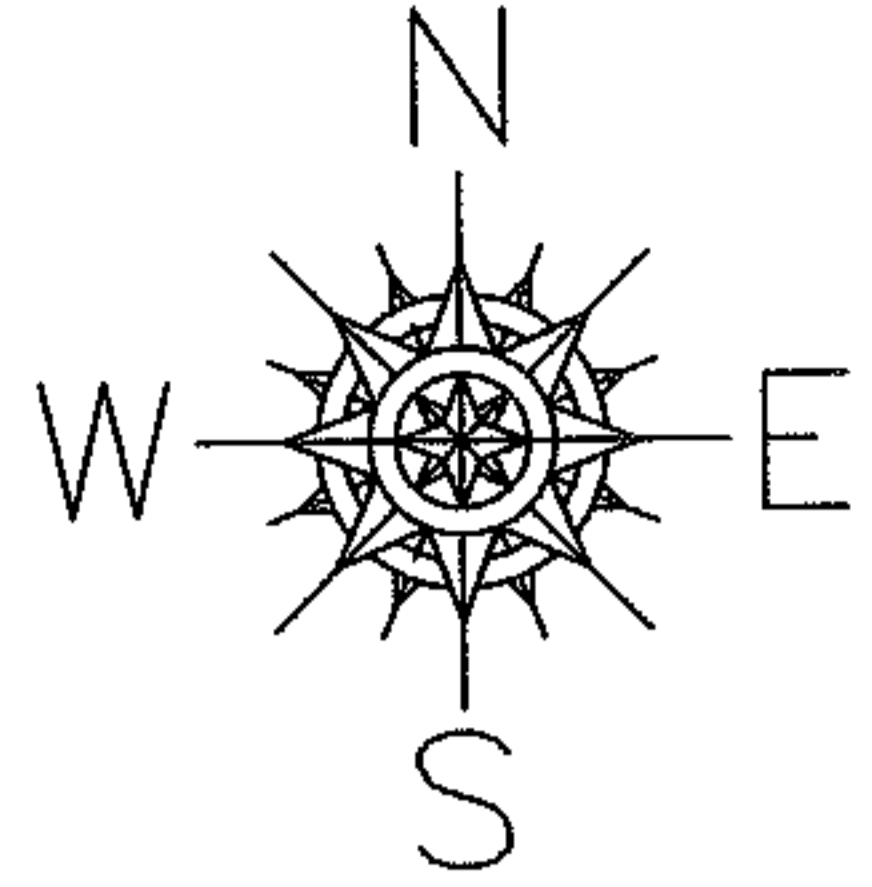

SPLITS/DEEDS PROCESSED
LORAIN COUNTY TAX MAP DEPARTMENT
226 MIDDLE AVE. ELYRIA, OHIO

SURVEYED BY: SUSAN L. EICHHORN
CLOSURE: 1:10,000
MAP PAGE(S): 04-00-002-G
APPROVED BY: DRH DATE: 11/8/2007
SCALE: 1" = 300 PRIOR INSTRUMENT: DV 876/317