

MASTER


PARENT PARCEL: 05-00-039-109-001

CHILD PARCEL: --SAME--

STARTING POINT: INT CL S.R. 58 AND NORTH RIDGE RD

07-01568-C

AC. CORR.  
PER SURVEY  
DALE HAYWOOD

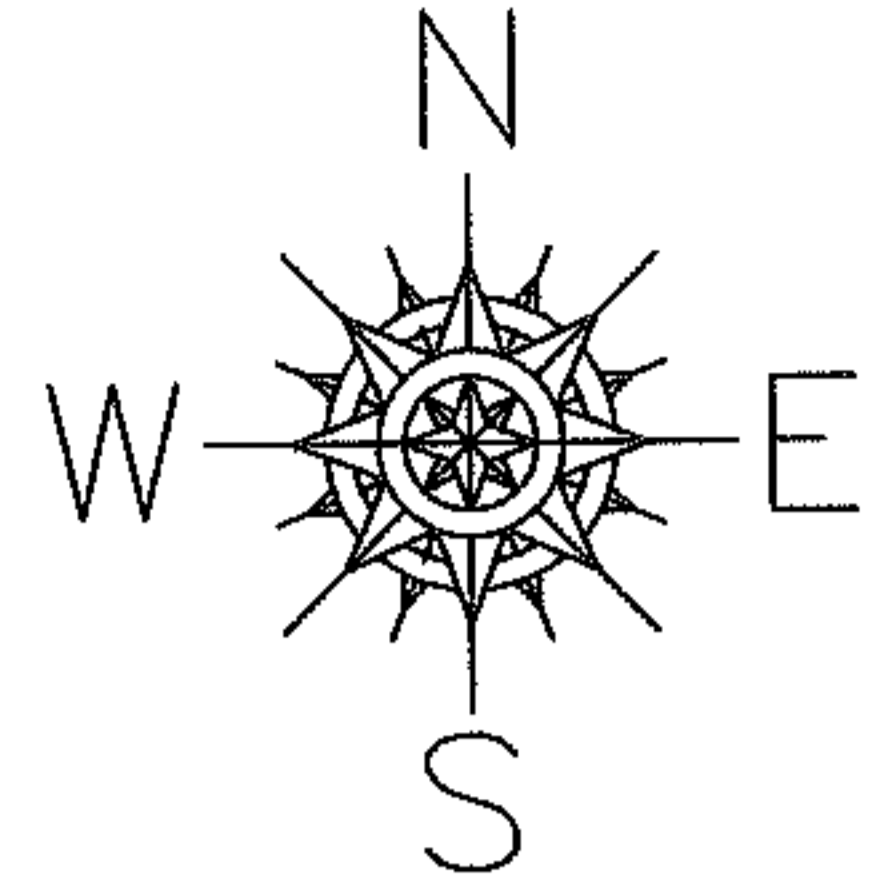

NORTH RIDGE RD  
300.00

223.98

172.38

-001

~~0.88~~ A.


0.86 A.

200  
300  
200

M  
S  
R.  
S

128.90

O.L. 39  
O.L. 38

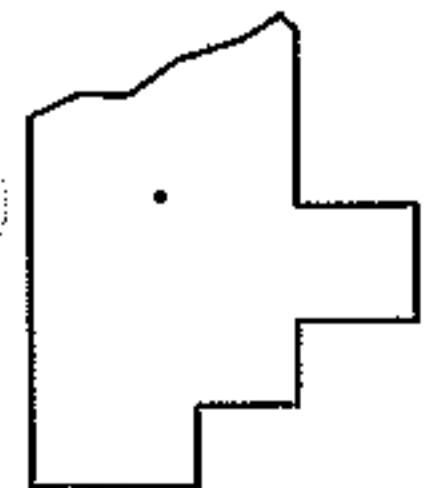

SPLITS/DEEDS PROCESSED

LORAIN COUNTY TAX MAP DEPARTMENT  
226 MIDDLE AVE. ELYRIA, OHIO

SURVEYED BY: DALE HAYWOOD

CLOSURE: 1:10,000

MAP PAGE(S): 05-00-039-B

APPROVED BY: DRH DATE: 11/20/2007

SCALE: 1" = 100' PRIOR INSTRUMENT: 20000689864