

RASTER






PARENT PARCEL: 10-00-005-102-015

07-01578-C

CHILD PARCEL: --SAME--

STARTING POINT: INT CL DEFIANCE AND CHESTNUT RIDGE RD

# MAP CORR

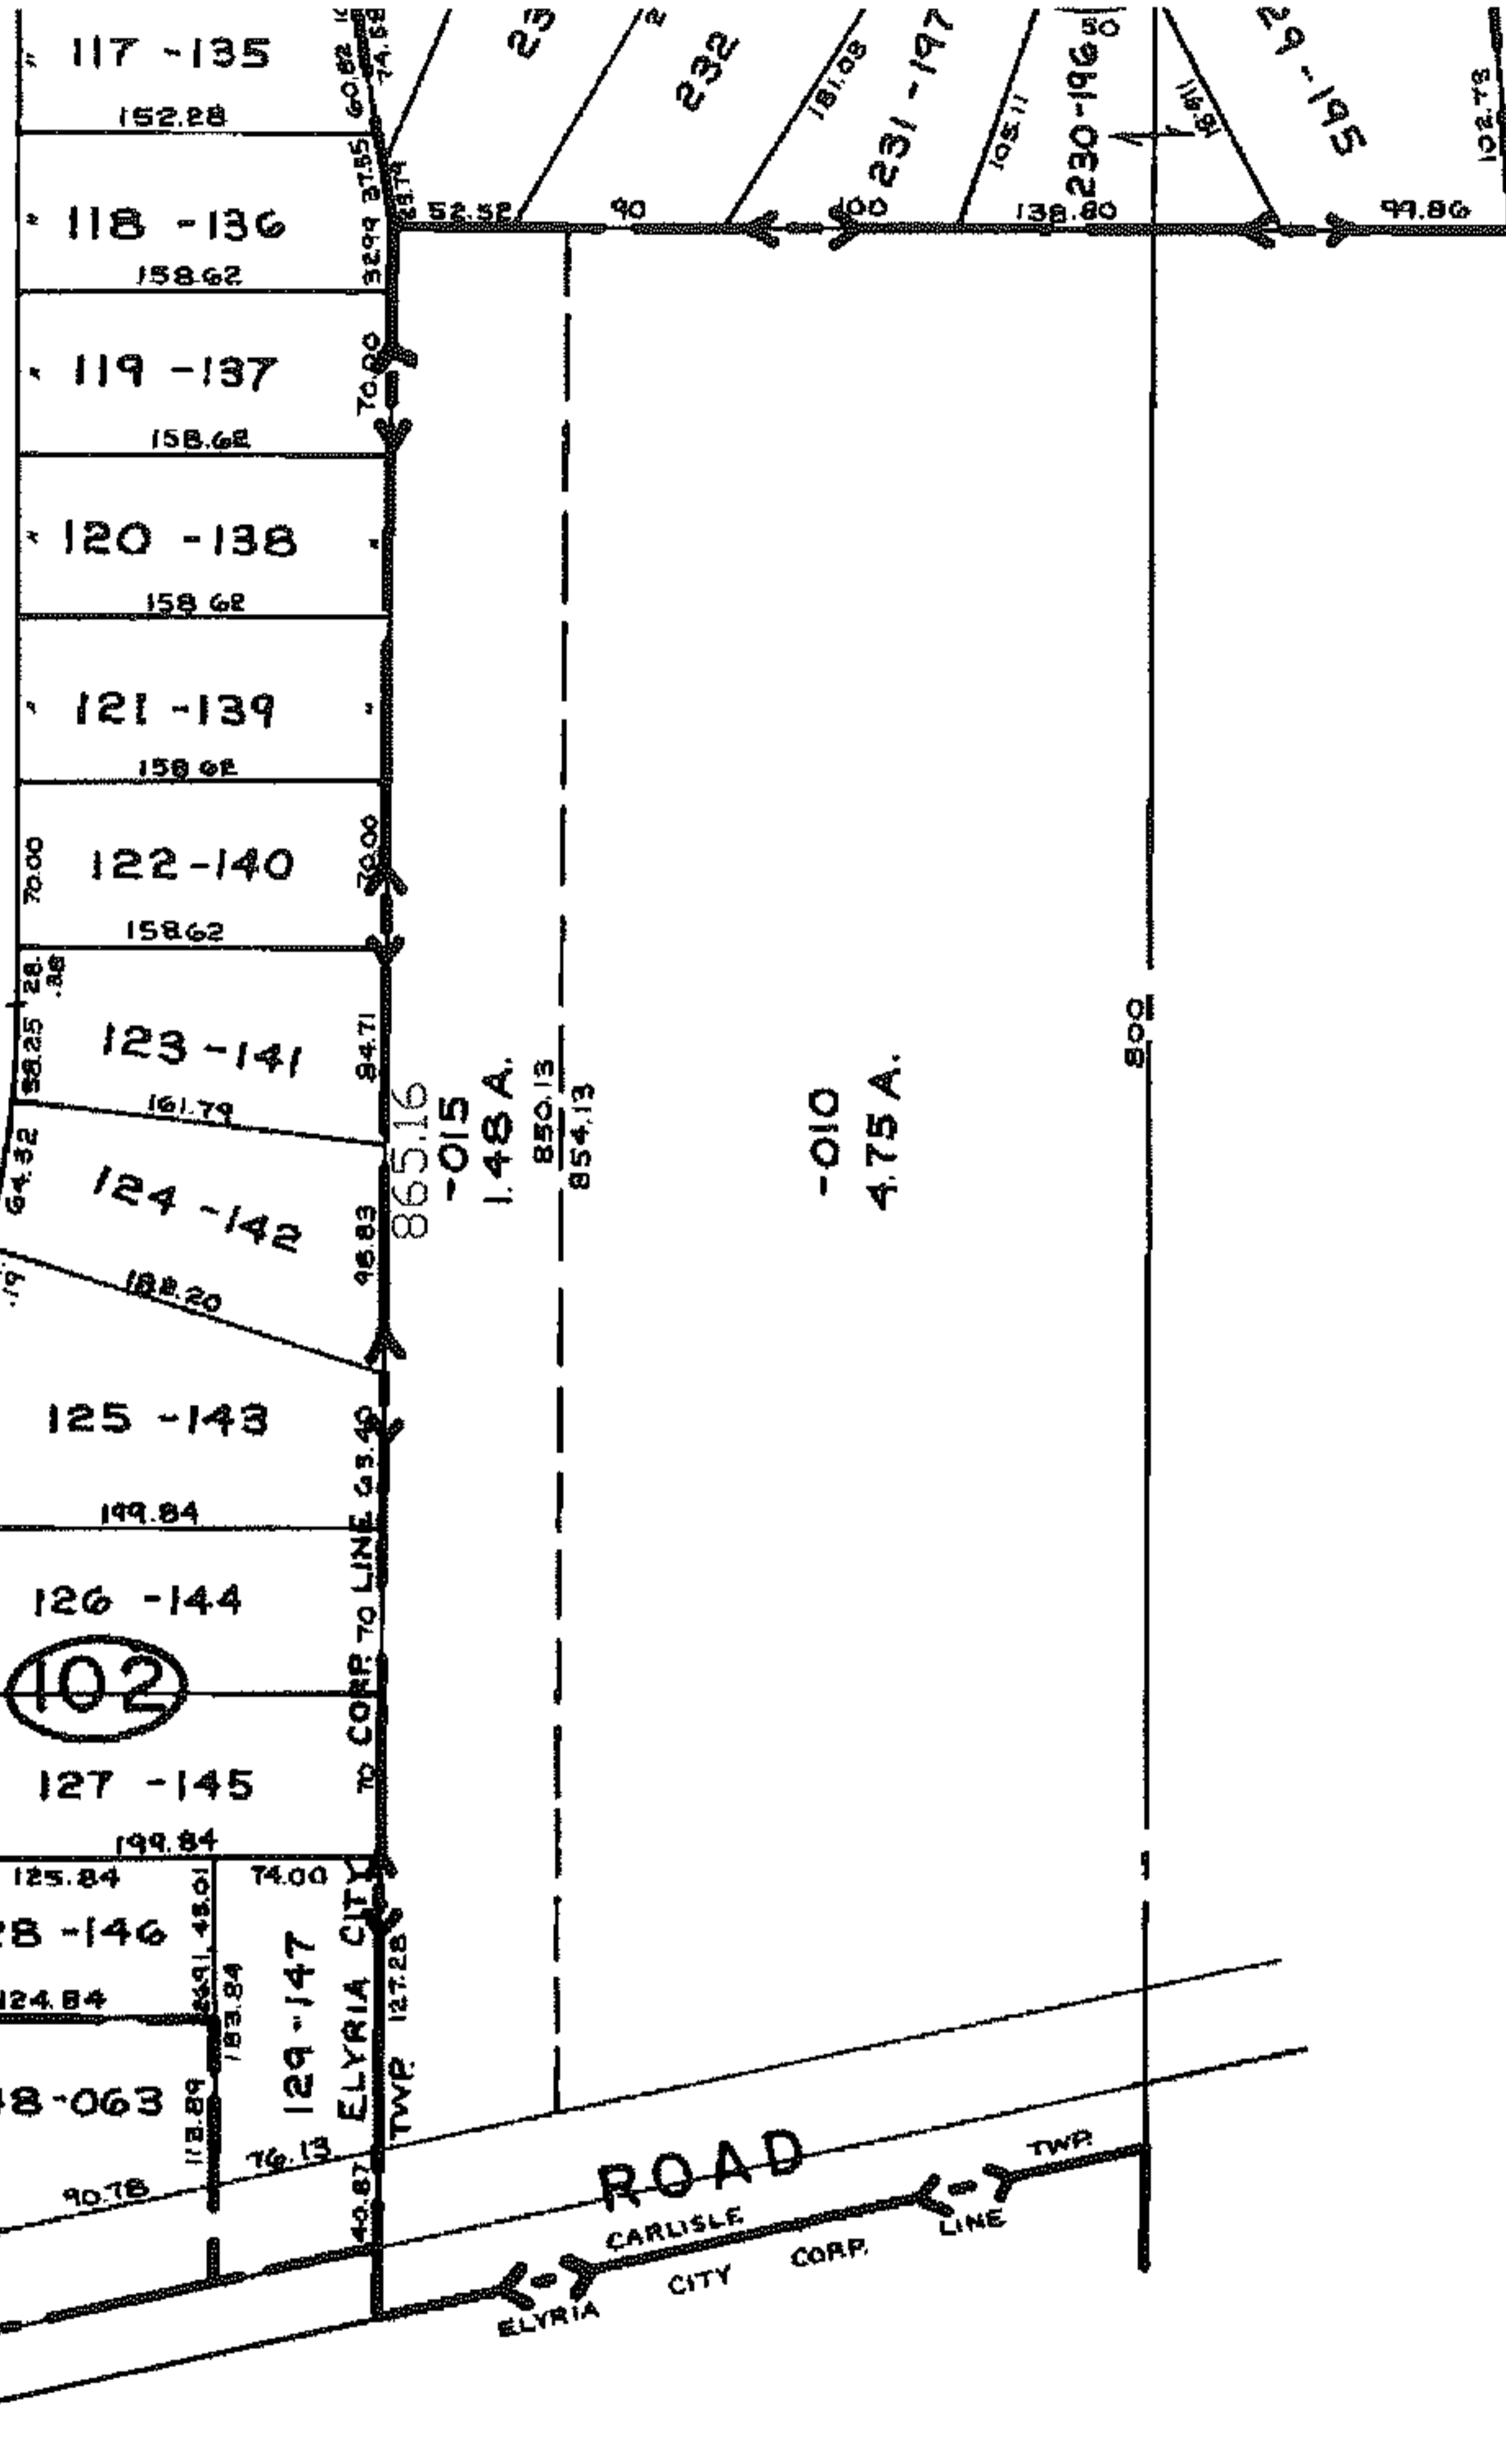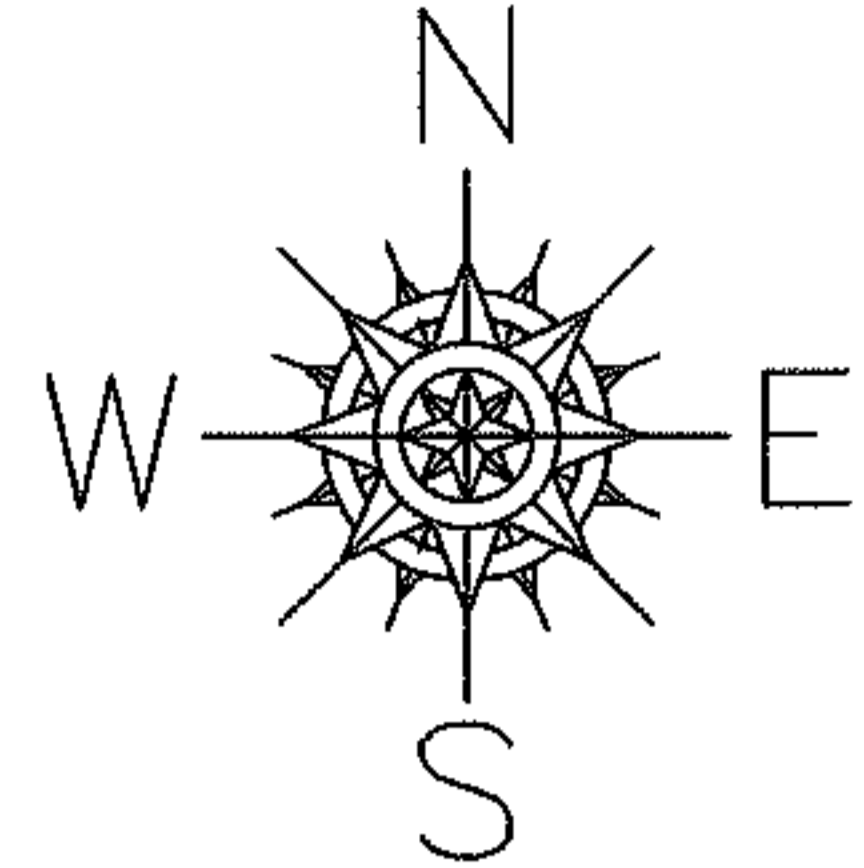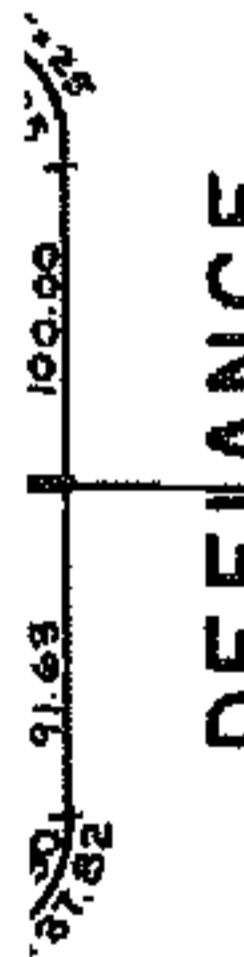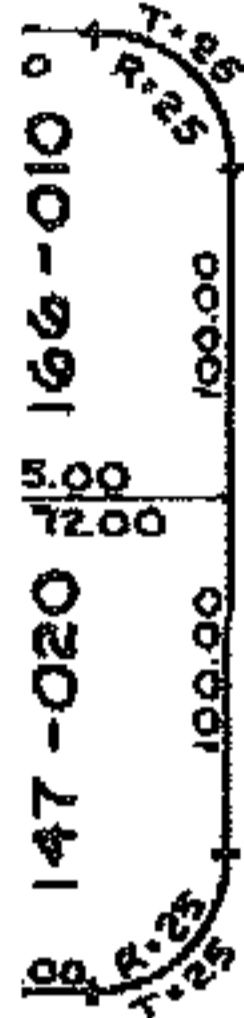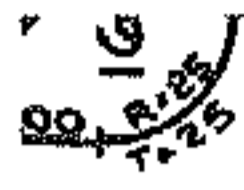

DEFIANCE

ROAD

## SPLITS/DEEDS PROCESSED

LORAIN COUNTY TAX MAP DEPARTMENT  
226 MIDDLE AVE. ELYRIA, OHIO

SURVEYED BY: N/A  
CLOSURE: N/A  
MAP PAGE(S): 10-00-005-D  
APPROVED BY: DRH DATE: 1/24/2008  
SCALE: 1" = 100' PRIOR INSTRUMENT: DV 959/938