

RASTER

PARENT PARCEL: 11-00-009-101-028



CHILD PARCEL: --SAME--

STARTING POINT: INTN CL HAWKE RD AND BROKAW RD

07-01579-C

MAP CORR ONLY PER DEED

SEE II-00-010-B

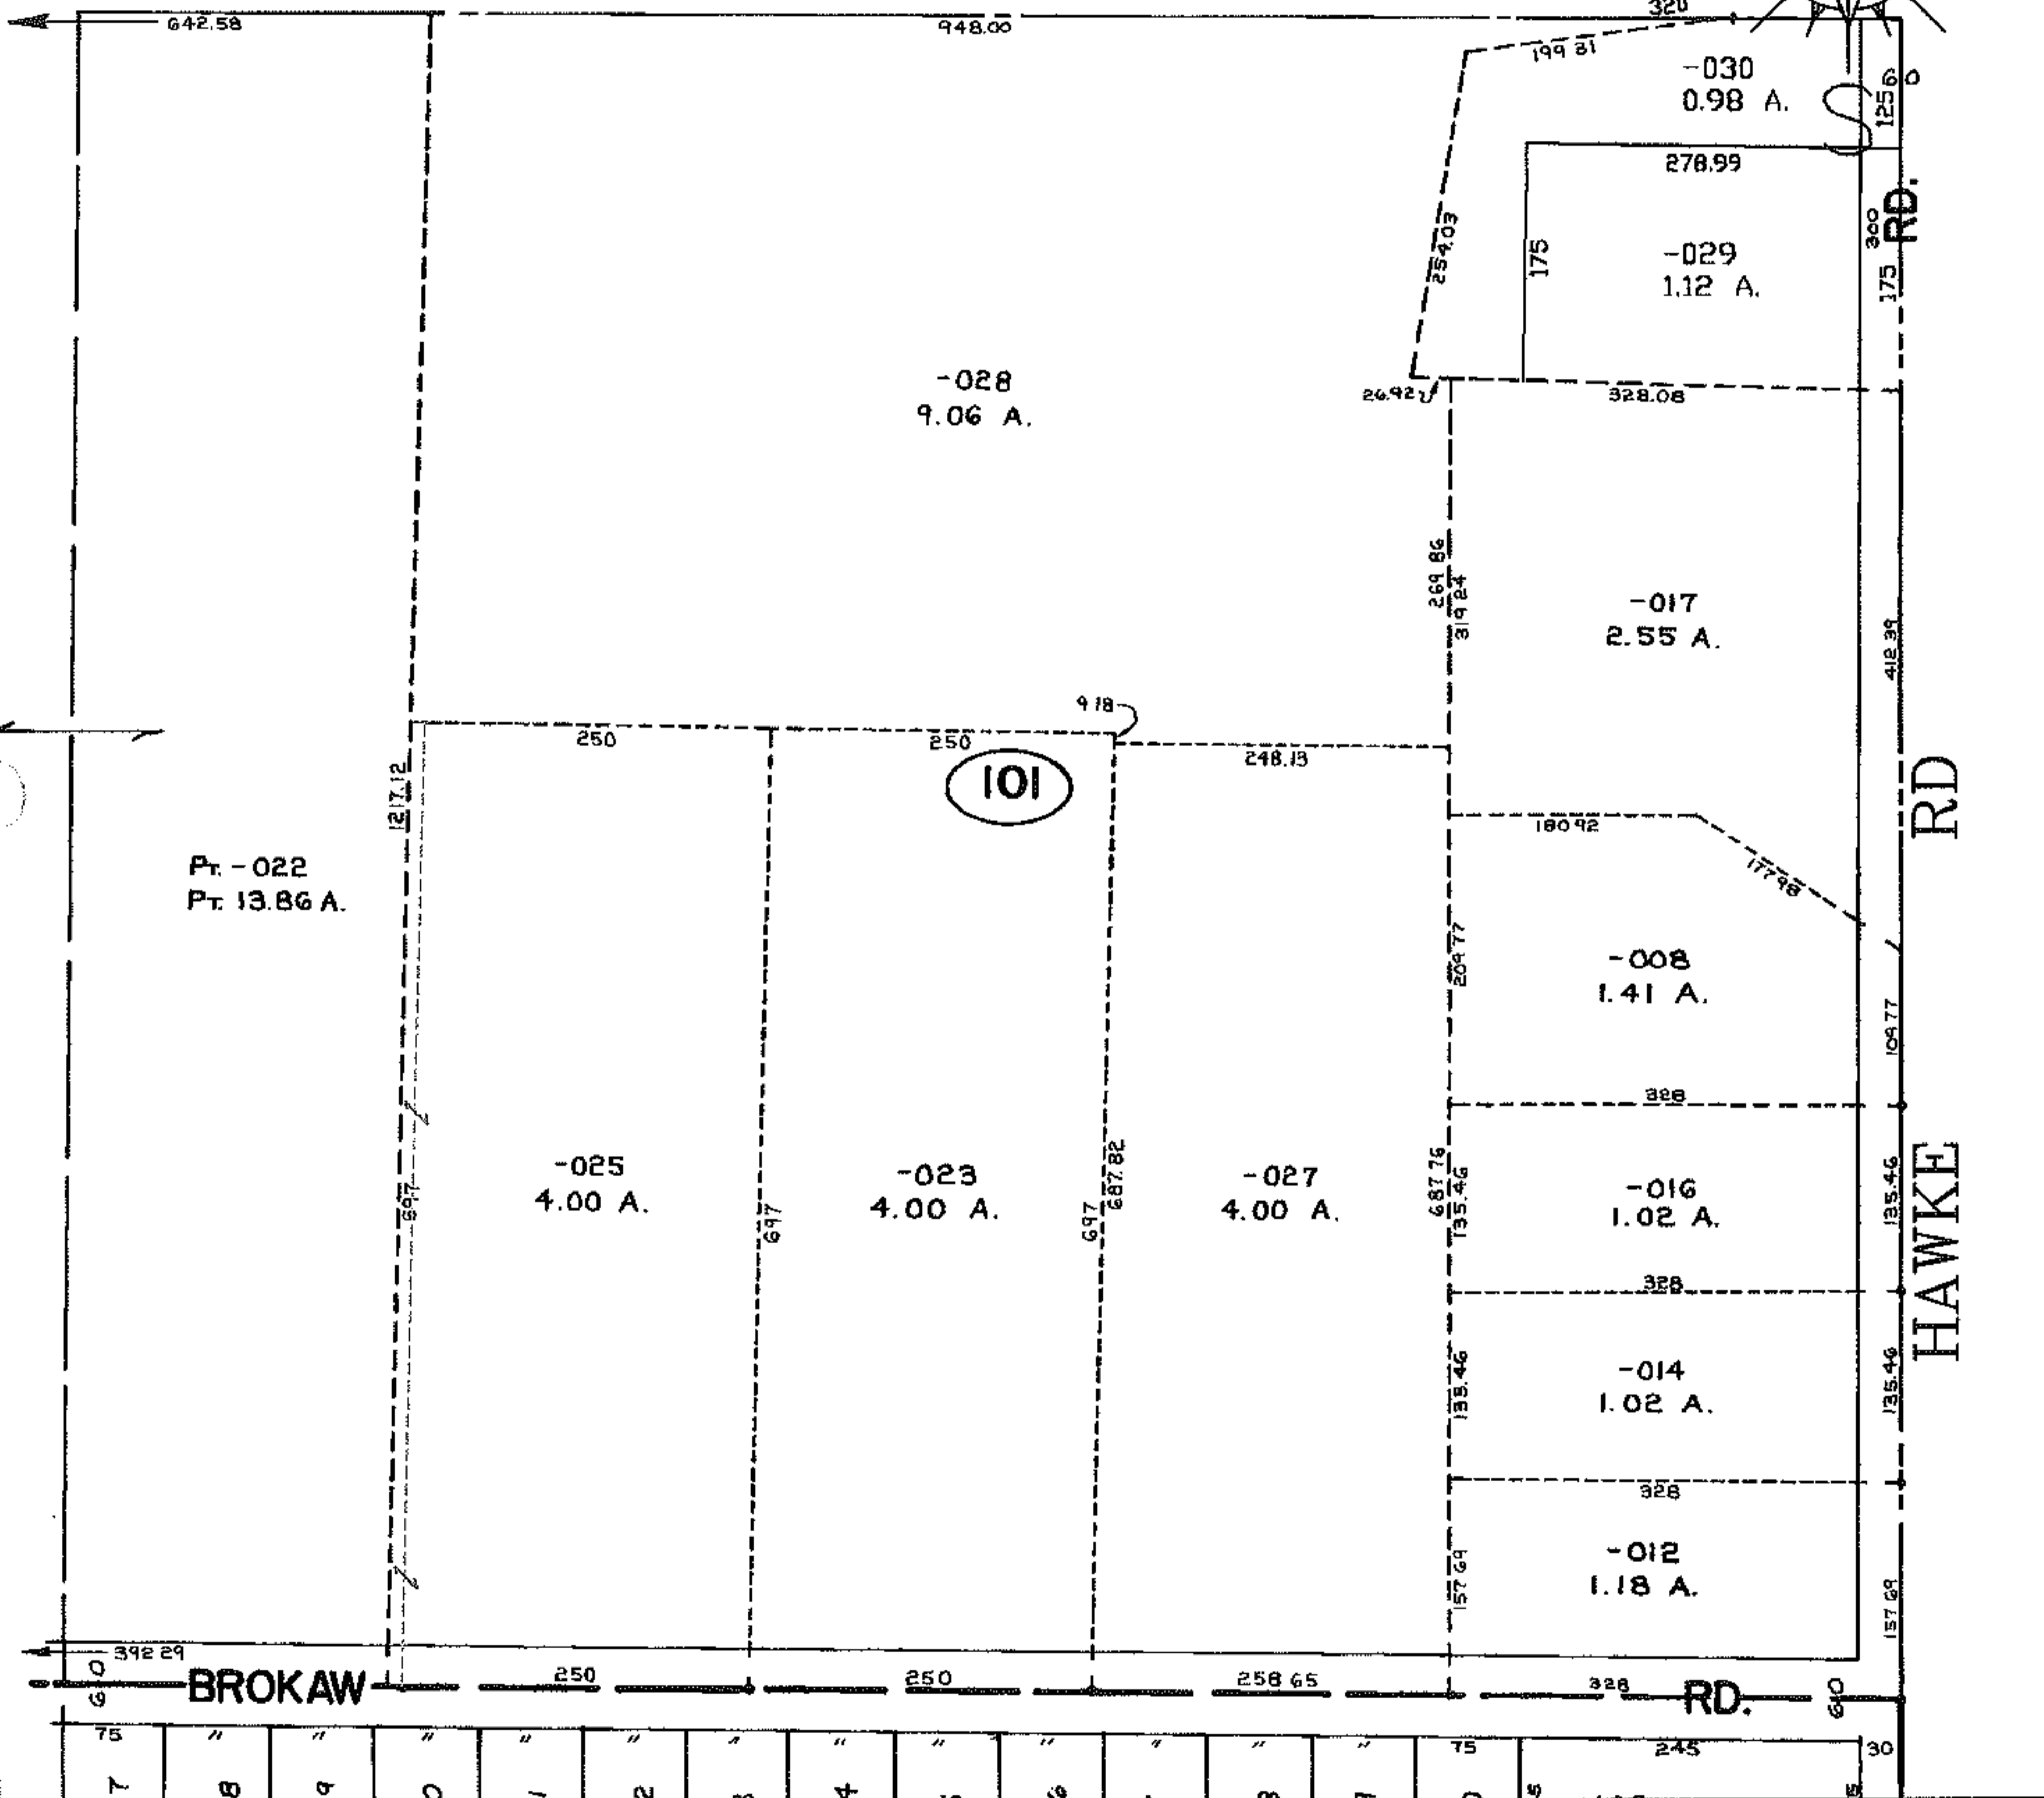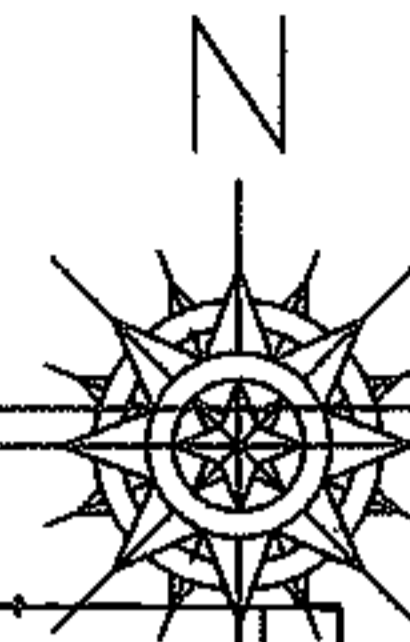

SPLITS/DEEDS PROCESSED

LORAIN COUNTY TAX MAP DEPARTMENT
226 MIDDLE AVE. ELYRIA, OHIO

SURVEYED BY: N/A
 CLOSURE: N/A
 MAP PAGE(S): 11-00-009-B
 APPROVED BY: DRH DATE: 1/28/2008
 SCALE: NOT TO SCALE PRIOR INSTRUMENT: OR 647/680