


PARENT PARCEL: 09-00-092-000-032



CHILD PARCEL: --SAME--

STARTING POINT: INT SE CORNER OF O.L. 82 AND NE CORNER OF O.L. 92

08-01587-A

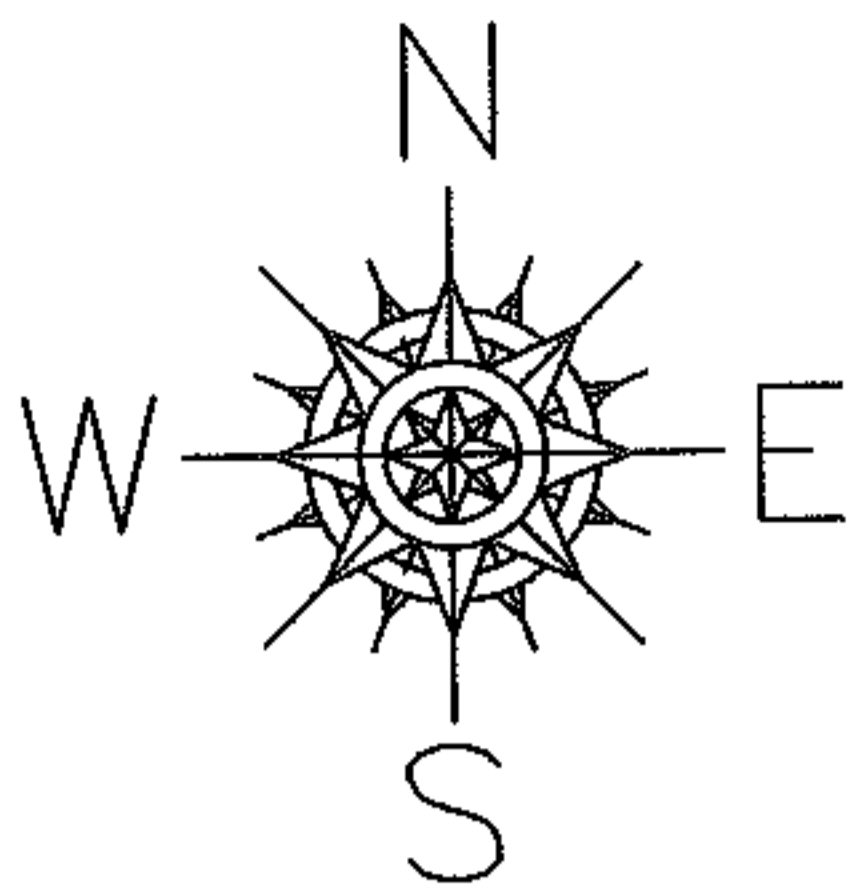

AC. CORR.
PER SURVEY
DALE HAYWOOD

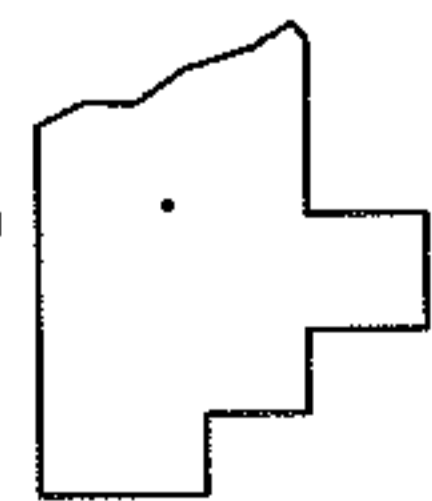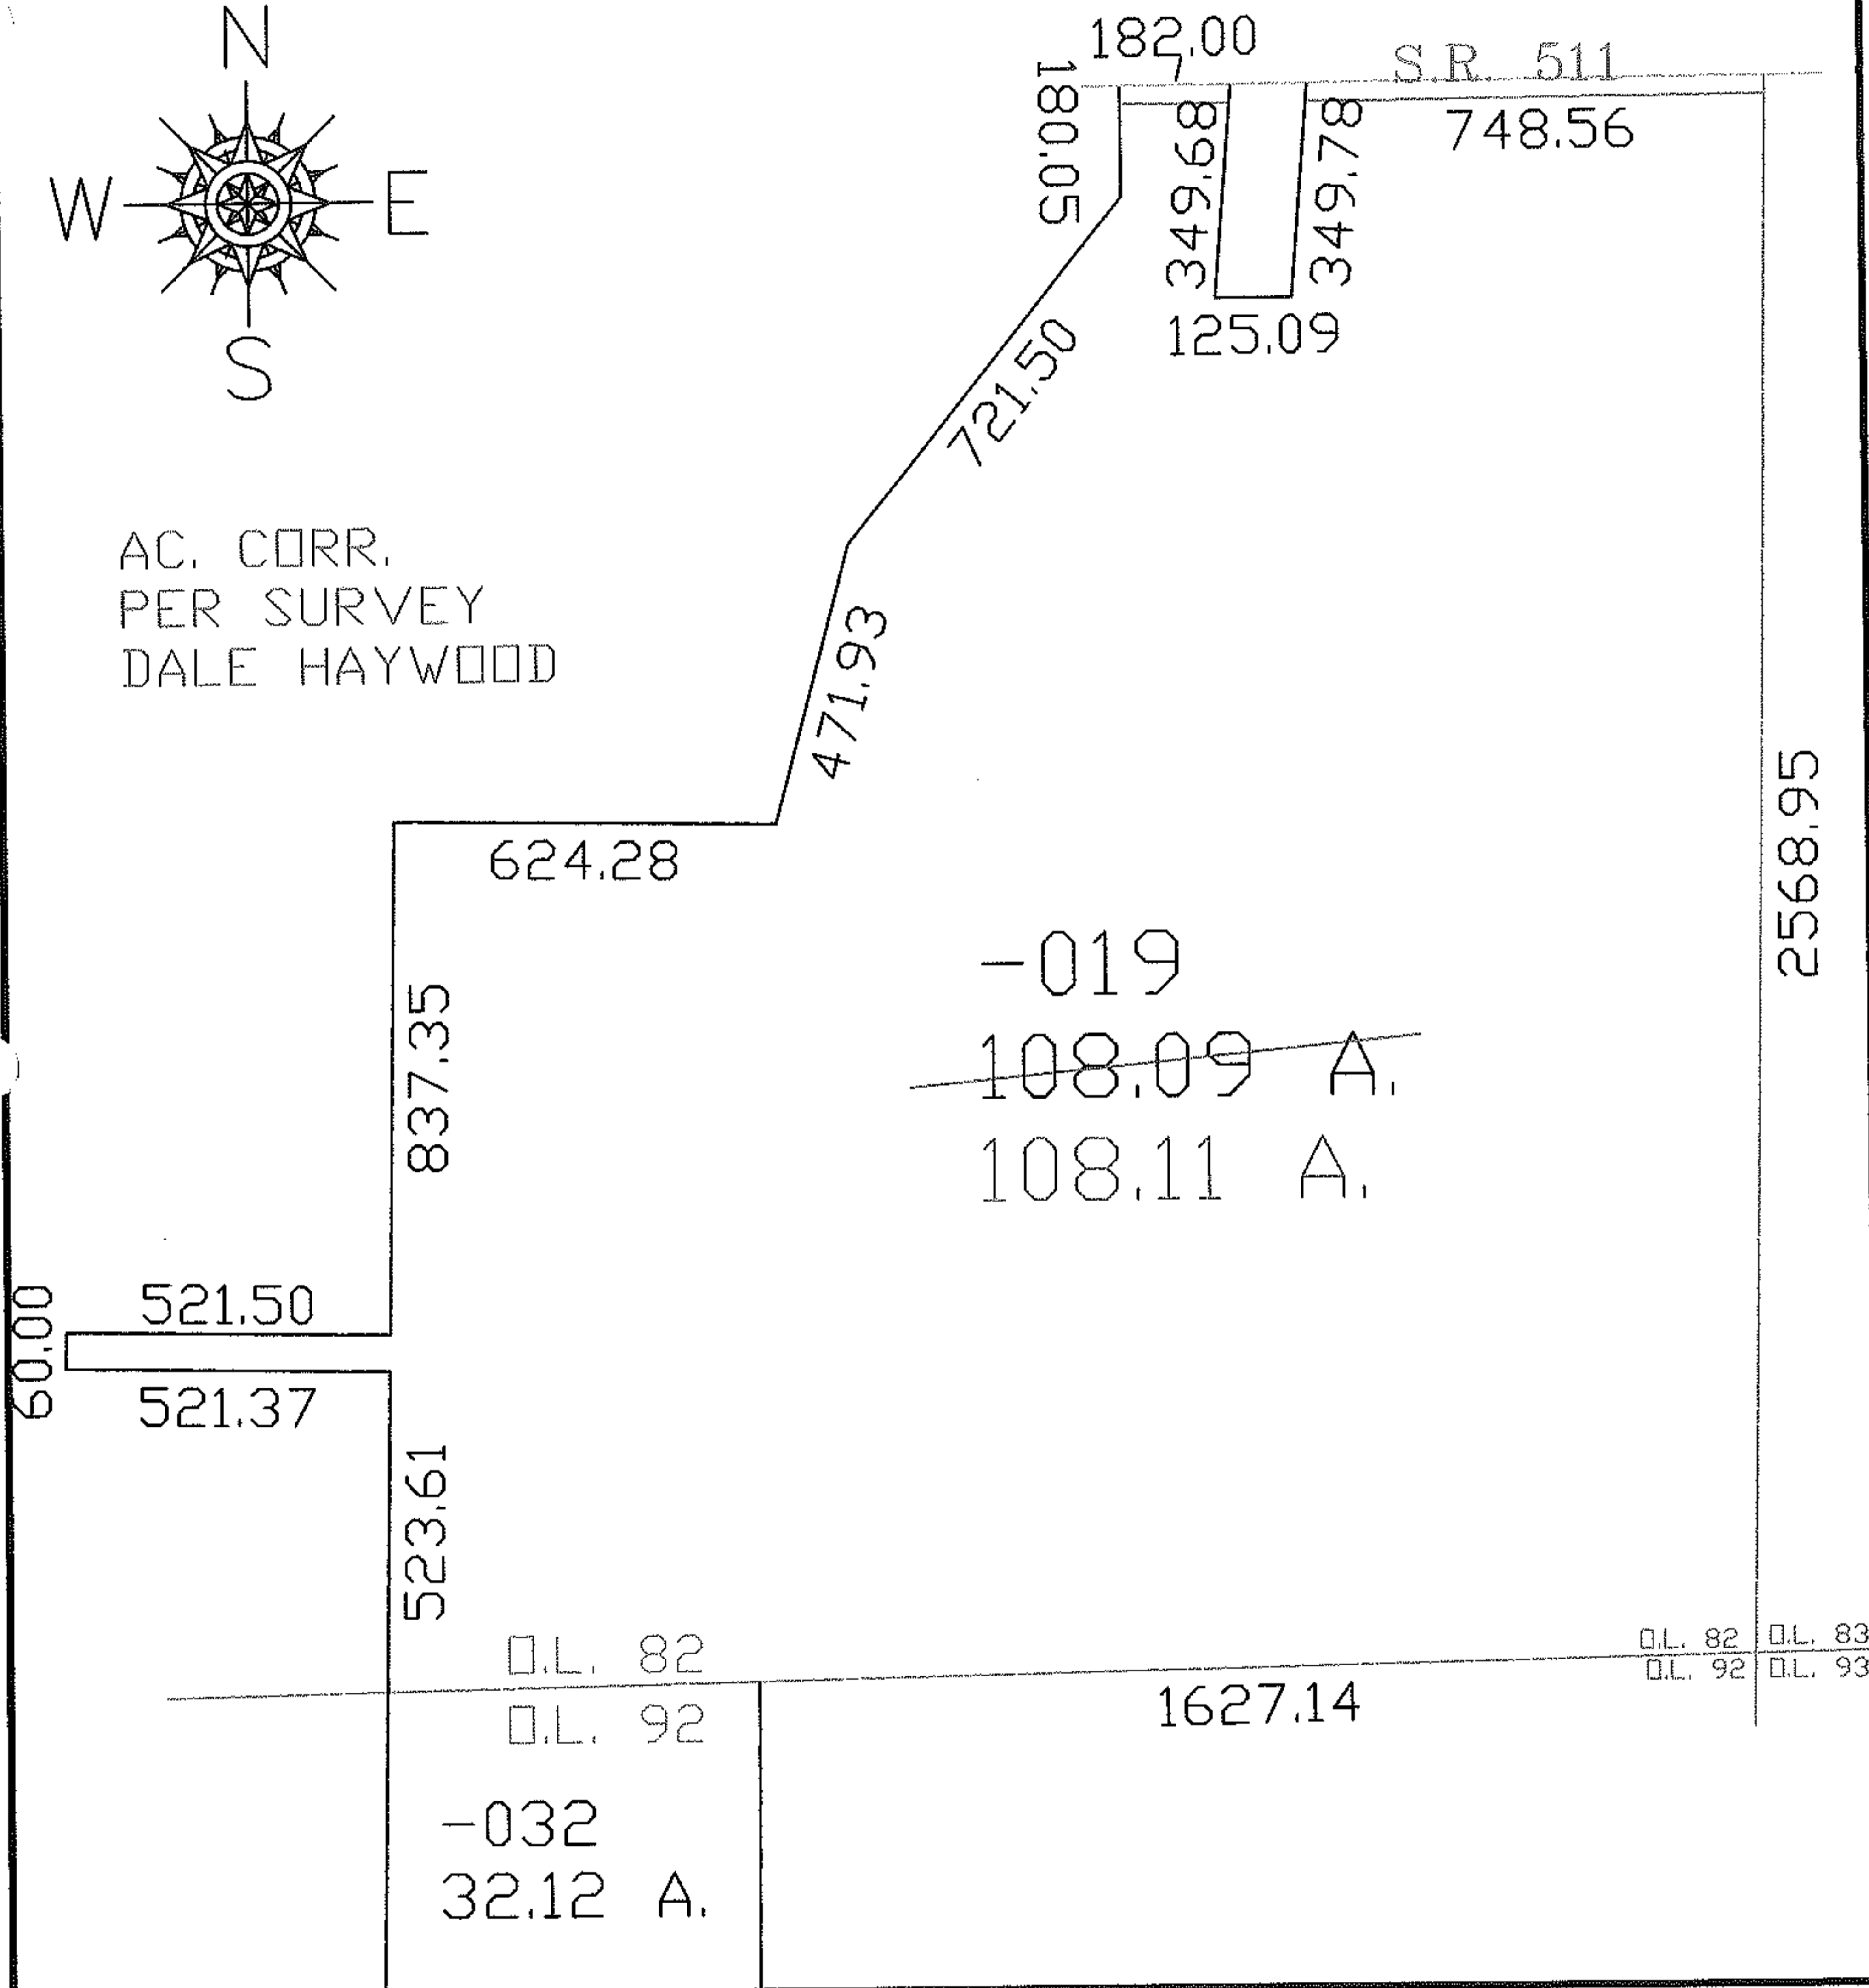

SPLITS/DEEDS PROCESSED
LORAIN COUNTY TAX MAP DEPARTMENT
226 MIDDLE AVE. ELYRIA, OHIO

SURVEYED BY: DALE HAYWOOD
CLOSURE: 1:10,000
MAP PAGE(S): 09-00-082-B
APPROVED BY: DRH DATE: 1/10/2008
SCALE: 1" = 400' PRIOR INSTRUMENT: