

VOID 2/20/09 L Sartan


PARENT PARCEL: 09-00-086-107-033

CHILD PARCEL: --SAME--

08-01596-A

STARTING POINT: INT SOUTH ROW OF EAST VINE AND WEST ROW OF SOUTH PARK ST

AC. CORR.  
PER SURVEY  
RICHARD FREDRICKSON

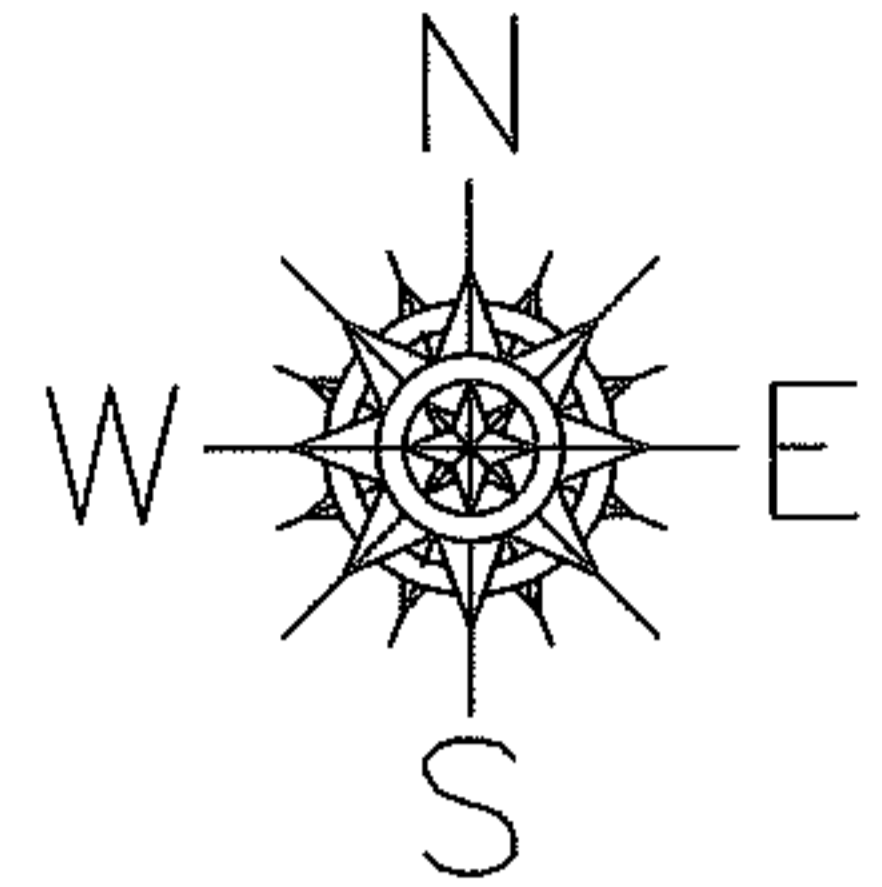

EAST VINE ST

501.34

275.75

277.29


~~1.81~~ A.

1.77 A.

280.97

SOUTH PARK ST

277.62

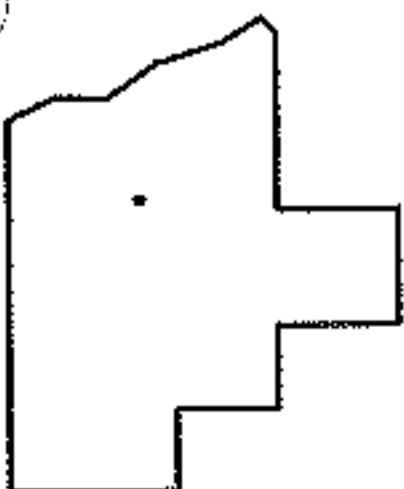

SPLITS/DEEDS PROCESSED

LORAIN COUNTY TAX MAP DEPARTMENT  
226 MIDDLE AVE. ELYRIA, OHIO

SURVEYED BY: R. FREDRICKSON

CLOSURE: 1:10,000

MAP PAGE(S): 09-00-086-A

APPROVED BY: DRH DATE: 1/29/2008

SCALE: 1" = 100' PRIOR INSTRUMENT: DV 1163/691