

MASTER



PARENT PARCEL: 04-00-011-105-018

08-01605-C

CHILD PARCEL: --SAME--

STARTING POINT: INT BAUERDALE AVE AND STONEY RIDGE RD

AC. CORR. PER DEED  
EXCEPTION WAS LEFT OFF  
OF PRIOR

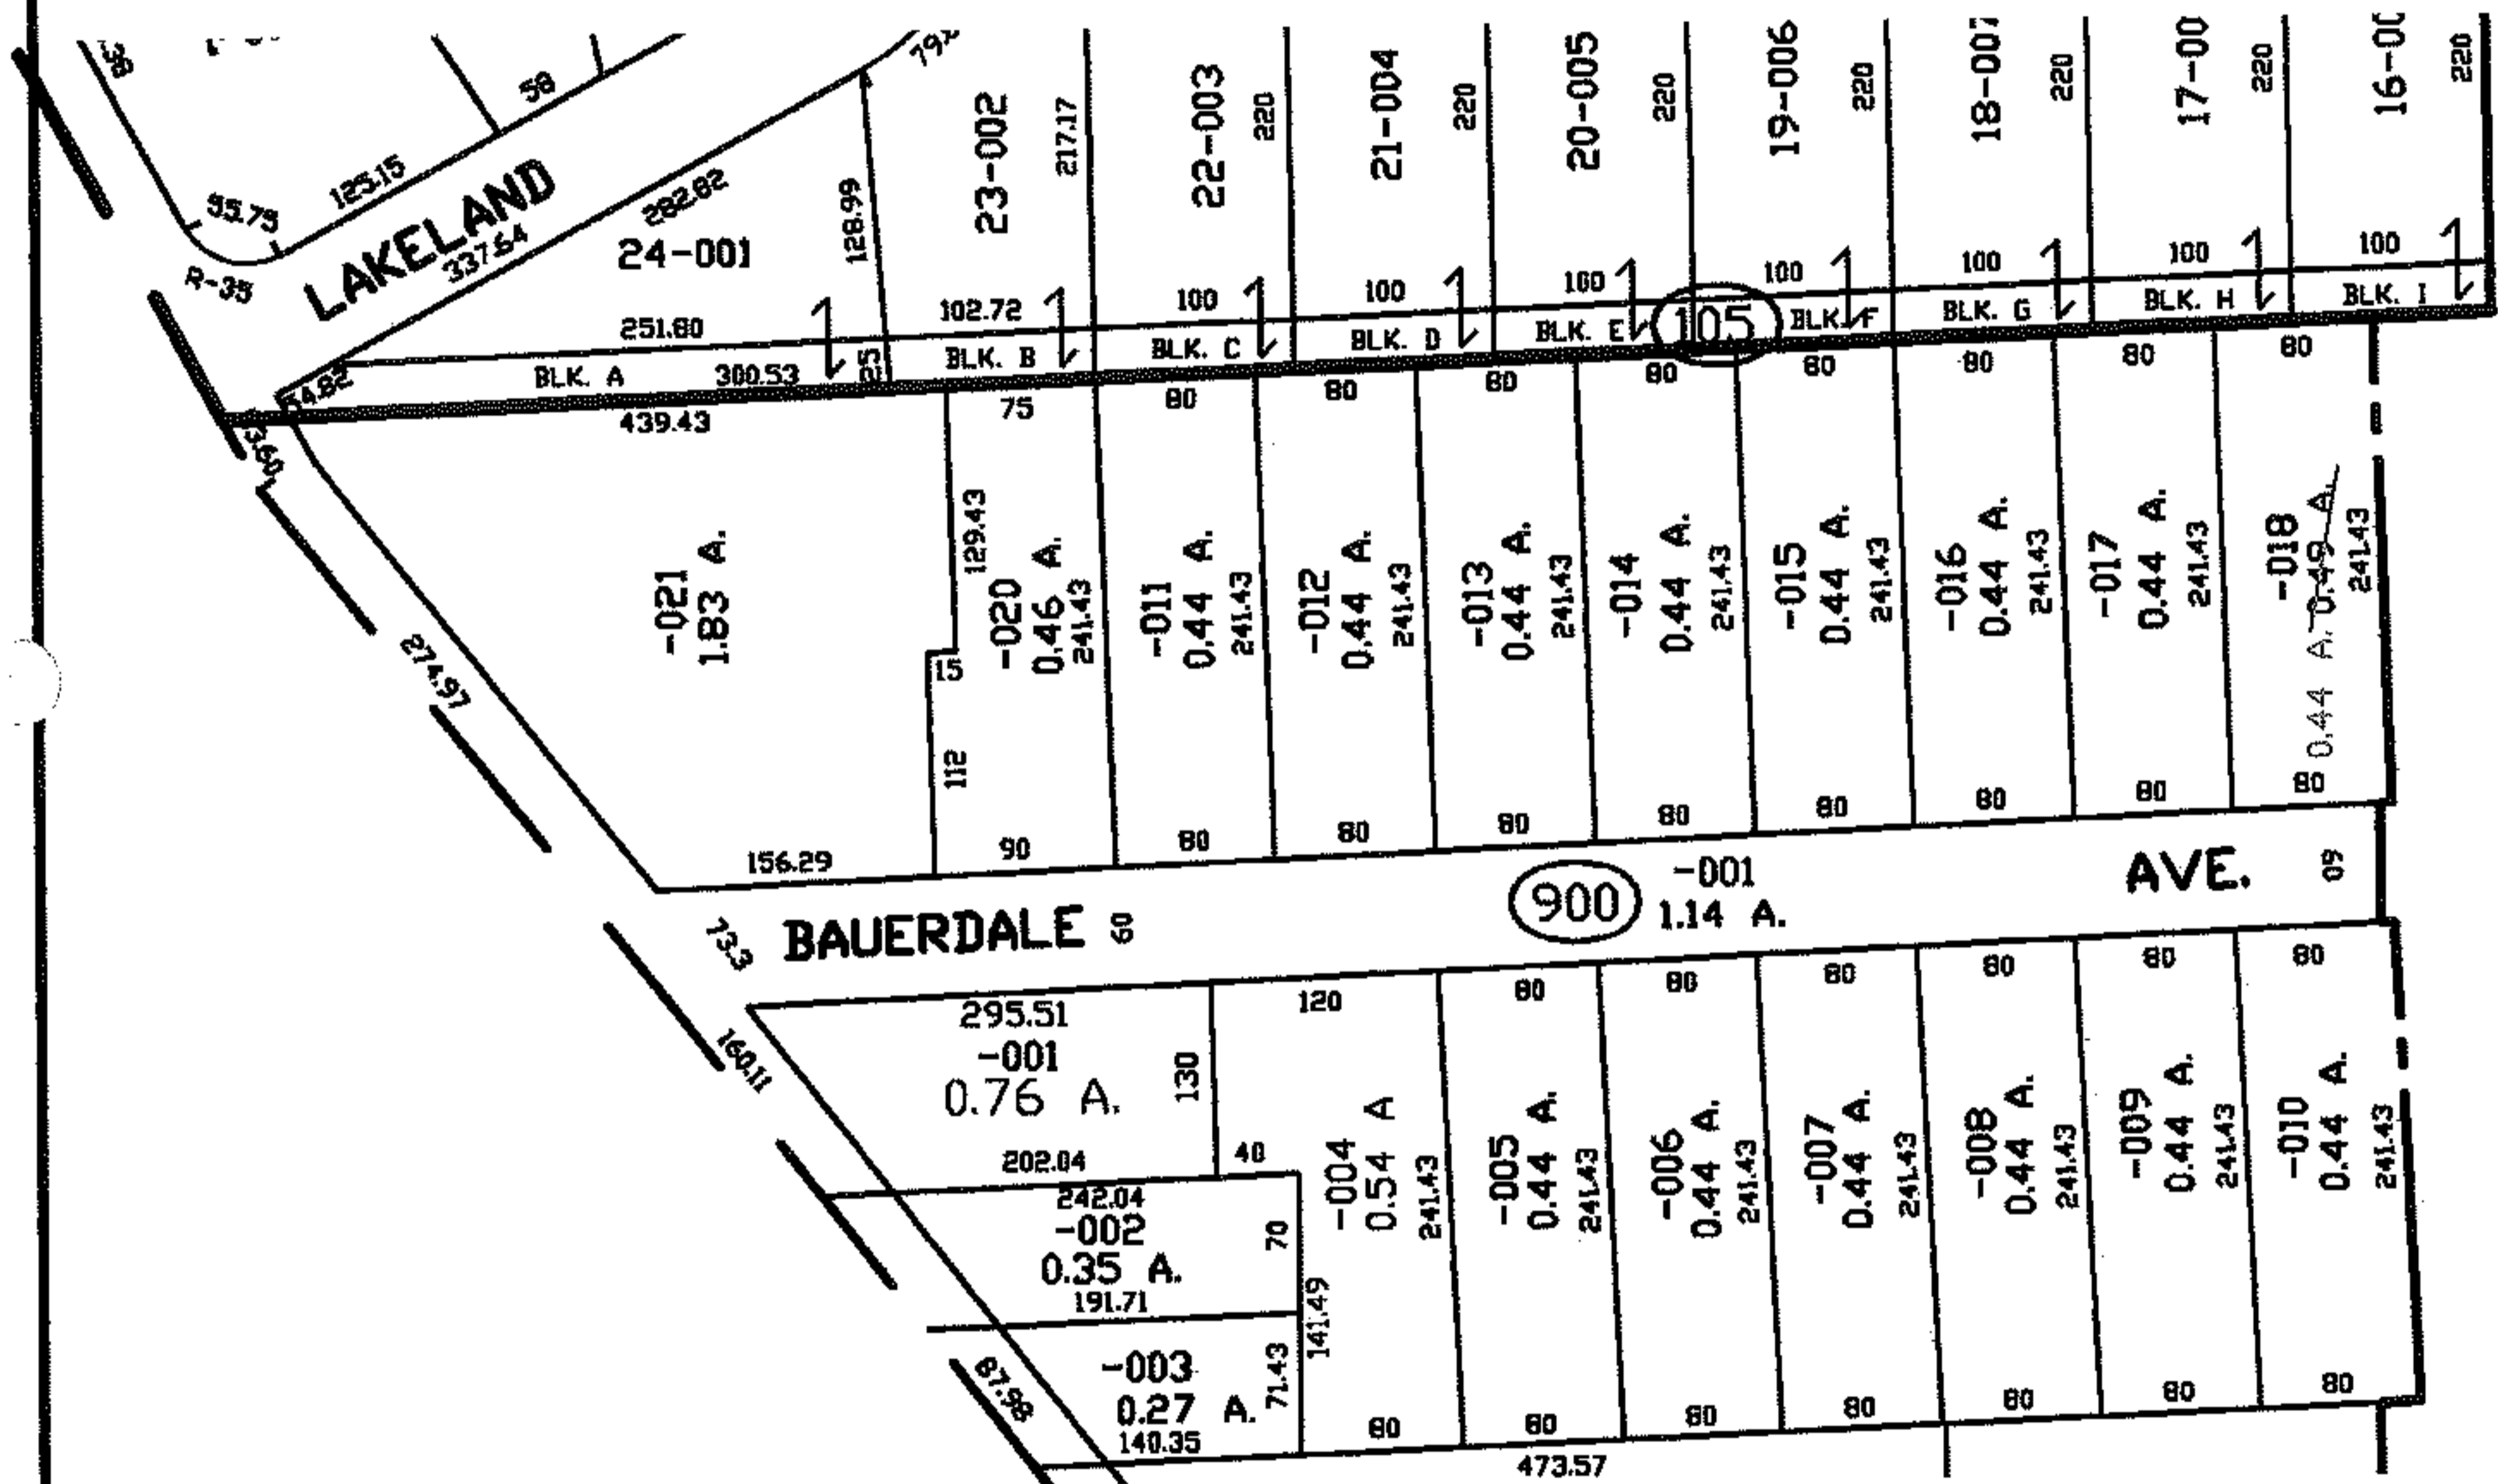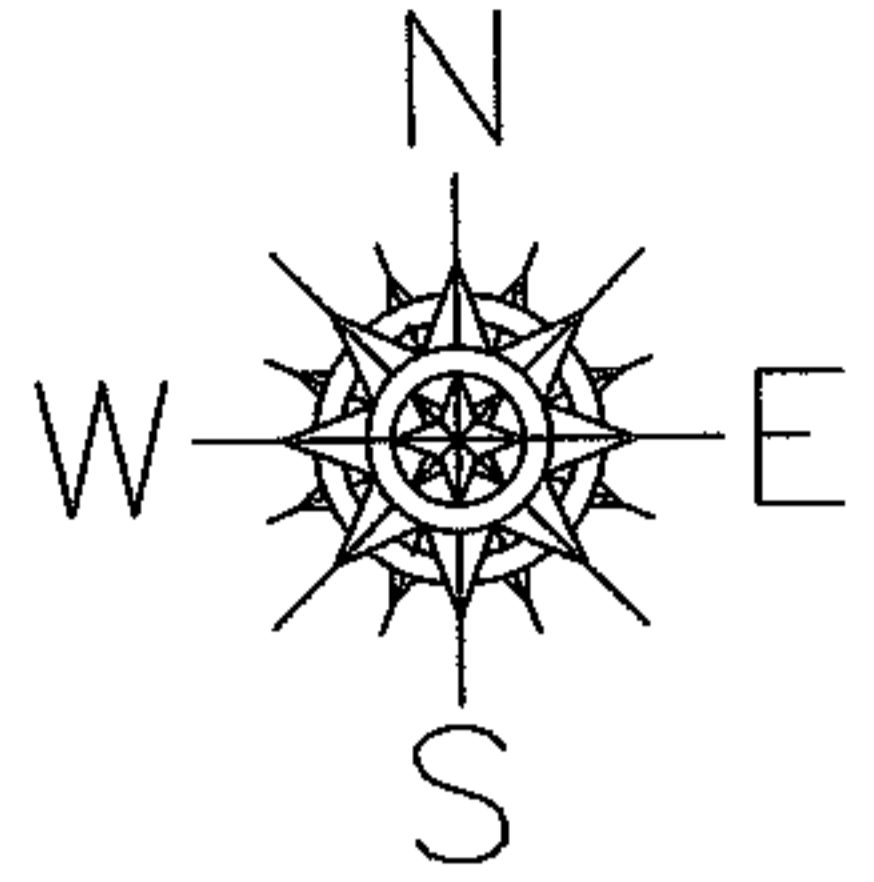

4-A

SPLITS/DEEDS PROCESSED

LORAIN COUNTY TAX MAP DEPARTMENT  
226 MIDDLE AVE. ELYRIA, OHIO

SURVEYED BY: J.W. WARDEN

CLOSURE: 1:10,000

MAP PAGE(S): 04-00-011-D

APPROVED BY: DRH DATE: 2/19/2008

SCALE: 1" = 100 PRIOR INSTRUMENT: 20070188948