

RASTER




PARENT PARCEL: ADD TO DUP

CHILD PARCEL: 03-00-109-119-014 & 03-00-109-121-014

STARTING POINT: INT MAYFIELD AVE AND RIDGELAND ST

08-01606-X

ADD TO DUP
PER VAC ORD
92-972

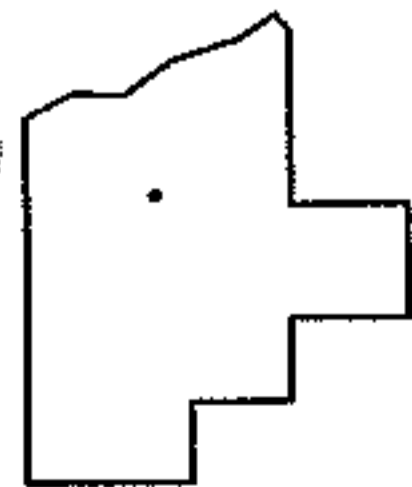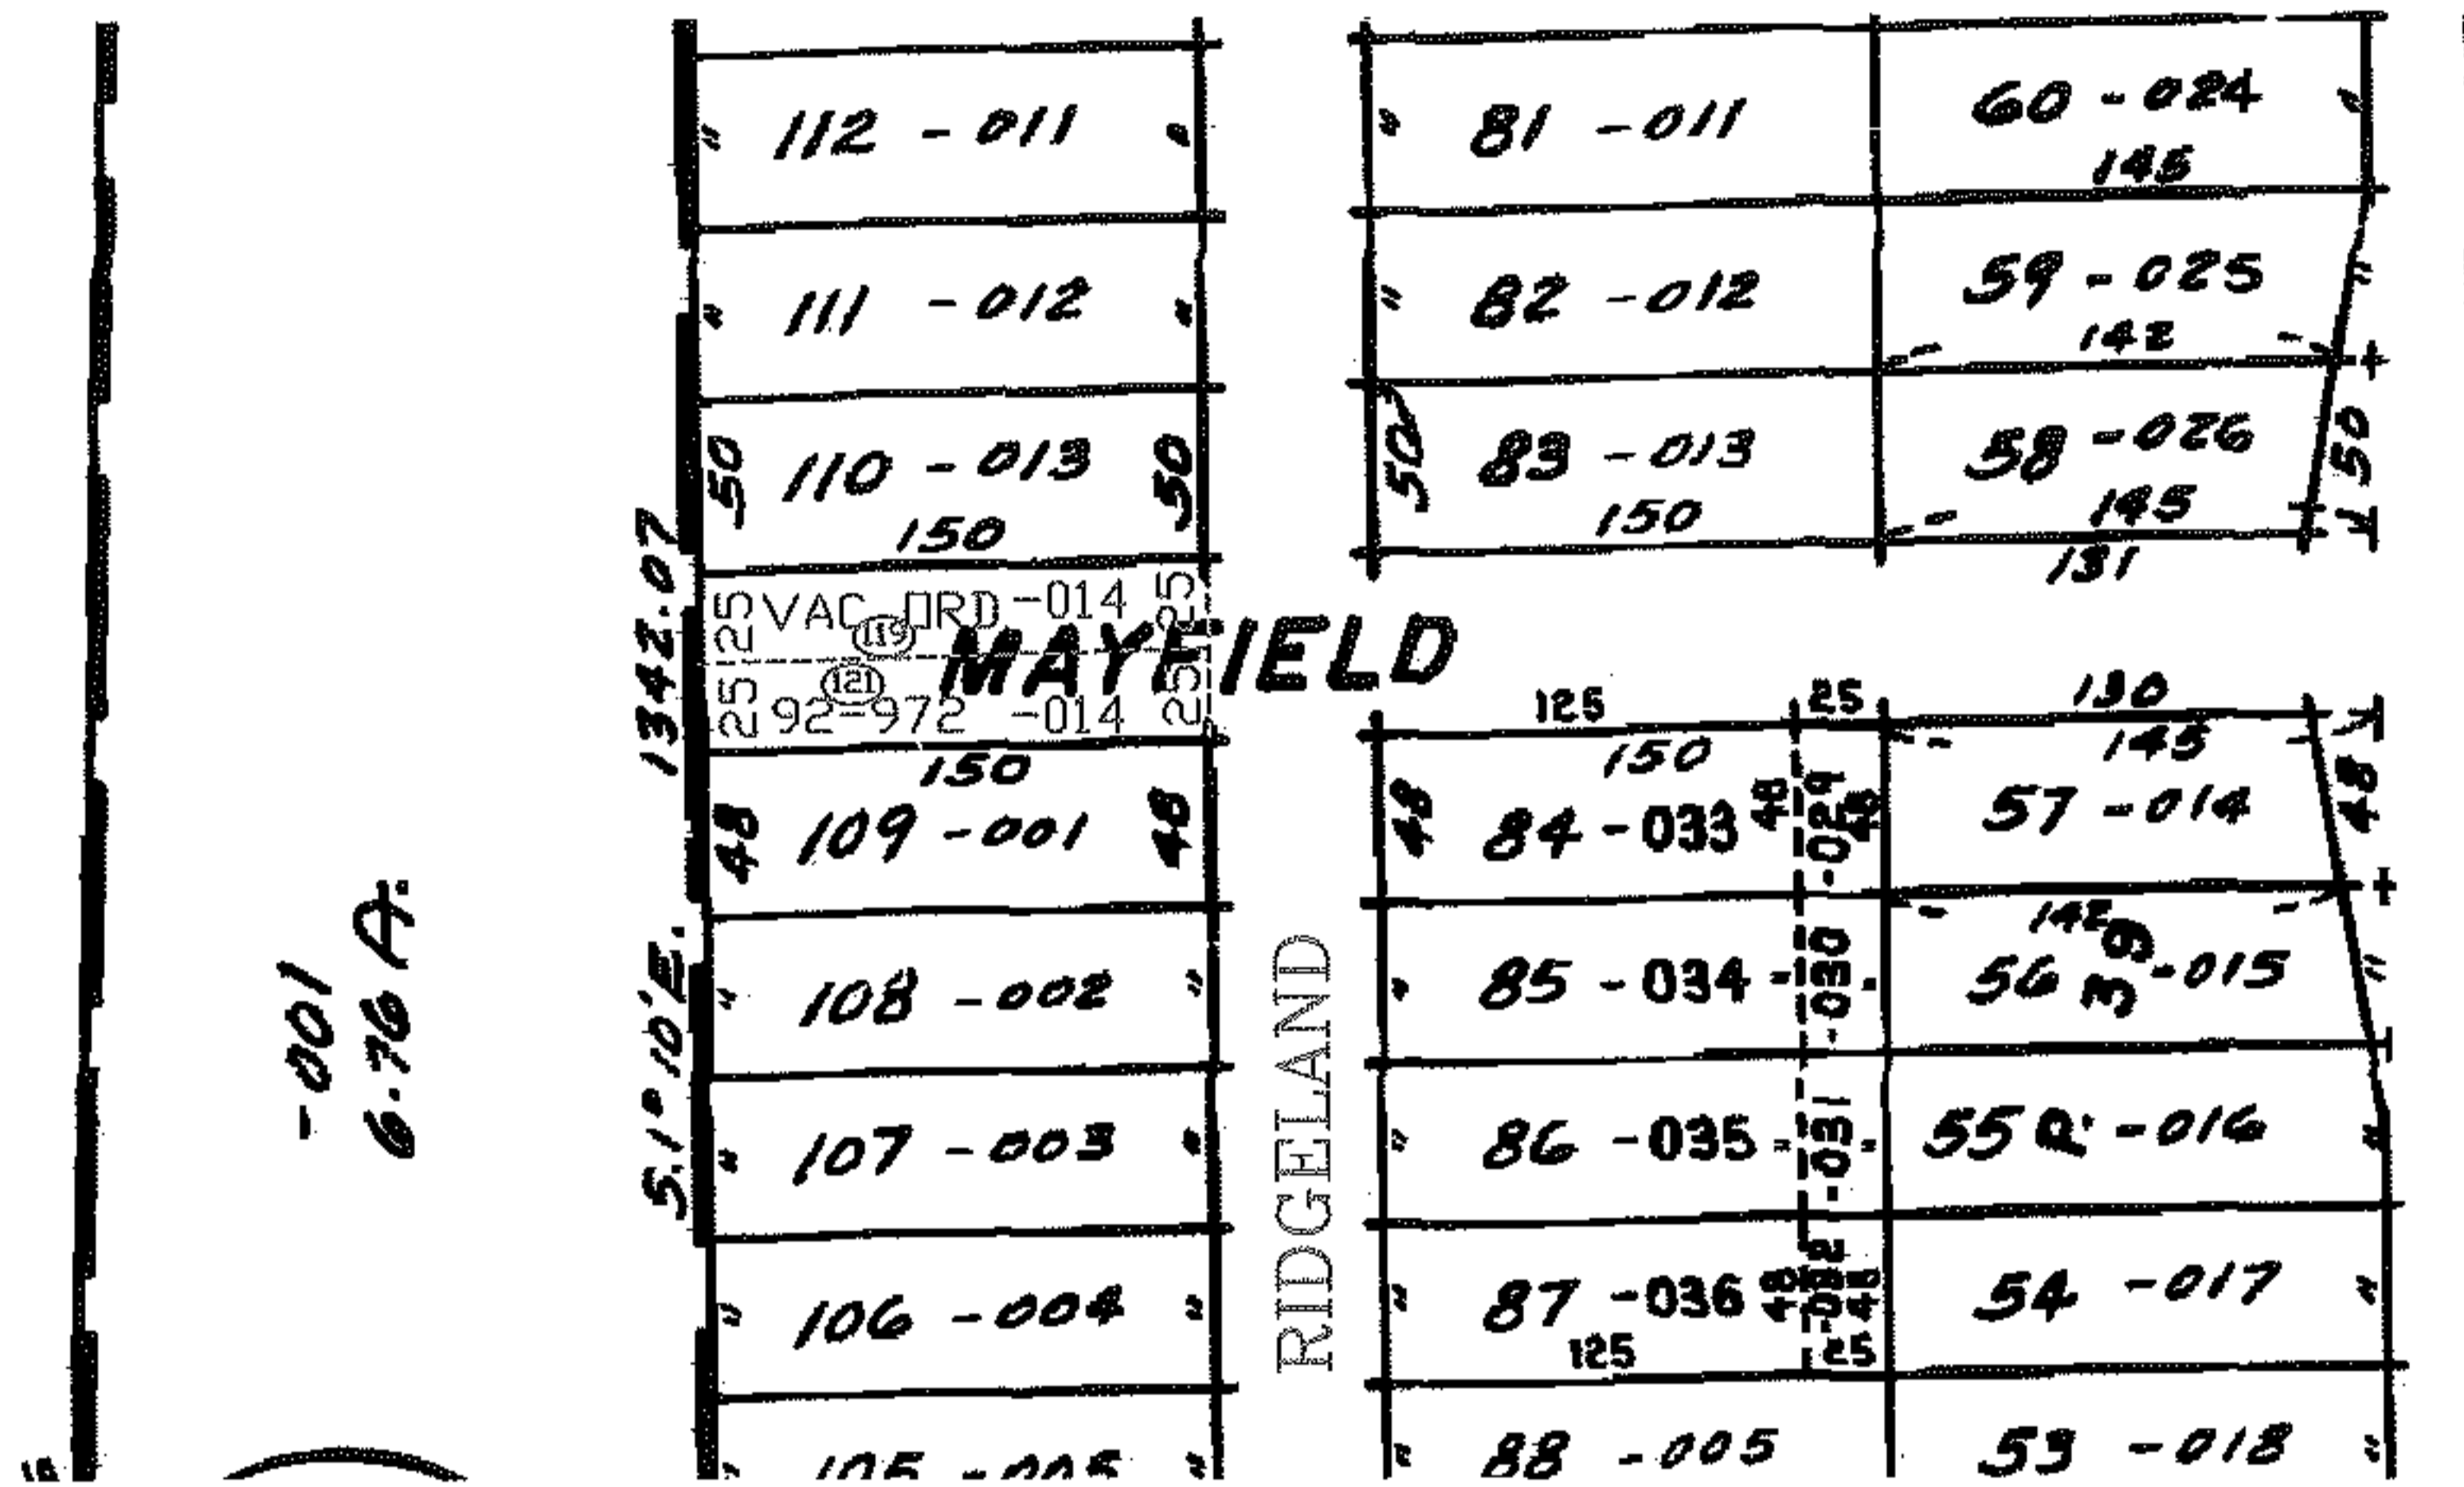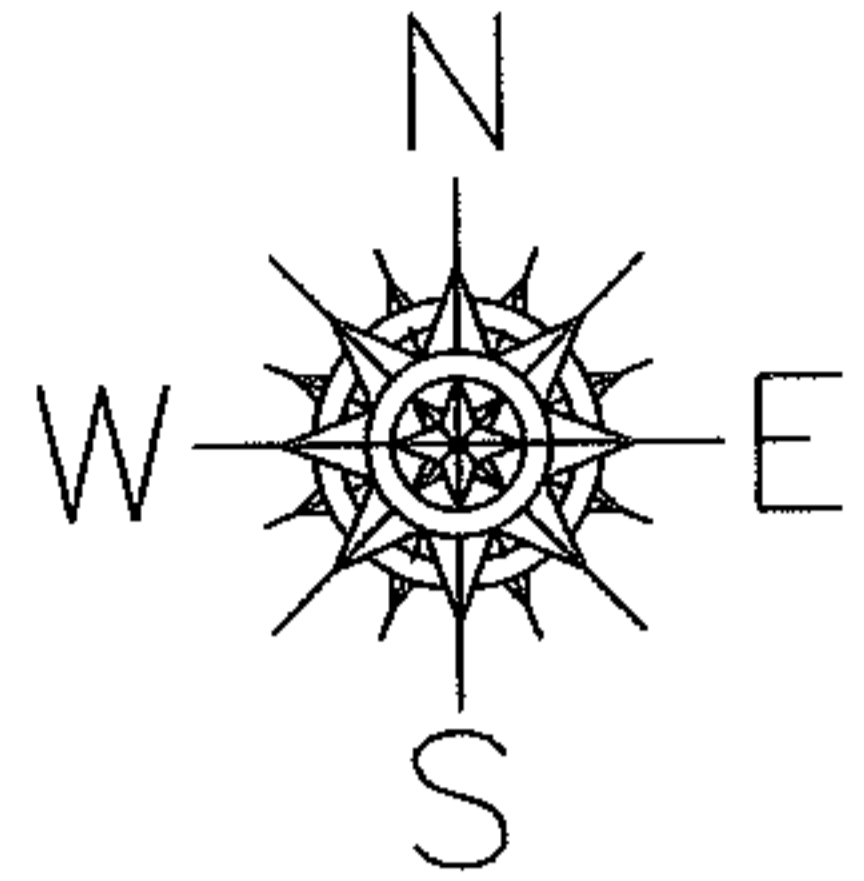

SPLITS/DEEDS PROCESSED

LORAIN COUNTY TAX MAP DEPARTMENT
226 MIDDLE AVE. ELYRIA, OHIO

SURVEYED BY: N/A

CLOSURE: N/A

MAP PAGE(S): 03-00-119-B

APPROVED BY: DRH DATE: 2/22/08

SCALE: NOT TO SCALE PRIOR INSTRUMENT: 20060176561