



RASTER

PARENT PARCEL: 18-00-002-000-001

CHILD PARCEL: XX-XX-XXX-XXX-XXX

STARTING POINT: XXXXXX

NO. 08-01609-A

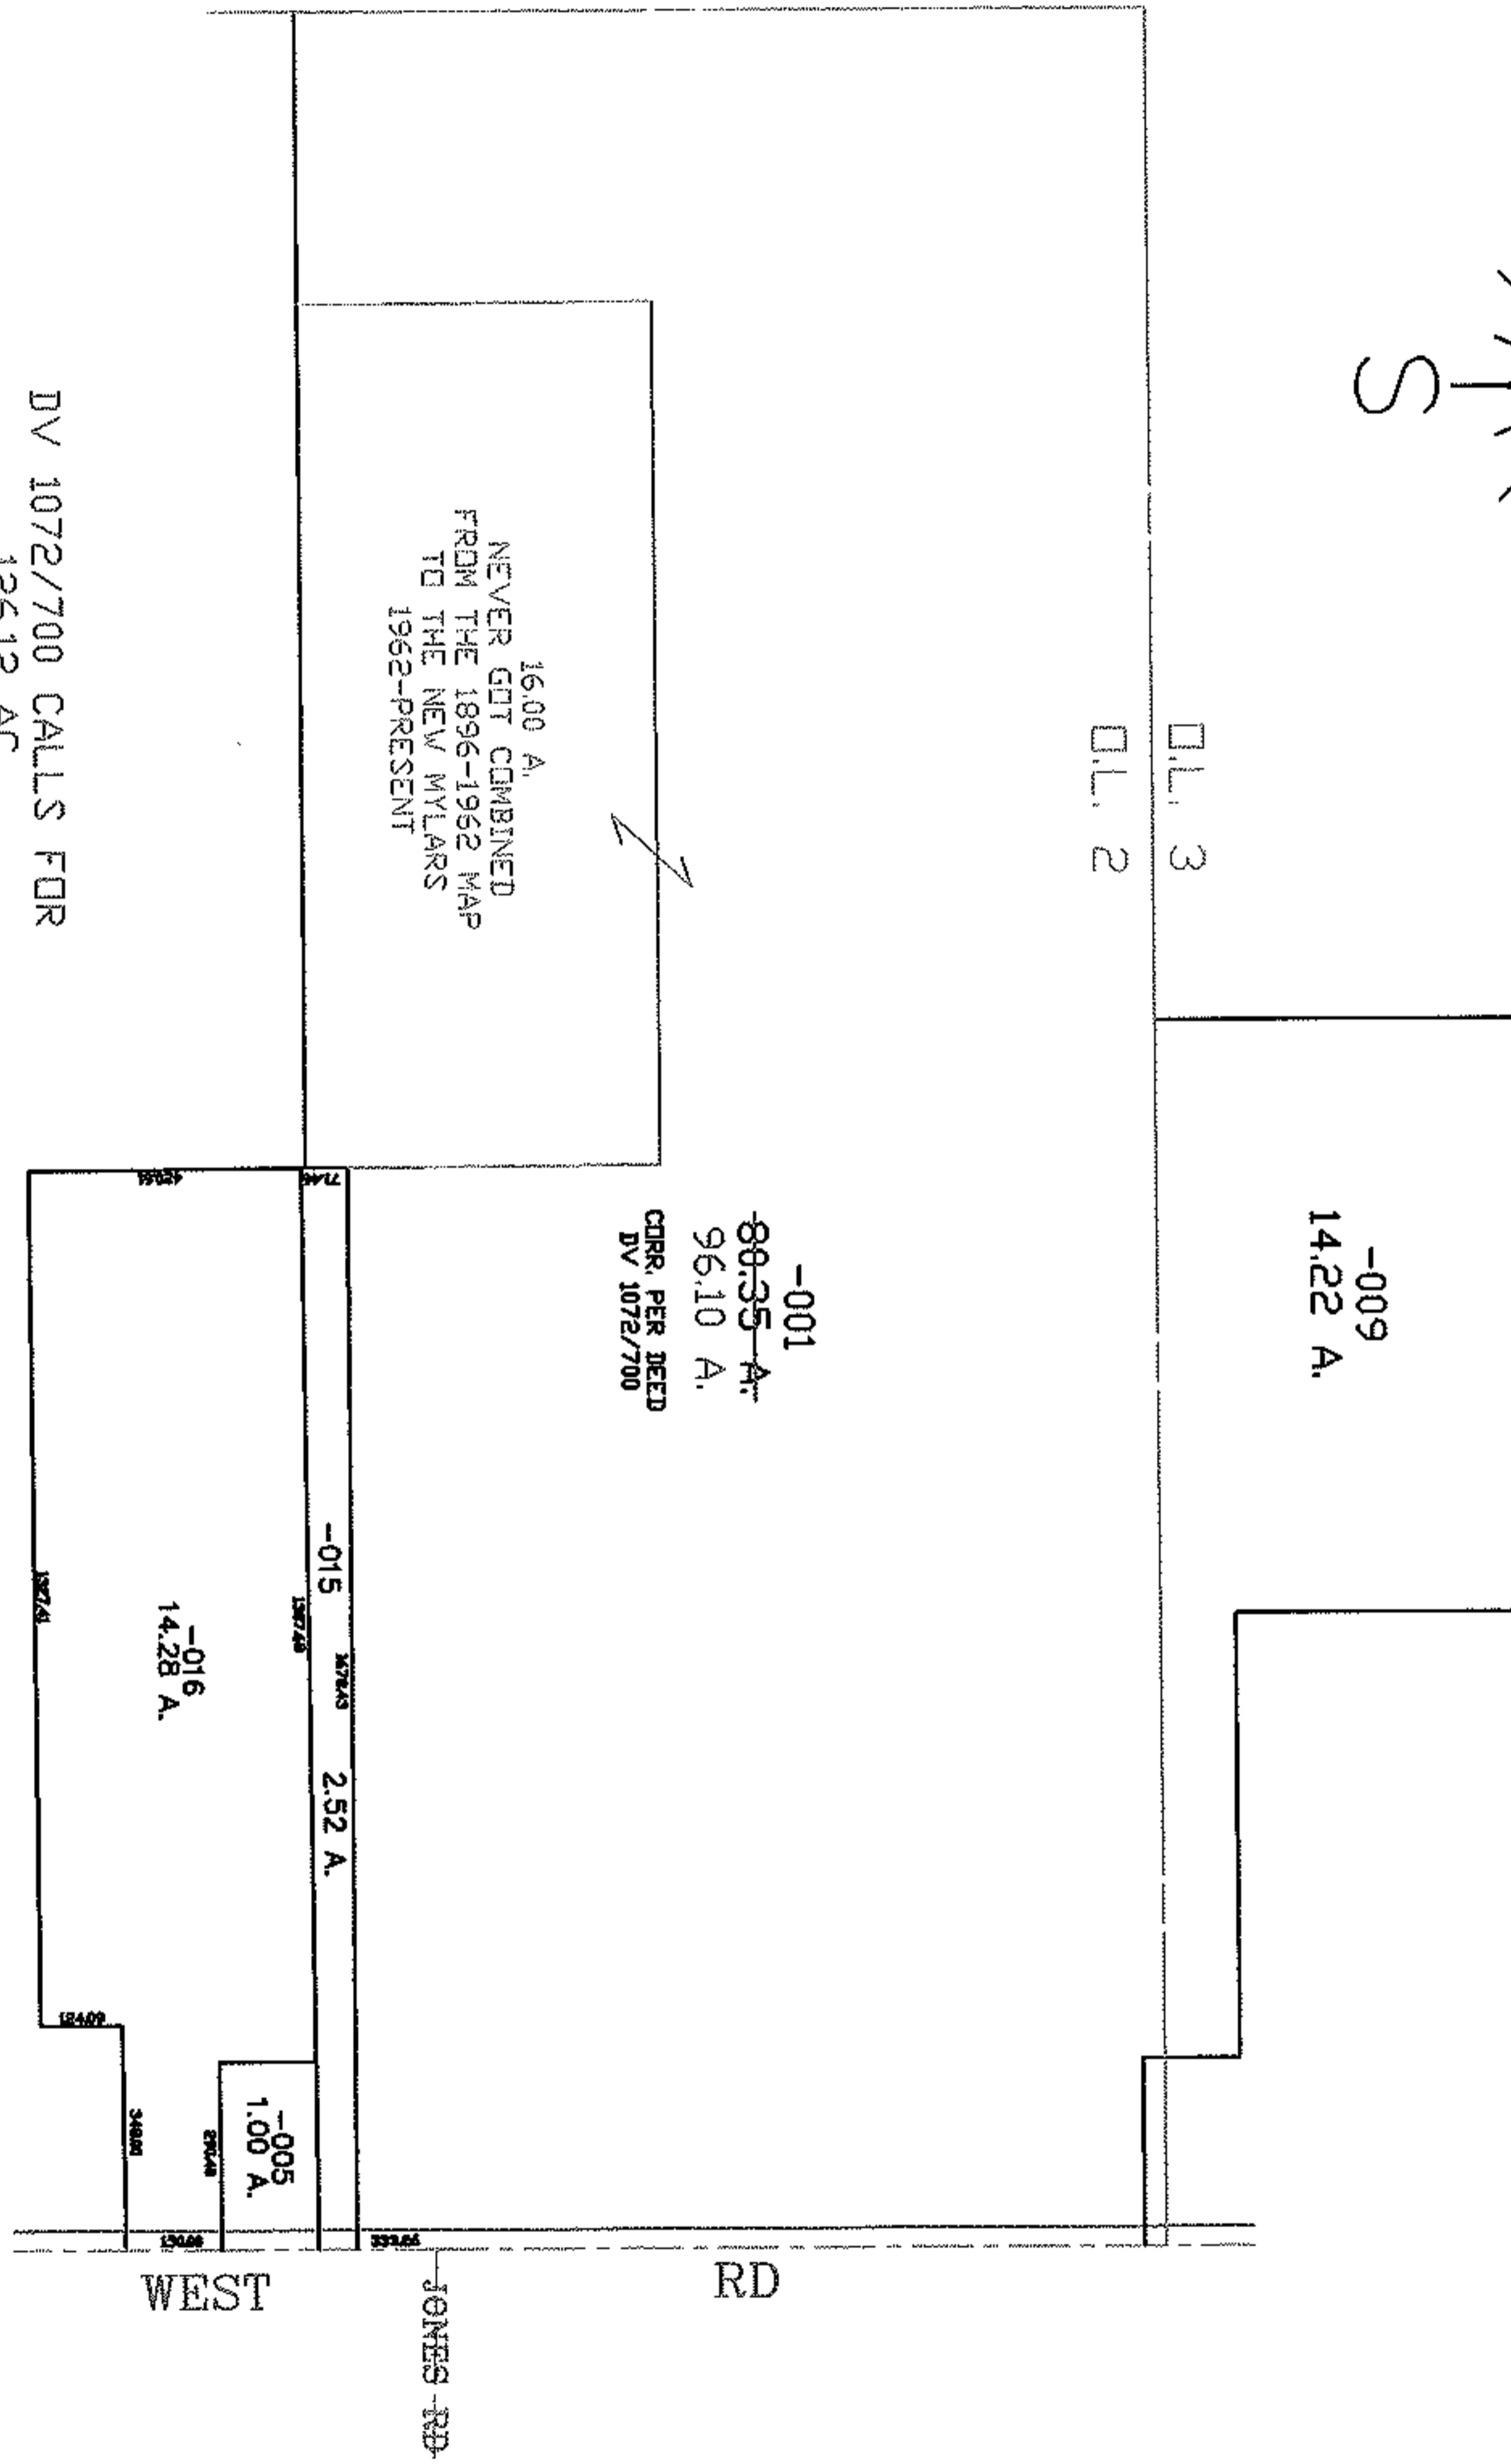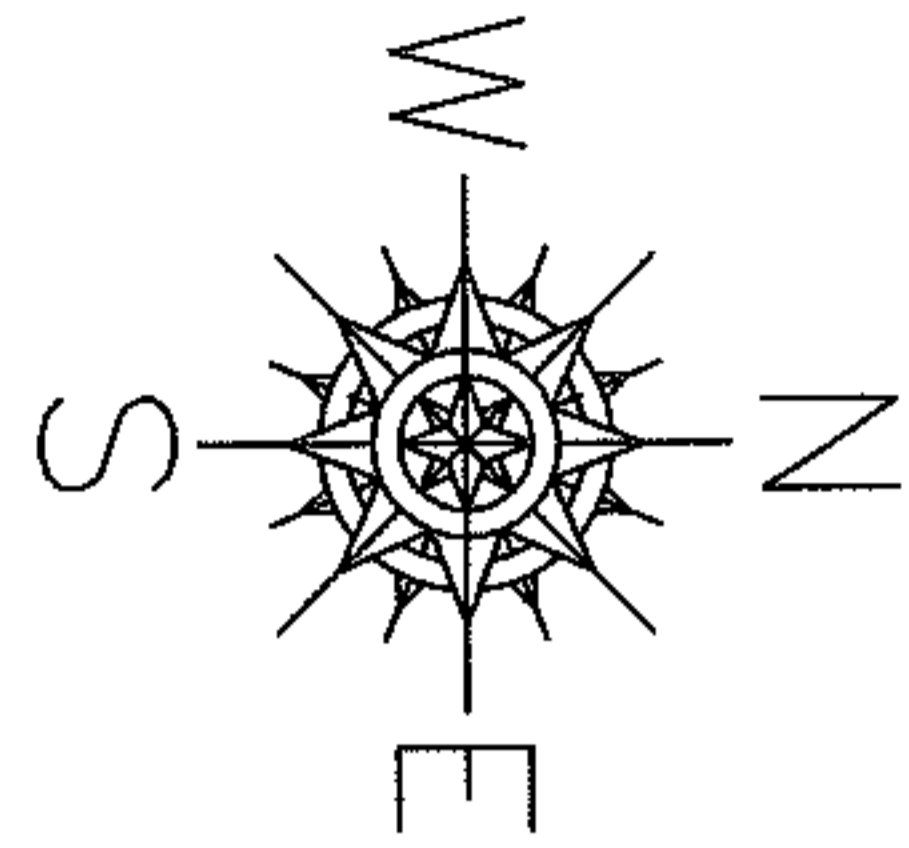

16.00 A.
NEVER GOT COMBINED
FROM THE 1896-1952 MAP
TO THE NEW MYLARS
1952-PRESENT


DV 1072/700 CALLS FOR
126.12 AC.
THEN THEY SPLIT OFF
13.28 A. WHICH WAS COMBINED
TO MAKE -016 14.28 A.

126.12 A.
-13.28 A.
112.84 A.

-001
~~80.35 A.~~
96.10 A.
CORR. PER DEED
DV 1072/700

-009
14.22 A.

18-00-003-000-009 14.22 A.
18-00-002-000-001 96.10 A.
18-00-002-000-015 2.52 A.
TOTAL 112.84 A.

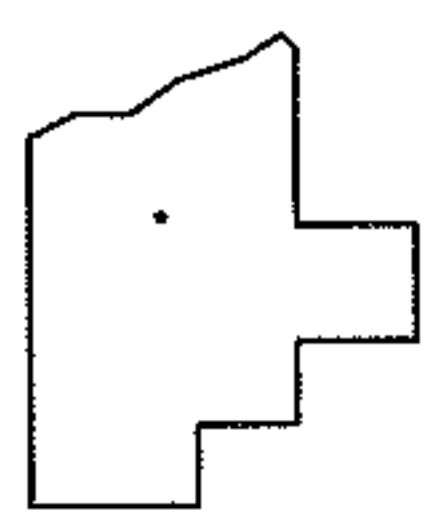

SPLITS/DEEDS PROCESSED
LORAIN COUNTY TAX MAP DEPARTMENT
226 MIDDLE AVE. ELYRIA, OHIO

SURVEYED BY: PER DEED
CLOSURE: XXXXXX
MAP PAGE(S): 18-H
APPROVED BY: TJS DATE: 2/28/08
SCALE: 1" = 100 PRIOR INSTRUMENT: DV 1072/700