

PARENT PARCEL: 15-00-019-000-002

CHILD PARCEL: XX-XX-XXX-XXX-XXX

STARTING POINT: XXXXXX

NO. 08-01610-C

MAP & ACREAGE CORRECTION

15-00-019-000-002



~~2.00 A.~~

0.78 A. CALC.

CORR. PER DEED

V. 32 PG. 31

V. 88 PG. 335

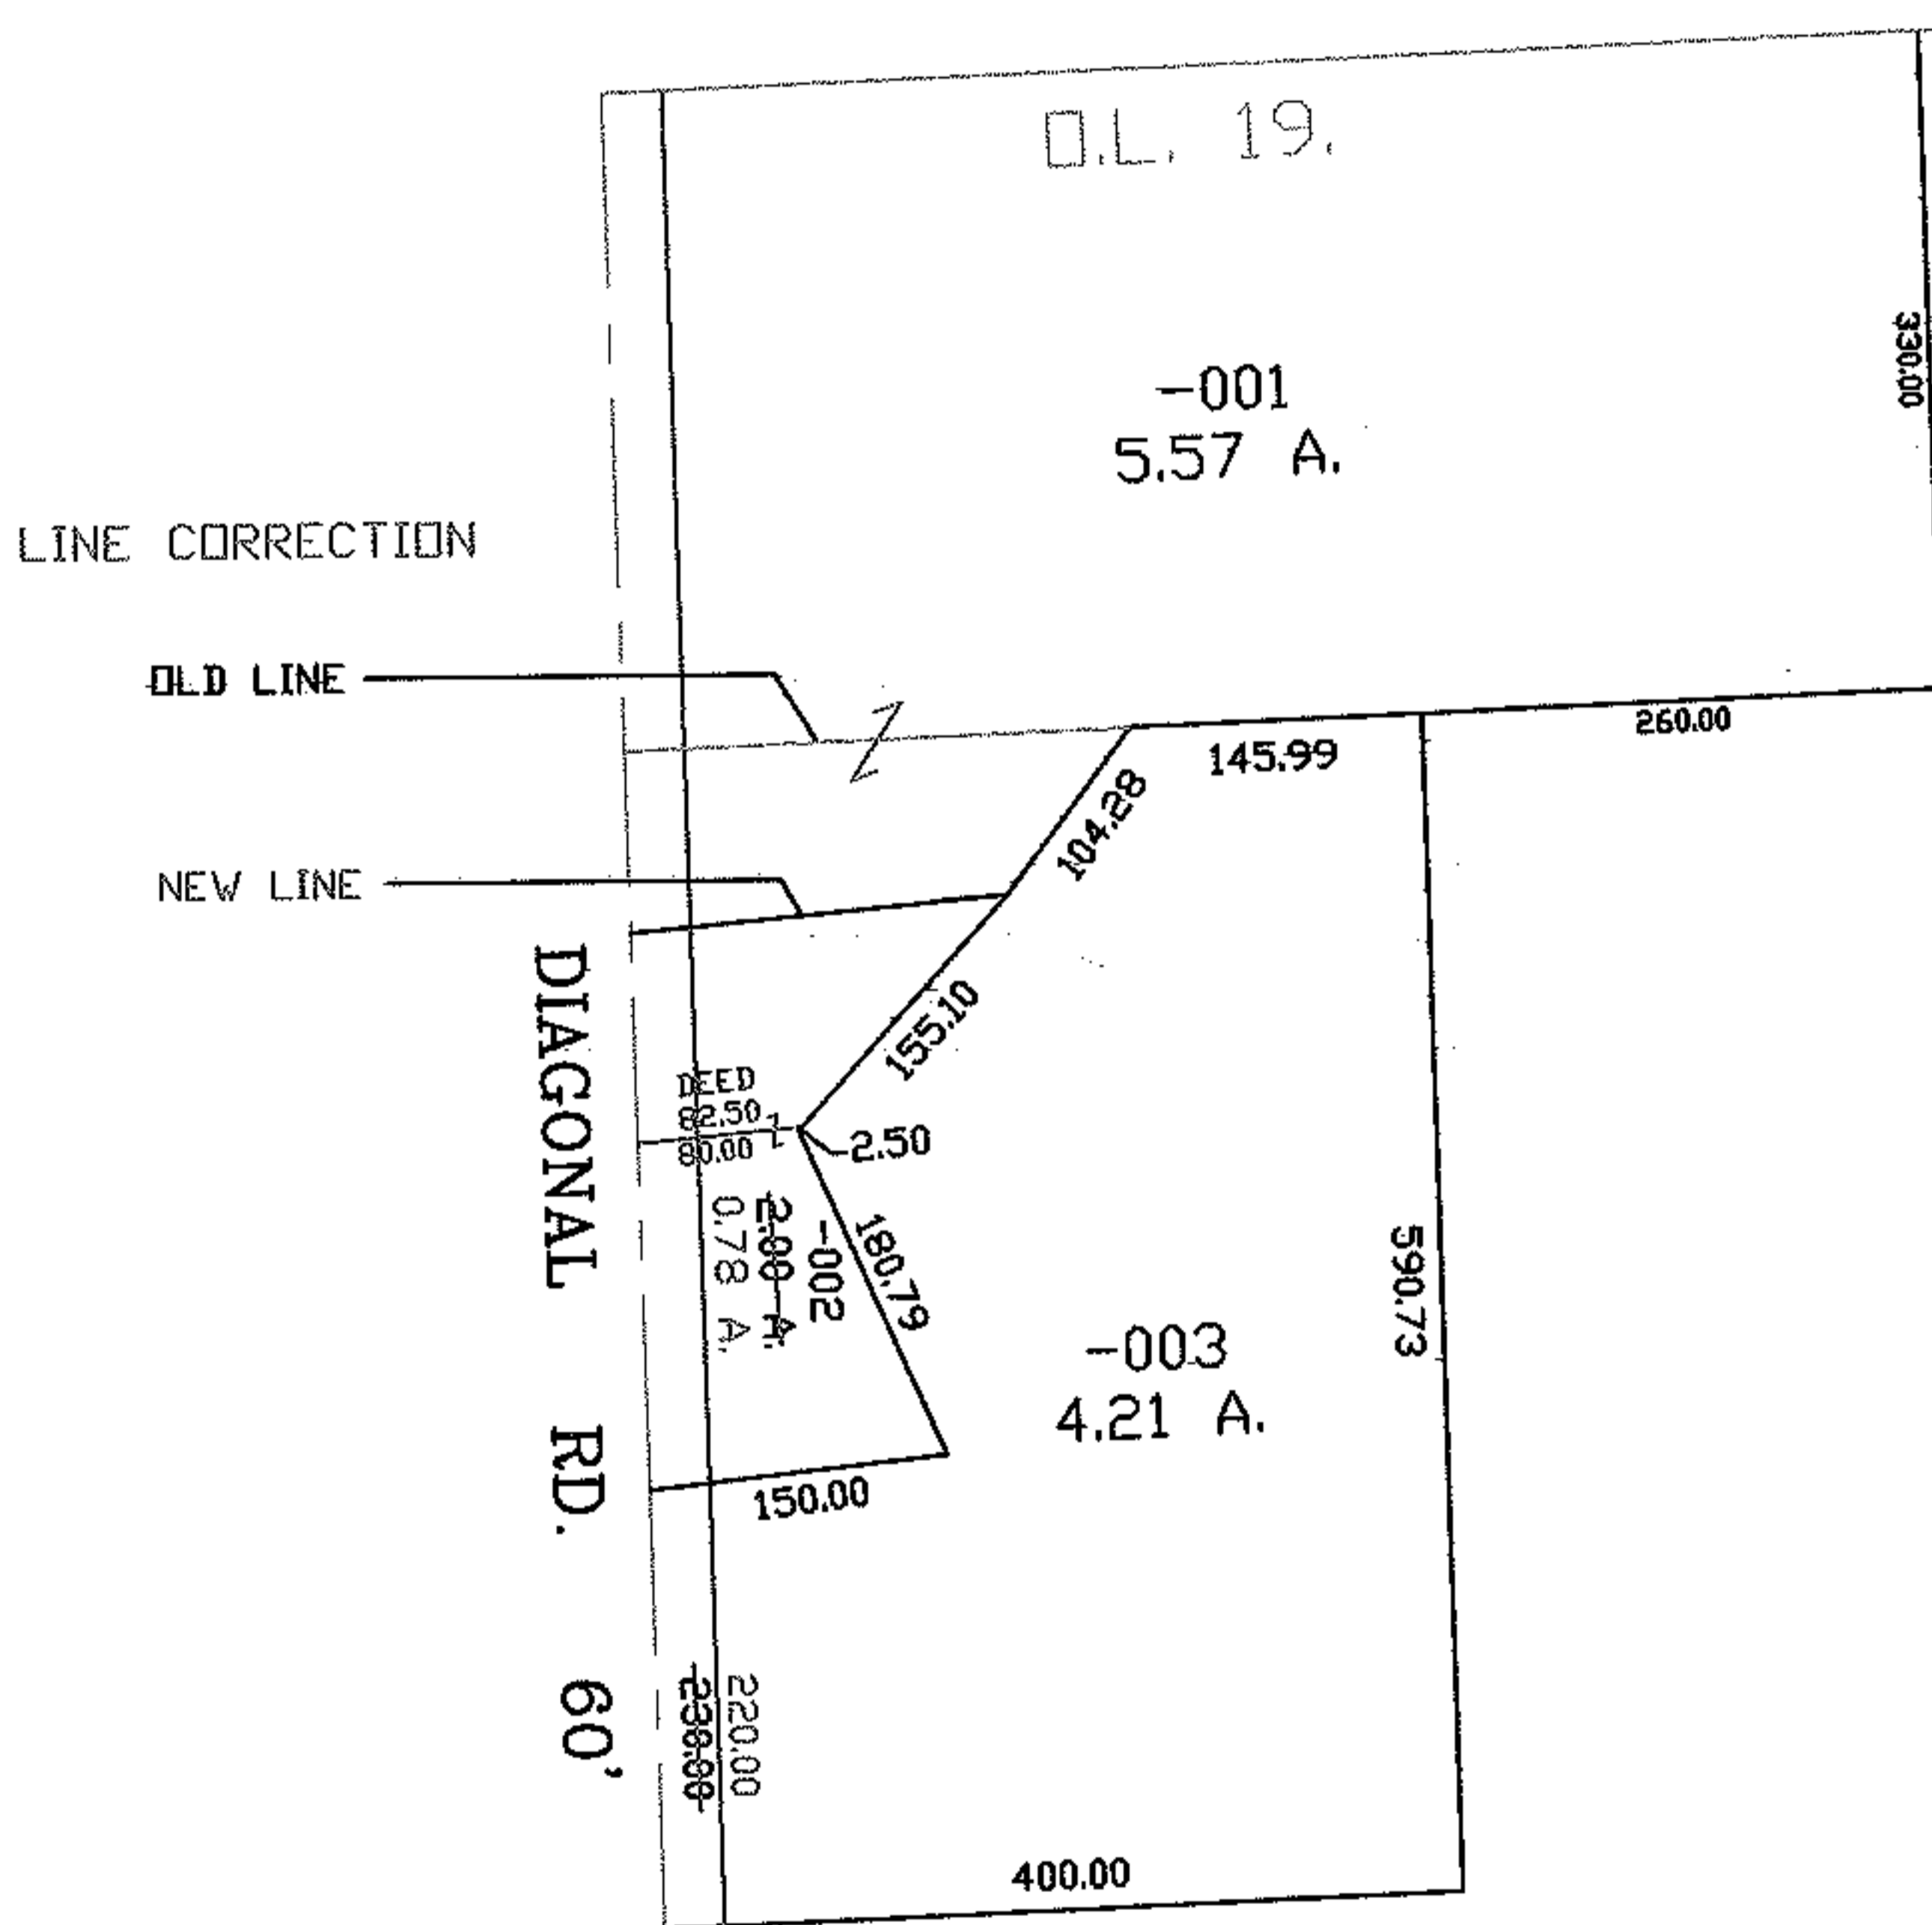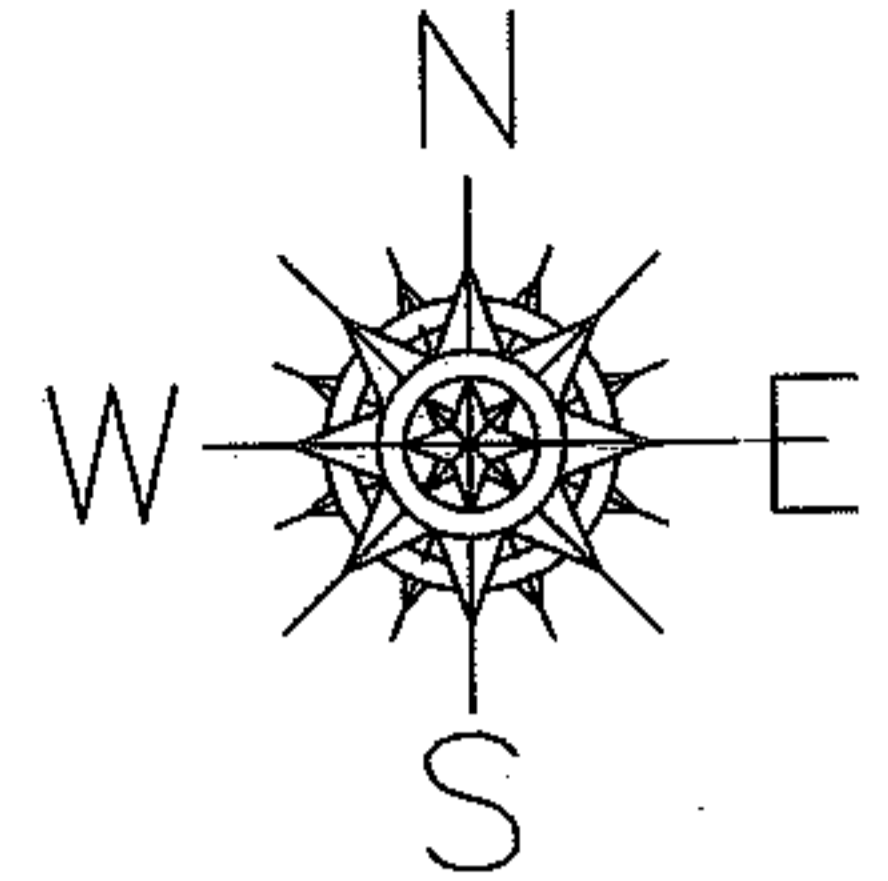

PRIOR INSTRUMENT: DV 1090/273

PRIOR INSTRUMENT: DV 88/335

PRIOR INSTRUMENT: DV 32/31

PRIOR INSTRUMENT: 2003-0972942

SURVEYED BY: XXXXXXXXXXXX

CLOSURE: XXXXXX

MAP PAGE(S): 15-A

APPROVED BY: TJS DATE: 2/29/08

SCALE: 1" = 200

SPLITS/DEEDS PROCESSED

LORAIN COUNTY TAX MAP DEPARTMENT  
226 MIDDLE AVE. ELYRIA, OHIO

