


PARENT PARCEL: 03-00-001-700-004

CHILD PARCEL: --NONE--


STARTING POINT: MON. BOX, CL OF N. RIDGE RD. & CL OF ABBE RD.

08-01612-C

N. RIDGE RD. (DETROIT RD. - S.R. 254)

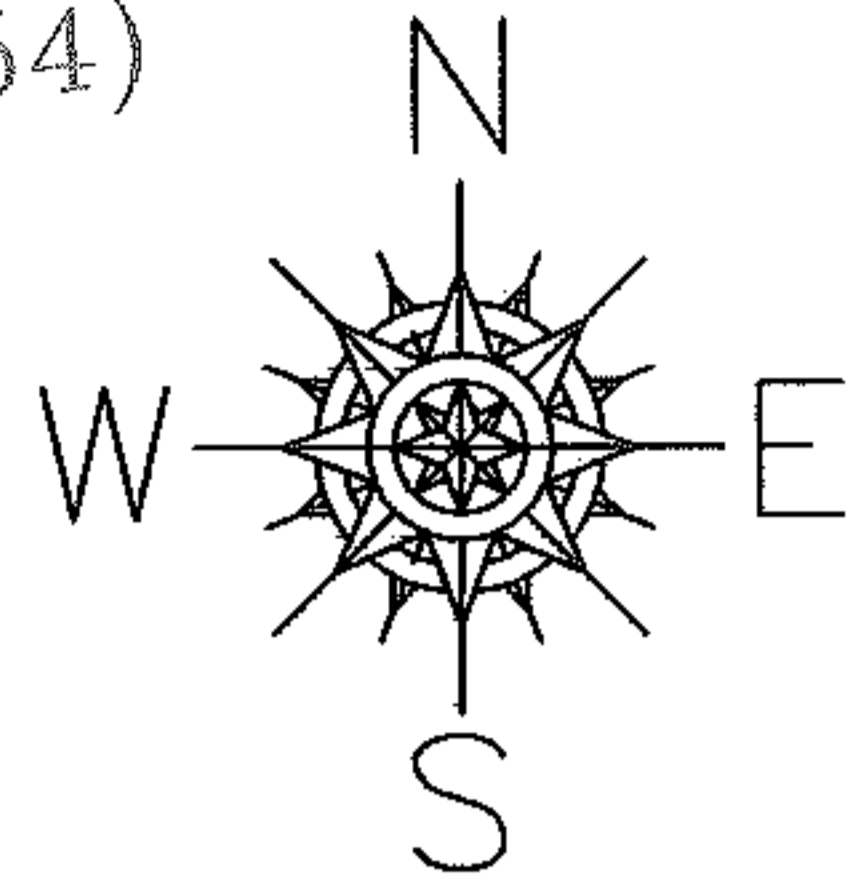


N. ABBE RD. (S.R. 301)

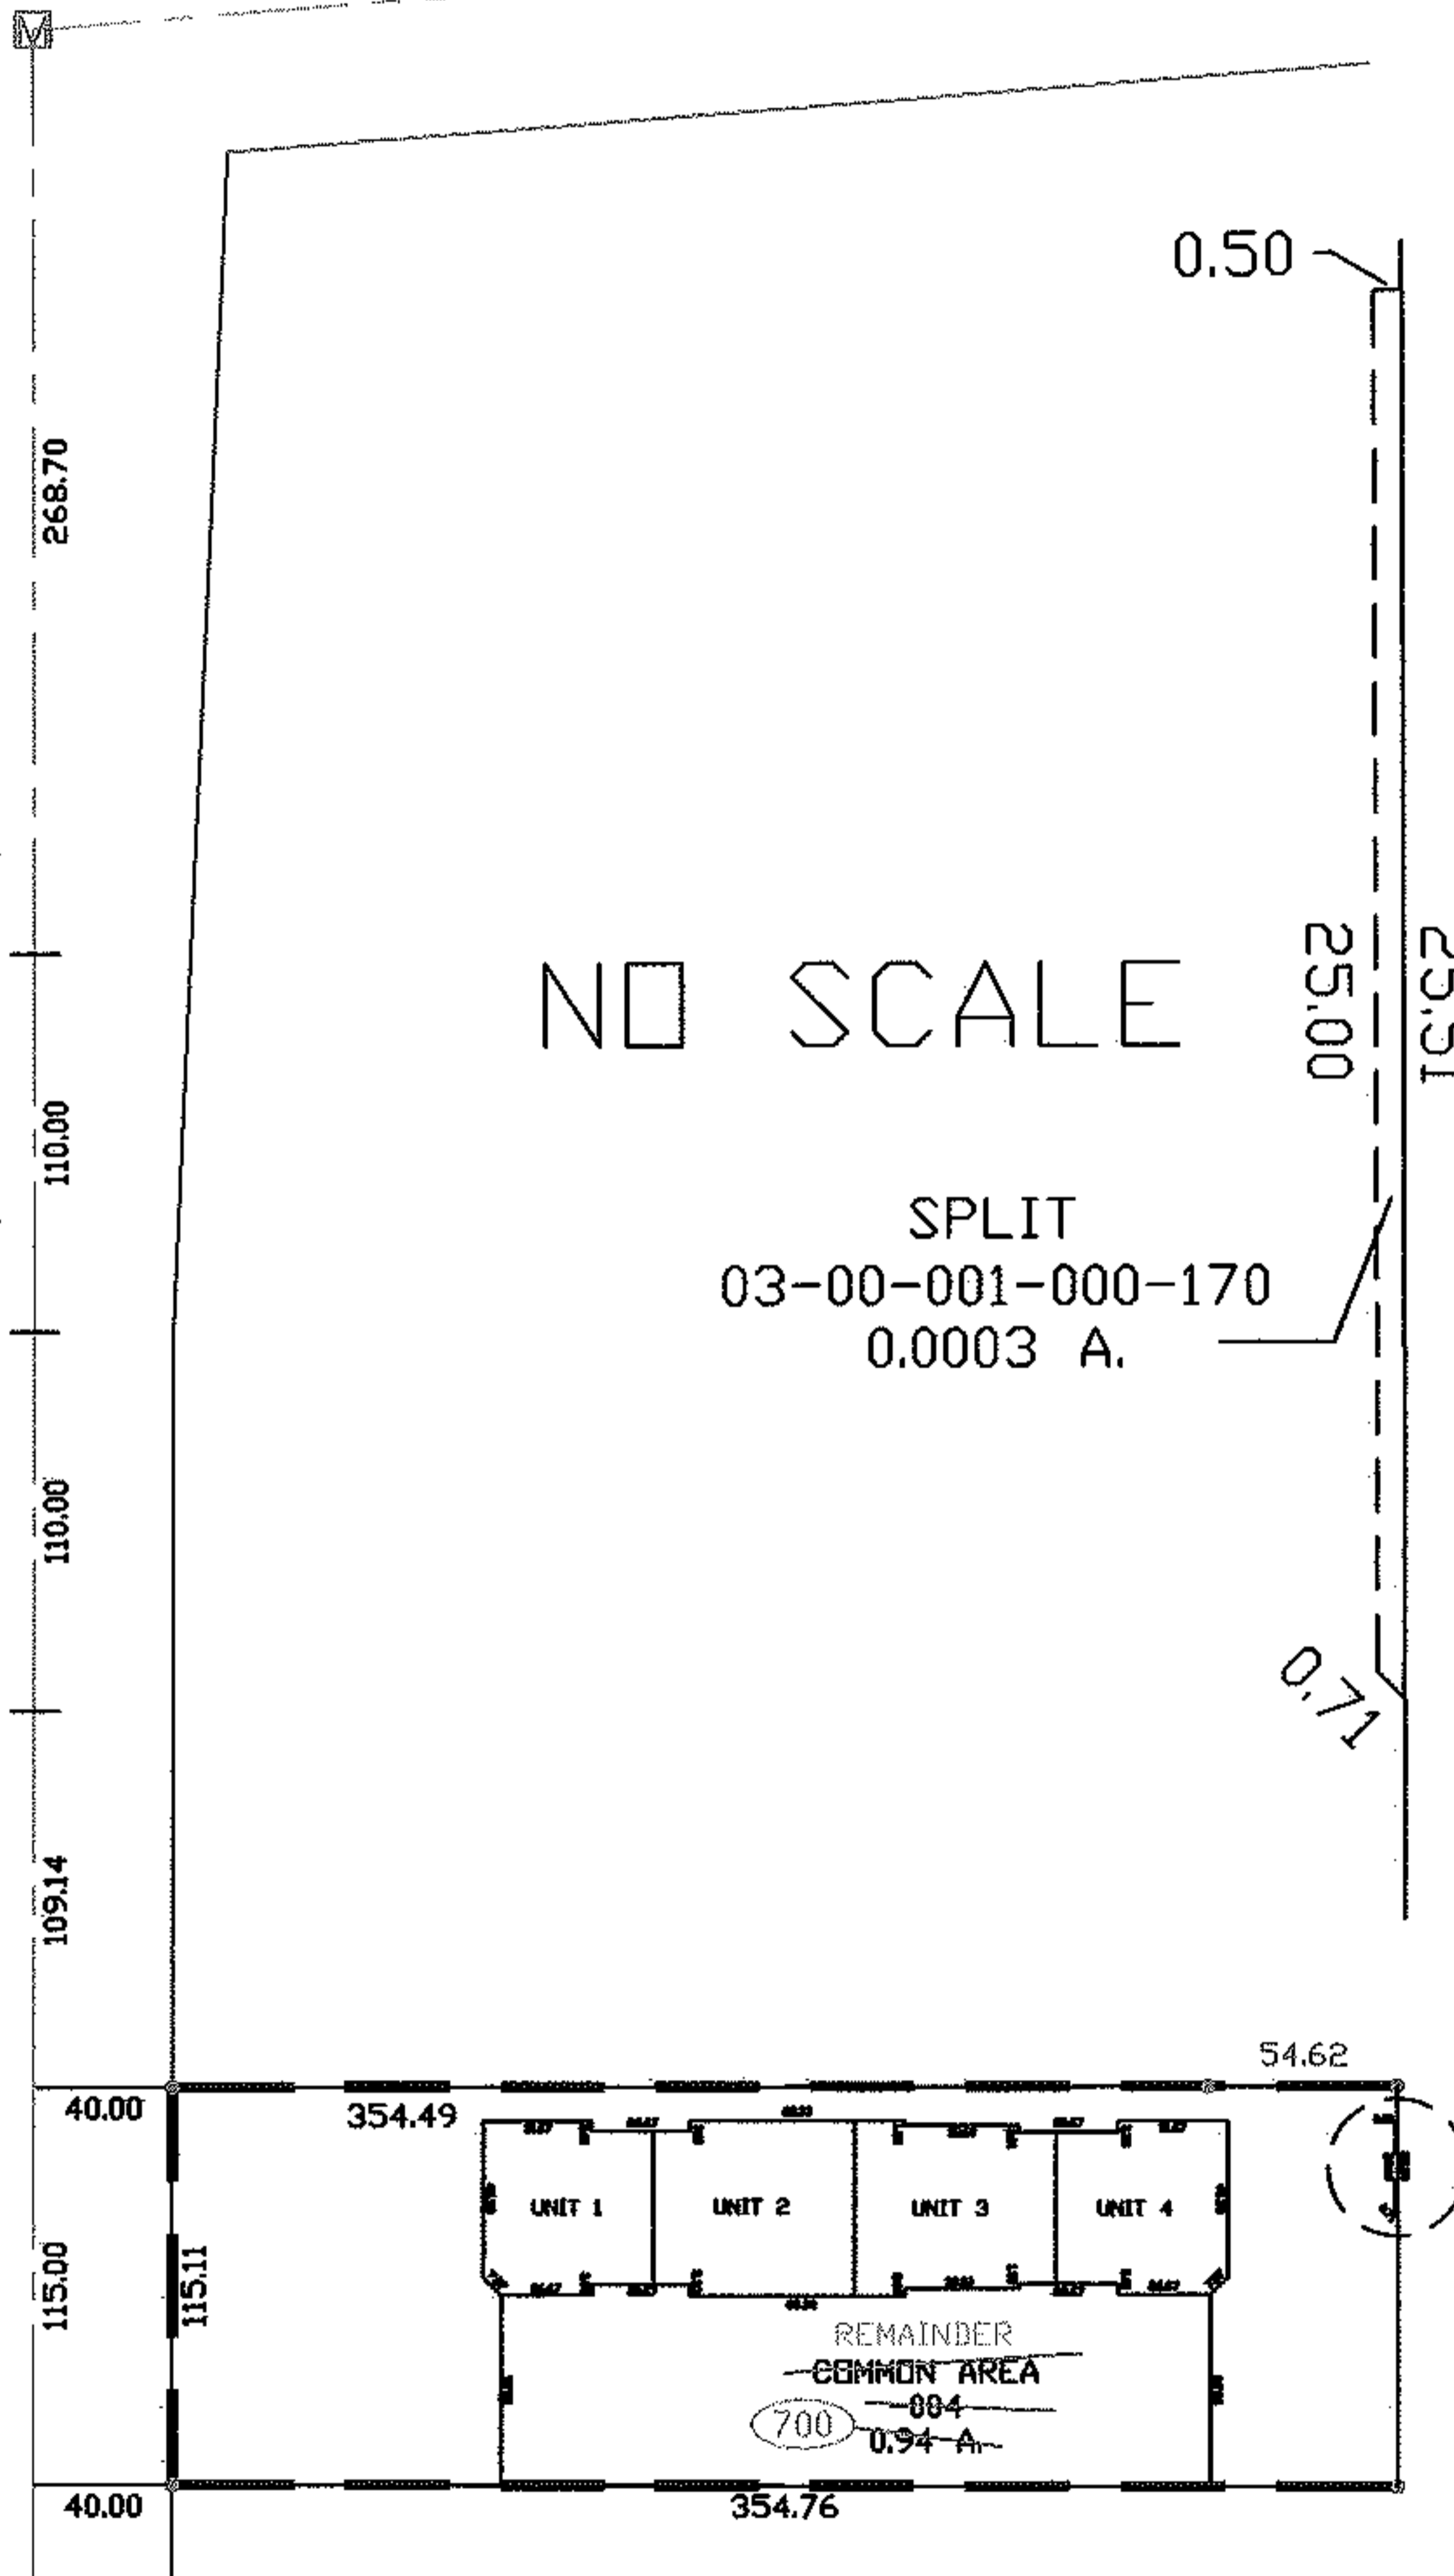

NO SCALE

SPLIT  
03-00-001-000-170  
0.0003 A.

DROP FROM DUP  
03-00-001-700-004

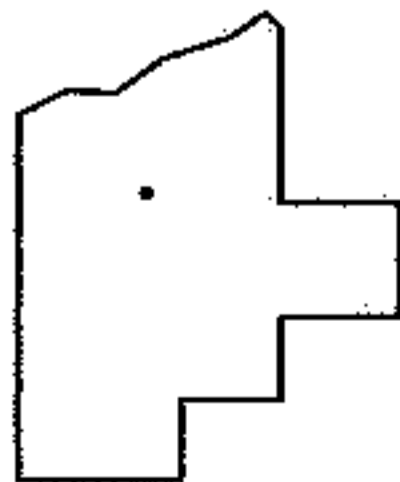

**SPLITS/DEEDS PROCESSED**  
LORAIN COUNTY TAX MAP DEPARTMENT  
226 MIDDLE AVE. ELYRIA, OHIO

SURVEYED BY: DAVID L. ELWELL  
CLOSURE: 0.01 : 10.000  
MAP PAGE(S): 3-00-001-A  
APPROVED BY: DRH DATE: 3/10/2008  
SCALE: 1" = 100 PRIOR INSTRUMENT: PV 73 P. 61-63