



PARENT PARCEL: CERTIFICATE OF CORR. AQUA MARINE CONDO. NO.1 PH. 1

CHILD PARCEL: XX-XX-XXX-XXX-XXX

STARTING POINT: XXXXXX

08-01613-X

**AQUA MARINE CONDOMINIUM NO. 1 PHASE 1
CERTIFICATE OF CORRECTION CHANGES**
BUILDING #6 GARAGE & PARKING SPACE NUMBERING CORRECTION
TO VOLUME 91 OF PLATS PAGE 13 OF LORAIN COUNTY RECORDS

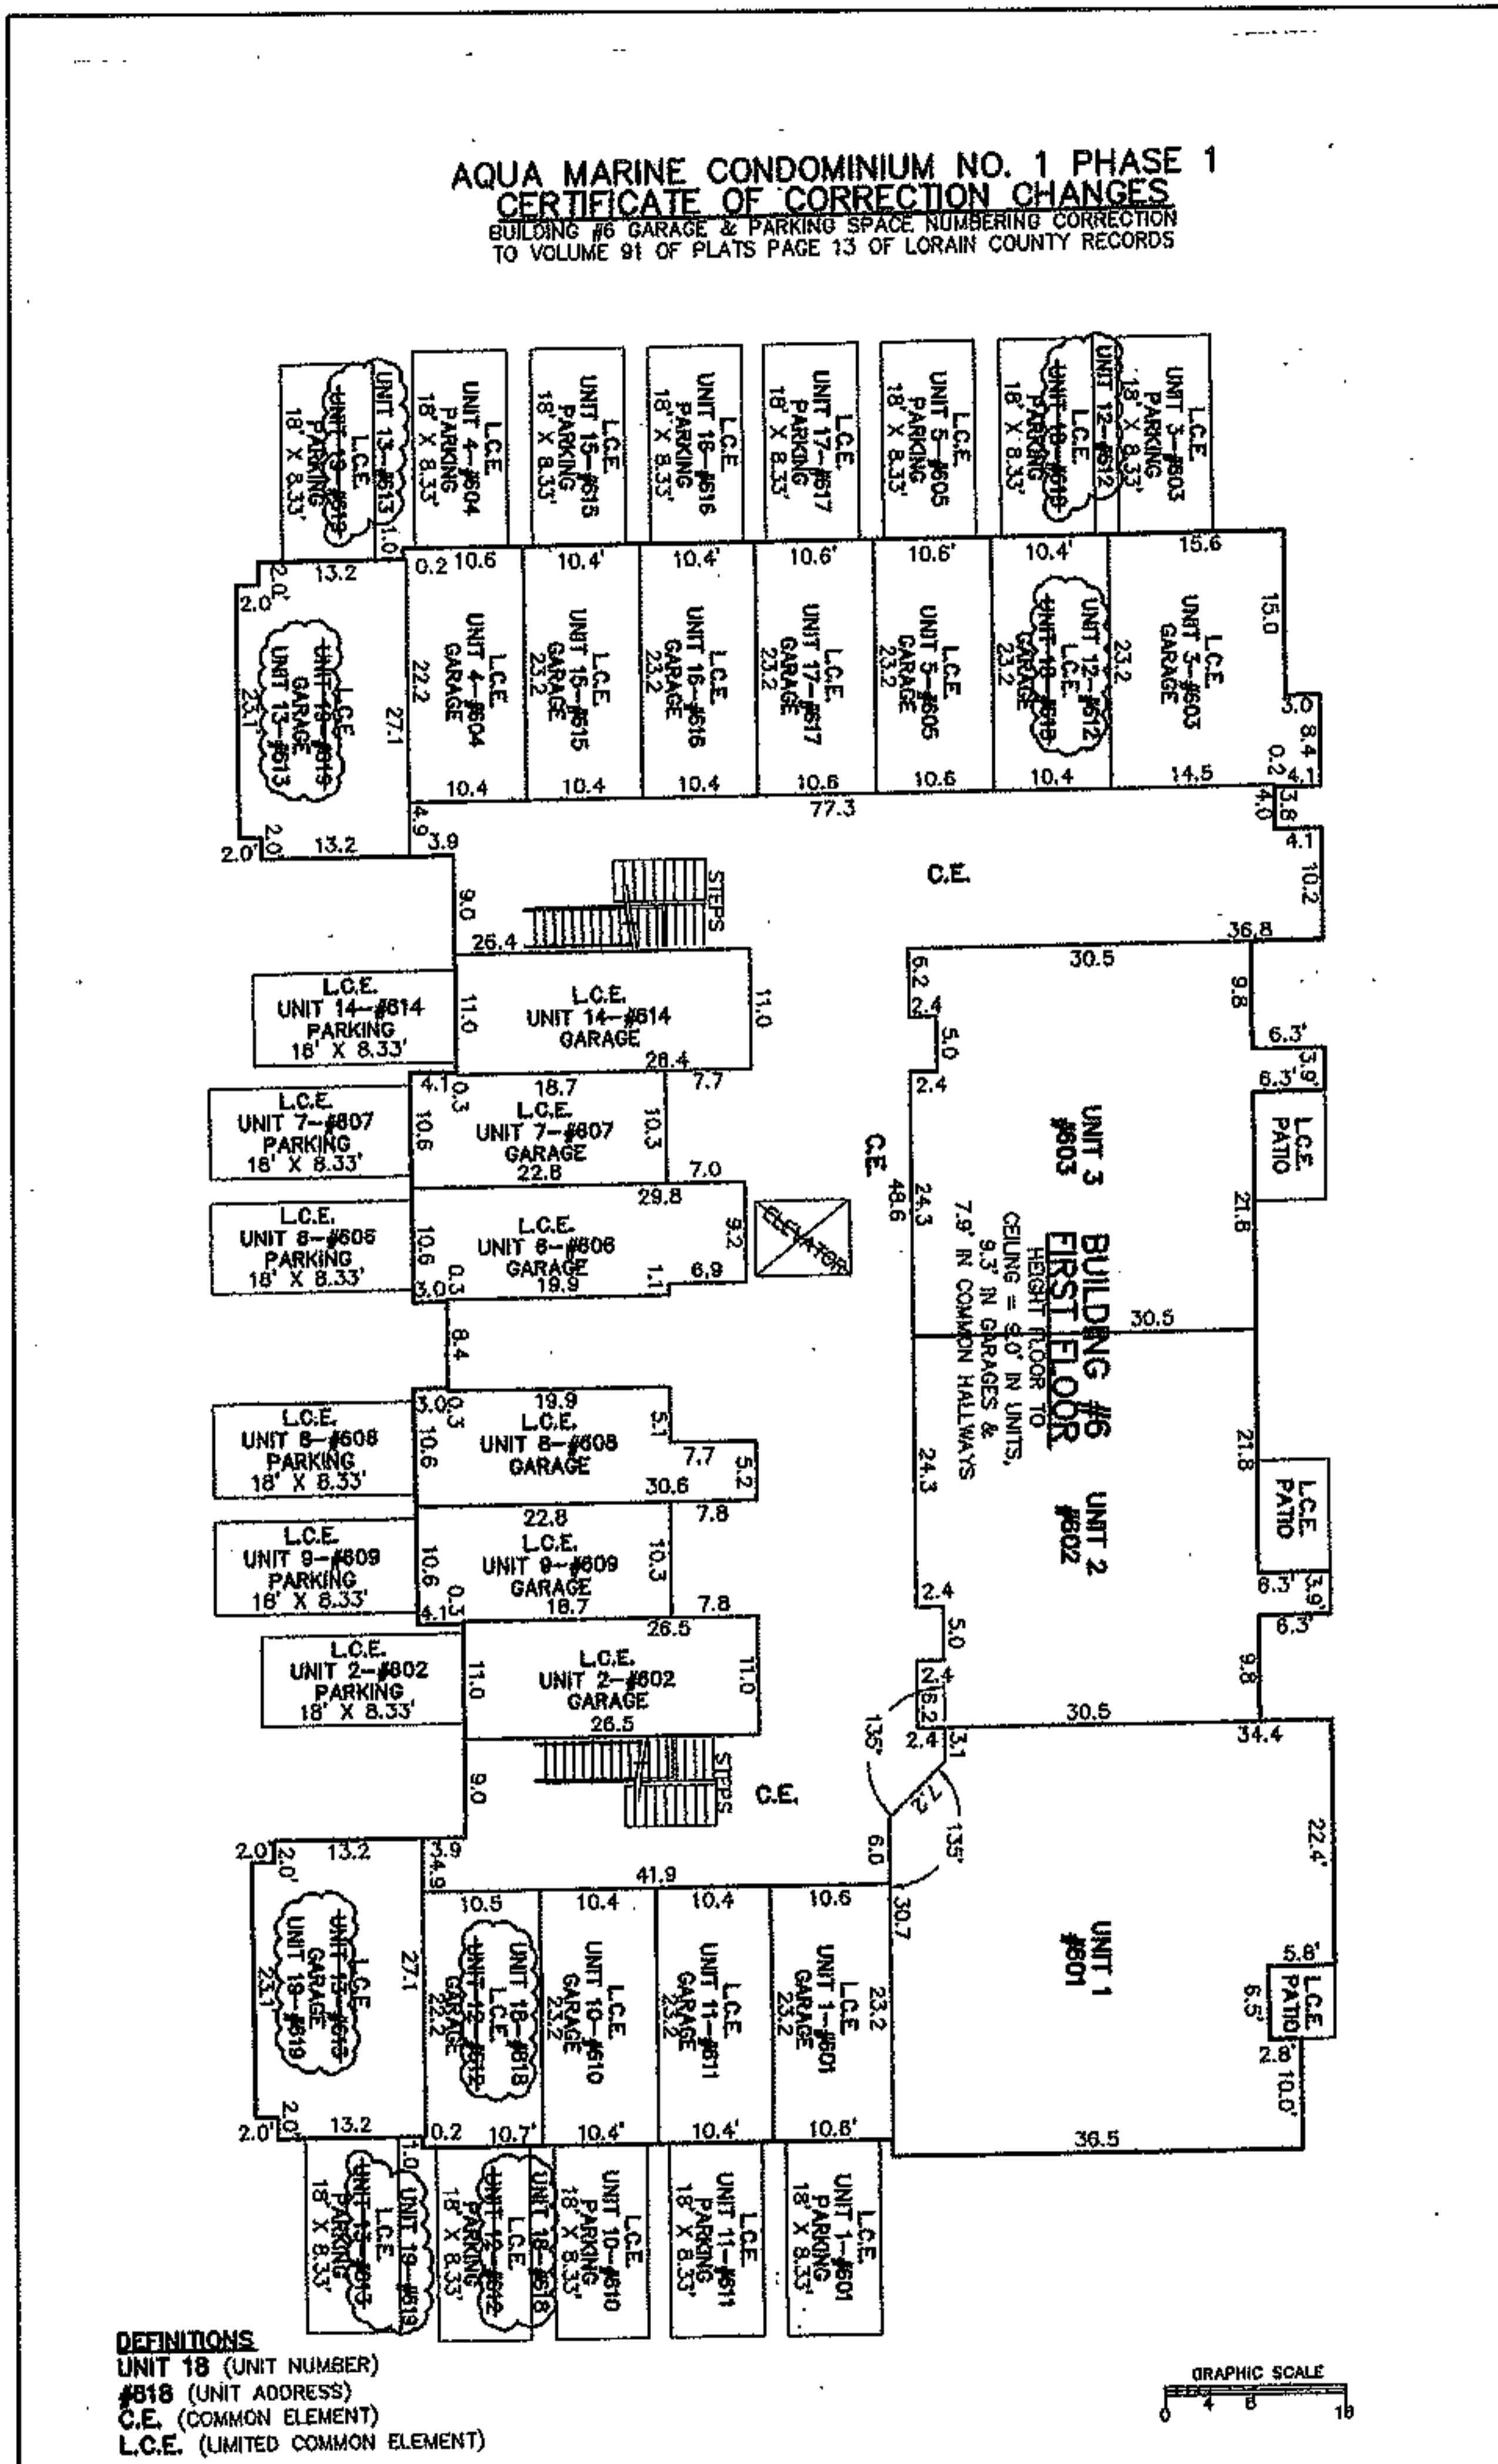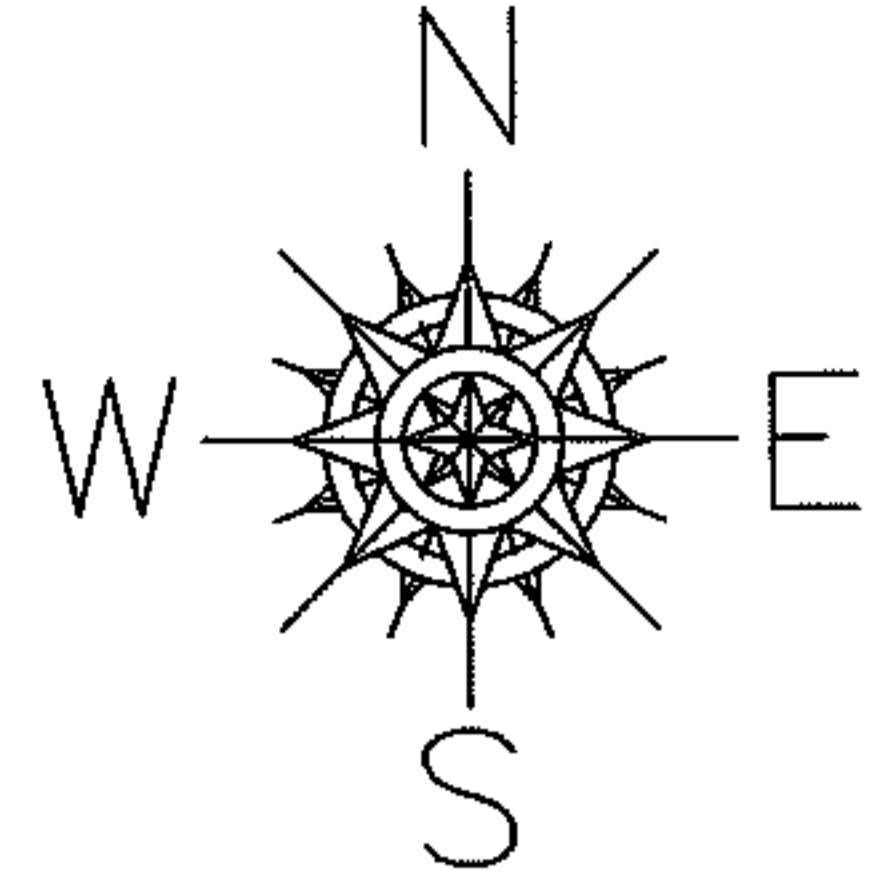

PG. 2 OF 4

DEFINITIONS
UNIT 18 (UNIT NUMBER)
#618 (UNIT ADDRESS)
C.E. (COMMON ELEMENT)
L.C.E. (LIMITED COMMON ELEMENT)



PRIOR INSTRUMENT: PV. 91 PG. 12-16

SPLITS/DEEDS PROCESSED

LORAIN COUNTY TAX MAP DEPARTMENT
226 MIDDLE AVE. ELYRIA, OHIO

SURVEYED BY: JAMES T. SAYLER

CLOSURE: XXXXXX

MAP PAGE(S): 04-00-006-E

APPROVED BY: TJS DATE: 3/10/08

SCALE: 1" = 100'