
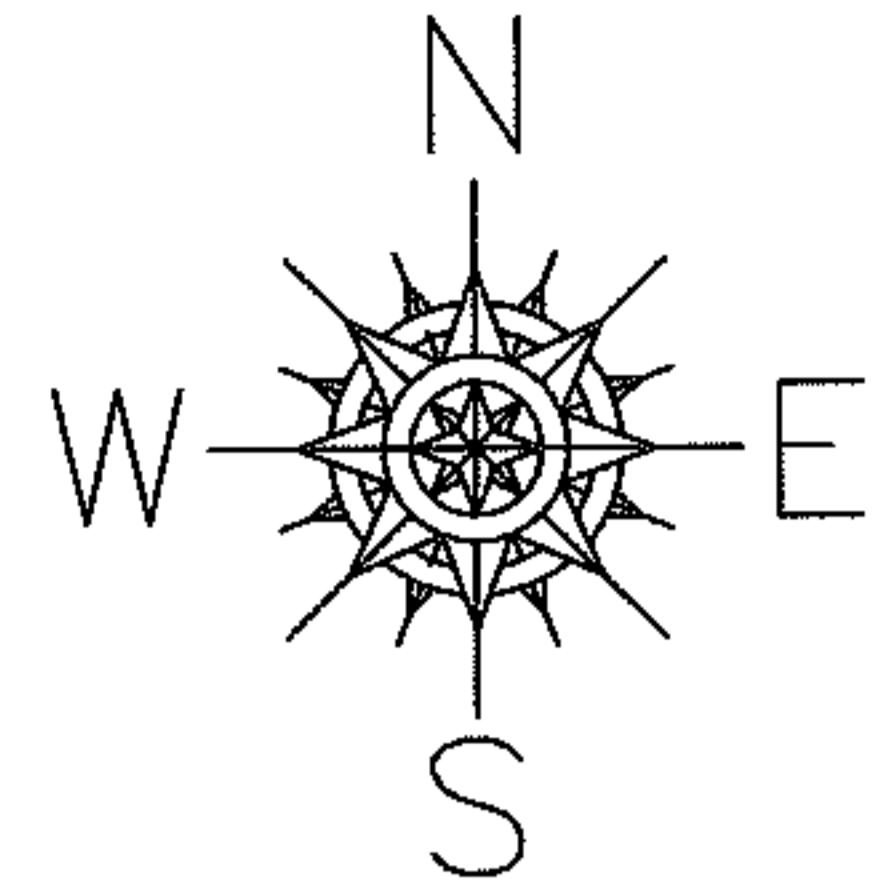


PARENT PARCEL: CERTIFICATE OF CORR. AQUA MARINE CONDO. NO.1 PH. 1

CHILD PARCEL: XX-XX-XXX-XXX-XXX

STARTING POINT: XXXXXX

08-01613-X

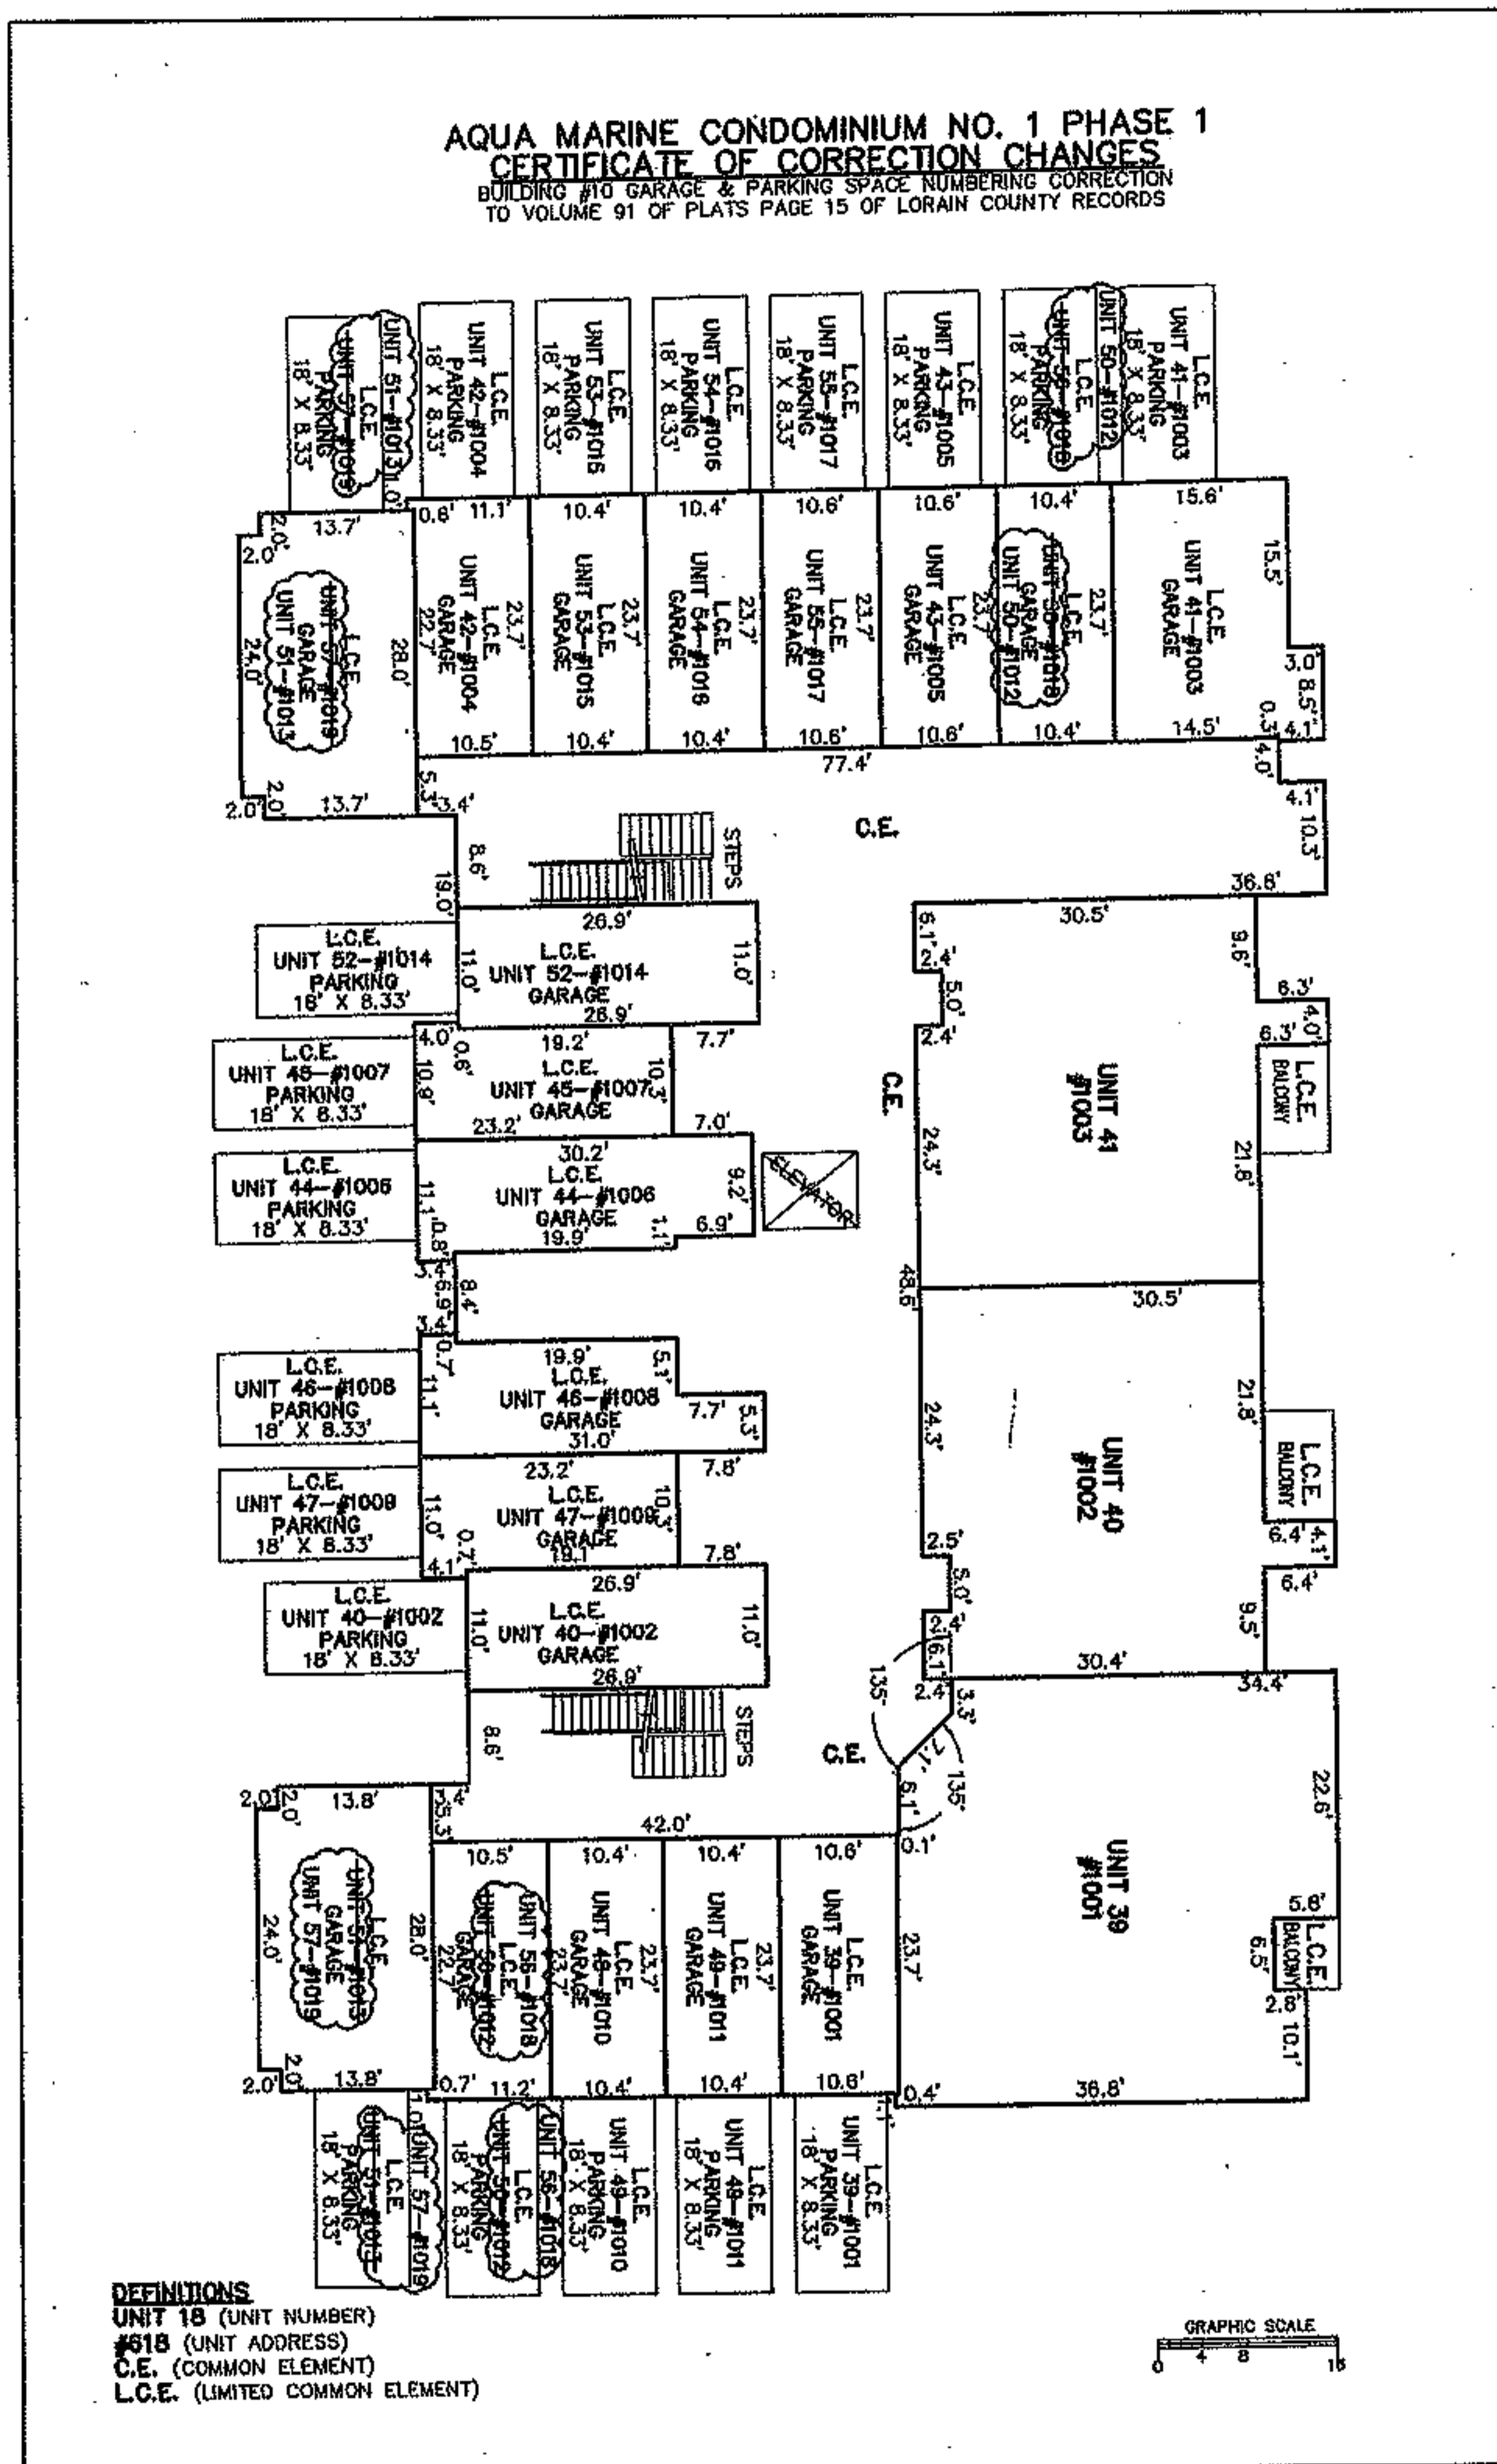

PG. 4 OF 4

PRIOR INSTRUMENT: PV. 91 PG. 12-16

SPLITS/DEEDS PROCESSED

LORAIN COUNTY TAX MAP DEPARTMENT
 226 MIDDLE AVE. ELYRIA, OHIO

SURVEYED BY: JAMES T. SAYLER

CLOSURE: XXXXXX

MAP PAGE(S): 04-00-006-E

APPROVED BY: TJS DATE: 3/10/08

SCALE: 1" = 100'