

RASTER




PARENT PARCEL: 03-00-075-106-007

08-01621-C

CHILD PARCEL: --SAME--

STARTING POINT:

AC. CORR. / MAP UPDATE
PER CALC

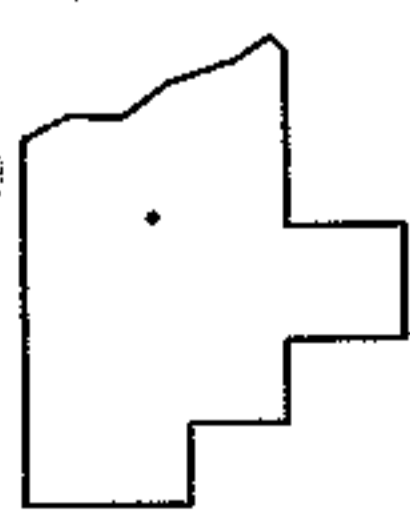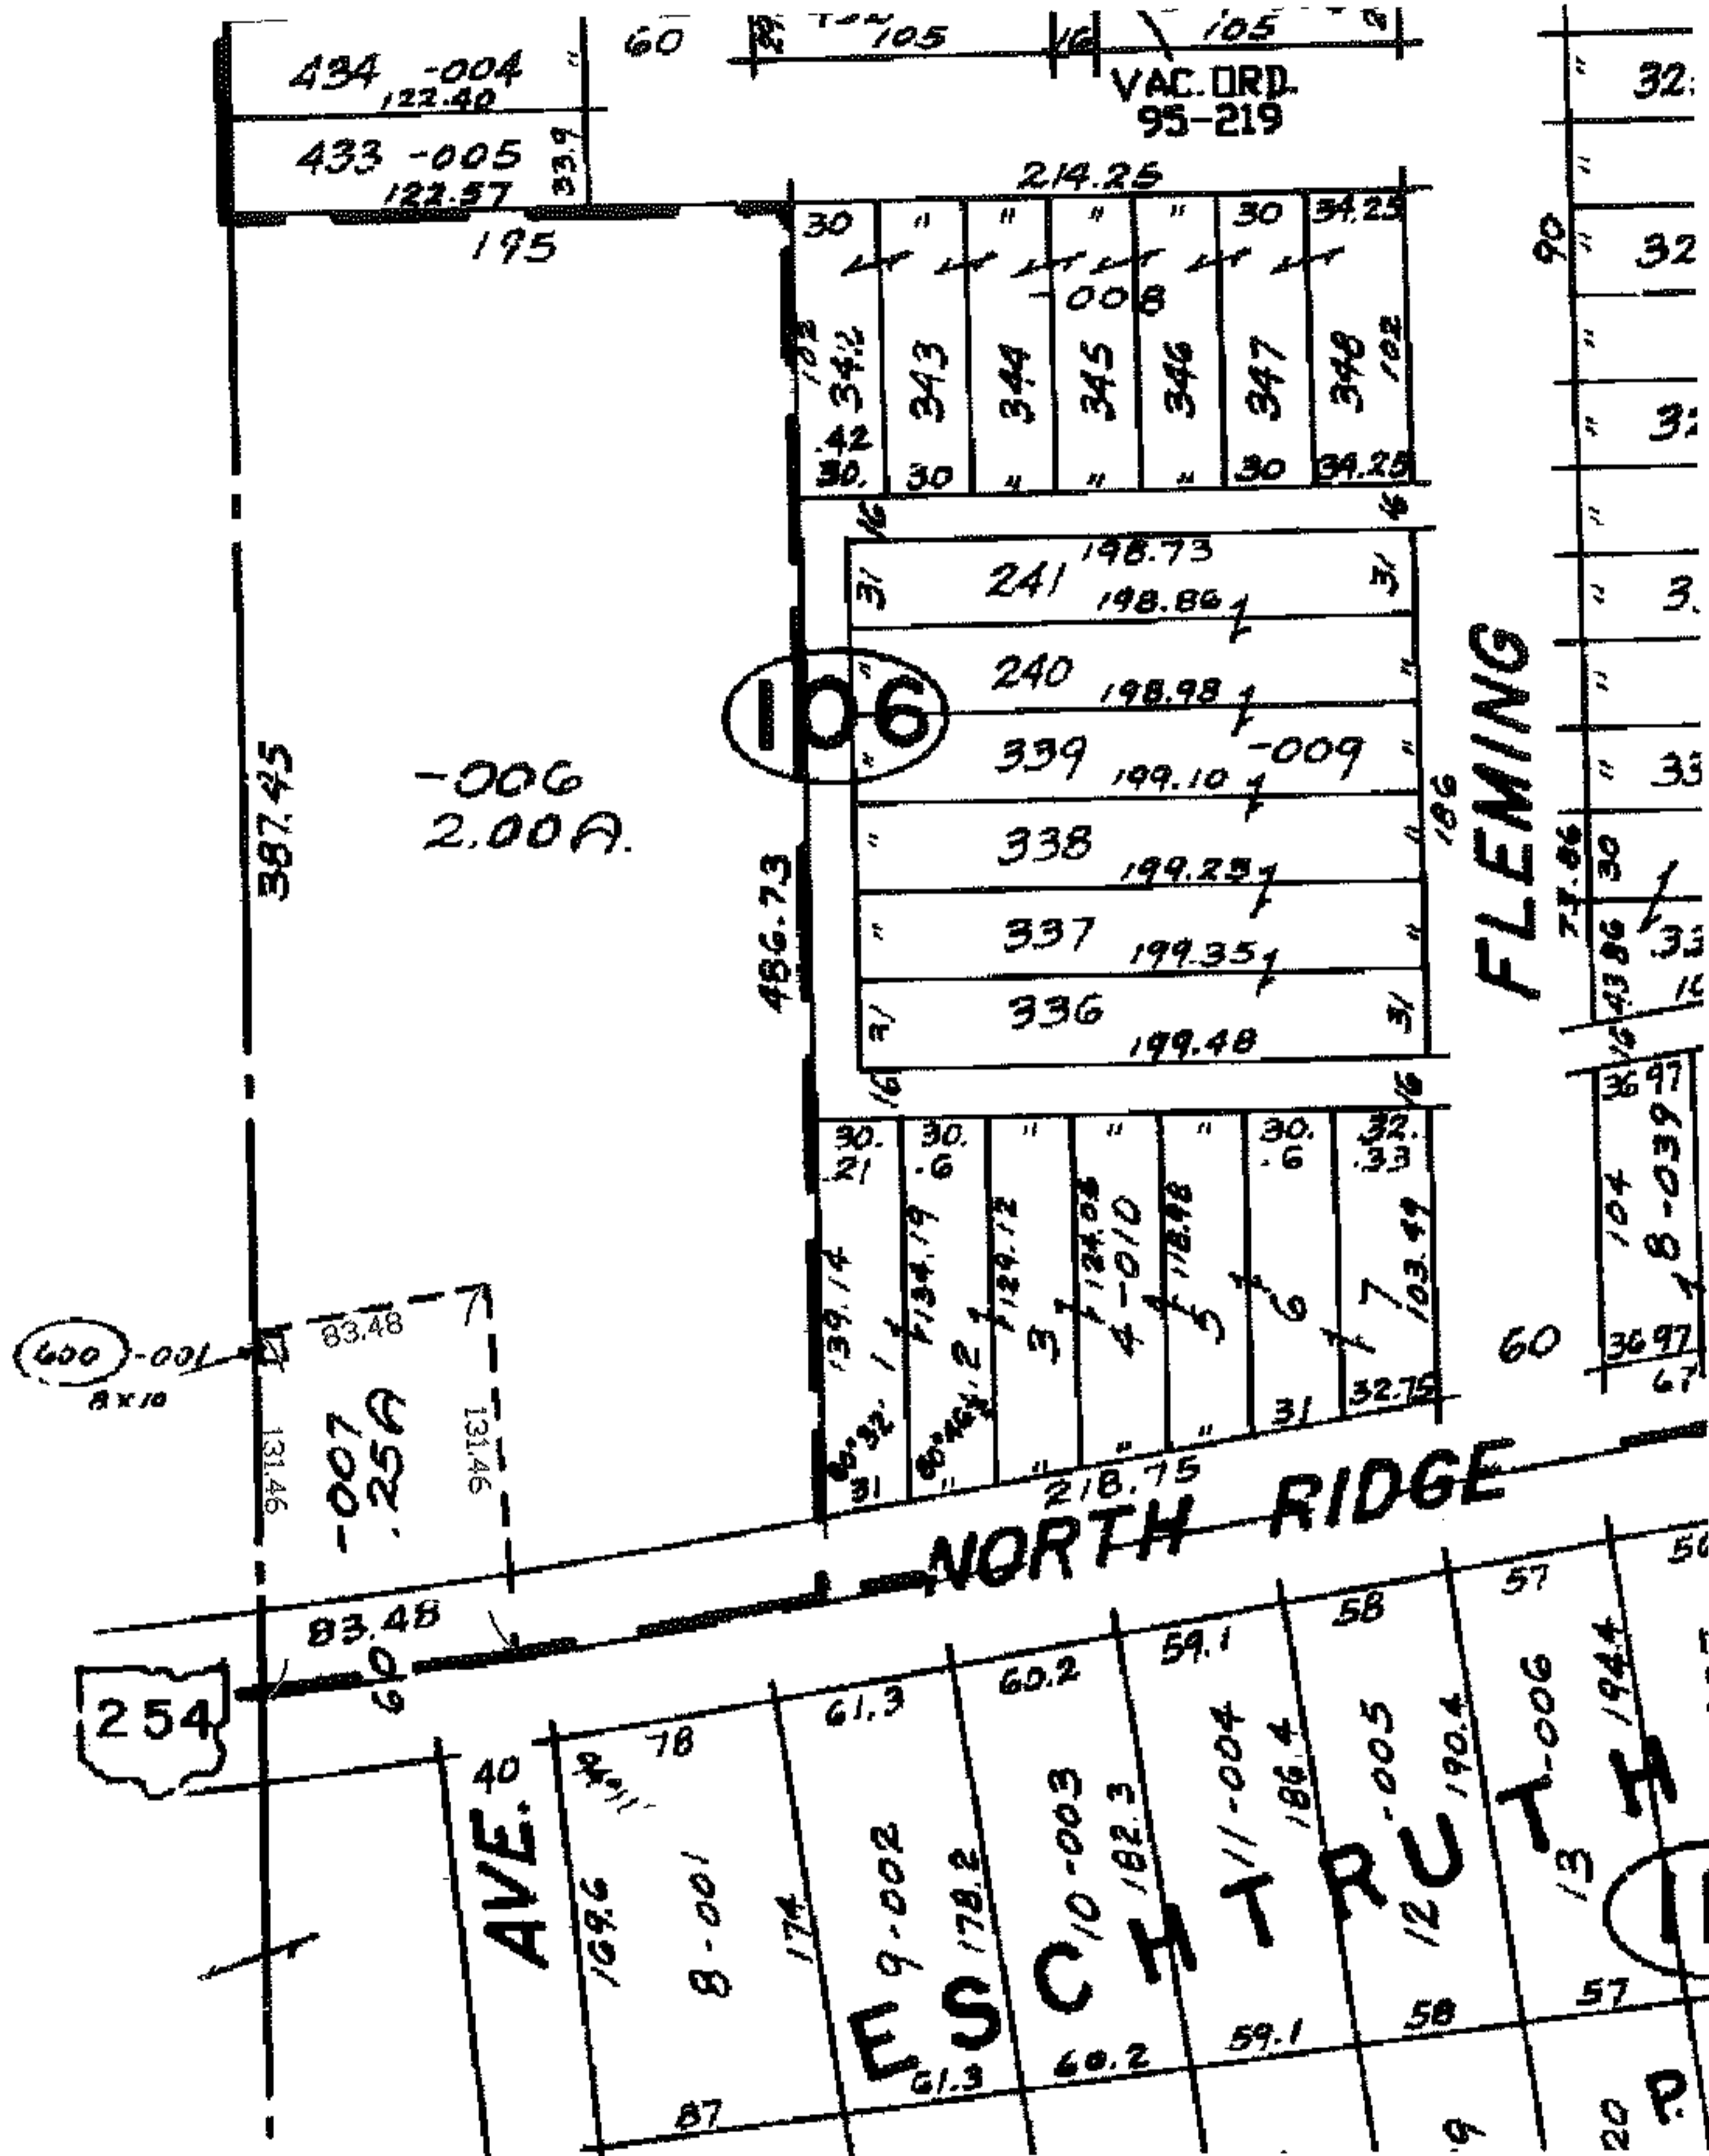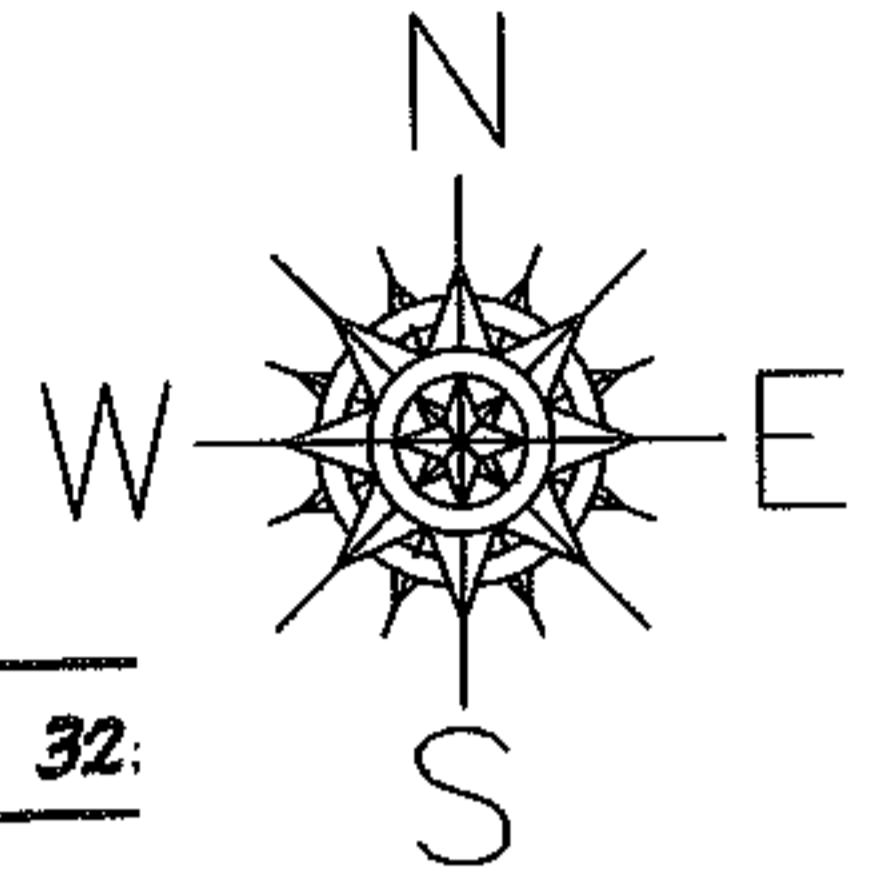

SPLITS/DEEDS PROCESSED
LORAIN COUNTY TAX MAP DEPARTMENT
 226 MIDDLE AVE. ELYRIA, OHIO

SURVEYED BY: N/A
 CLOSURE: N/A
 MAP PAGE(S): 03-00-075-A
 APPROVED BY: DRH DATE: 3/20/2008
 SCALE: NO TO SCALE PRIOR INSTRUMENT: 20010769301