


PARENT PARCEL: 04-00-006-135-094



CHILD PARCEL: --SAME--

STARTING POINT: SW CORNER OF BEACH PARK ALLOTMENT

08-01624-D

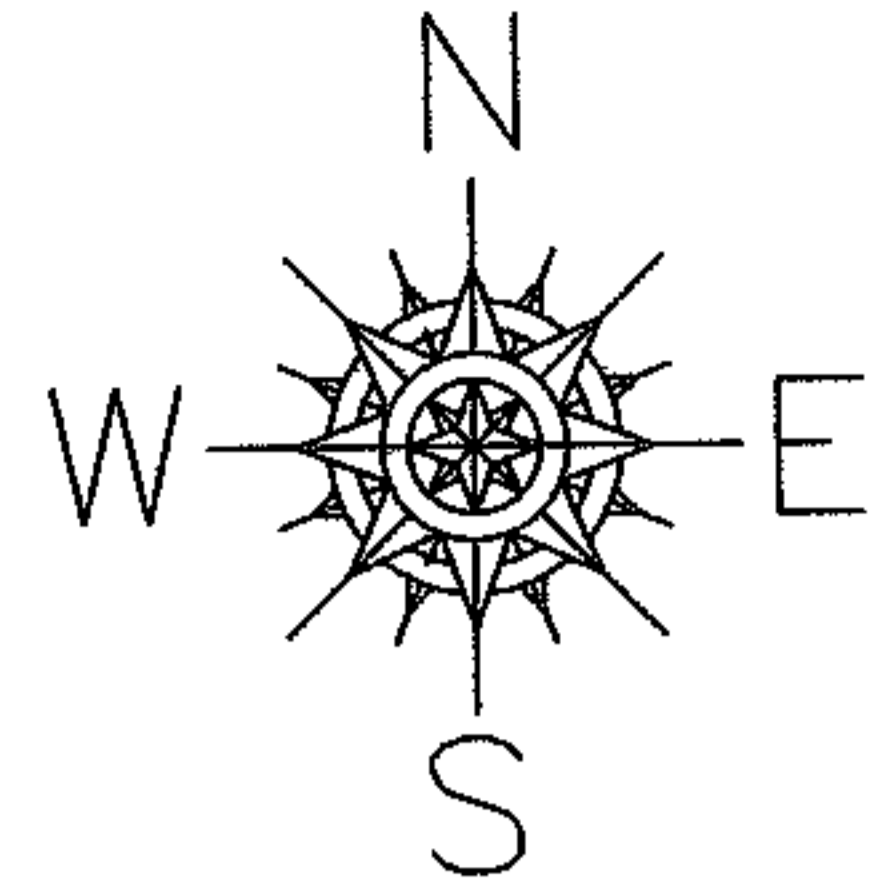

AC. CORR.
PER SURVEY
MICHAEL MACKAY

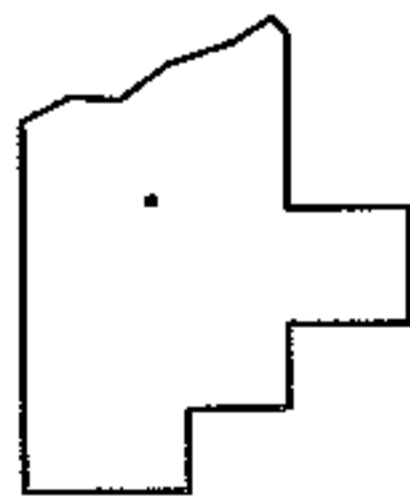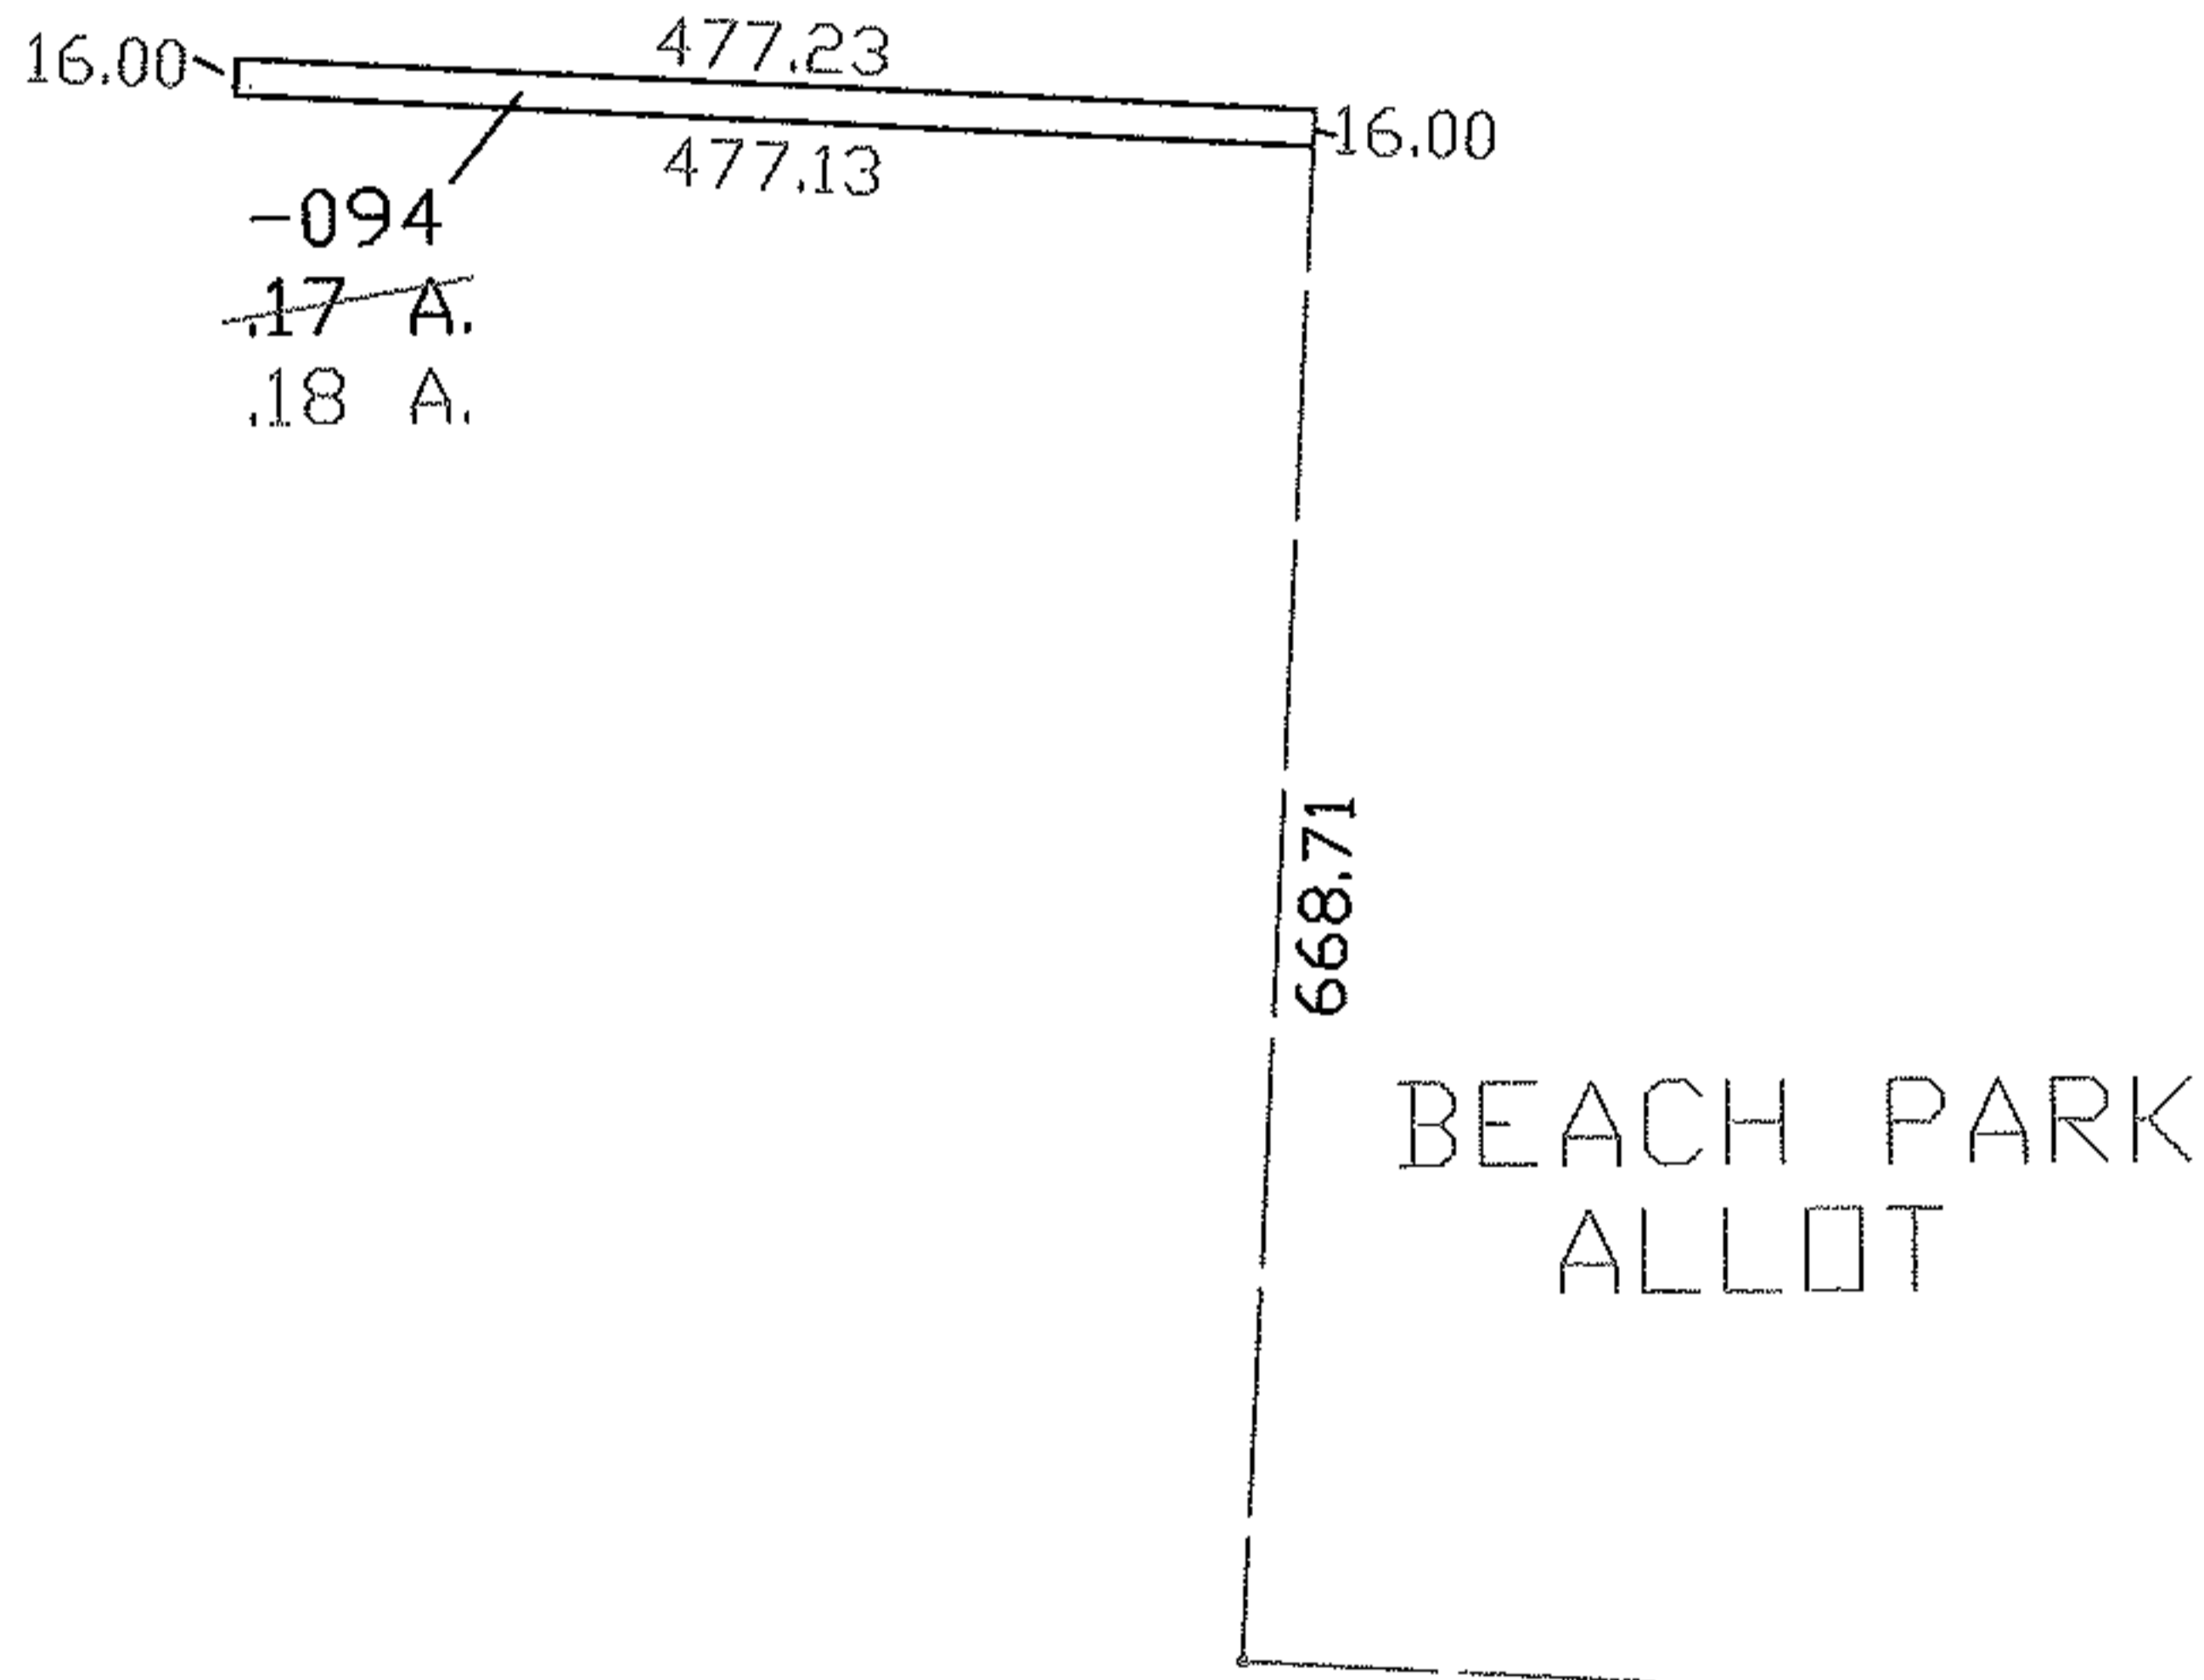

SPLITS/DEEDS PROCESSED
LORAIN COUNTY TAX MAP DEPARTMENT
226 MIDDLE AVE. ELYRIA, OHIO

SURVEYED BY: MICHAEL MACKAY
CLOSURE: 1:10,000
MAP PAGE(S): 04-00-006-D
APPROVED BY: DRH DATE: 3/24/2008
SCALE: 1" = 200' PRIOR INSTRUMENT: 20080016710