



RASTER

PARENT PARCEL: 10-00-015-108-051


CHILD PARCEL: 10-00-05-108-067 & -068

STARTING POINT: SE CORNER OF SL 125 OF BRENTWOOD ALLOTMENT NO. 2

08-01637-C

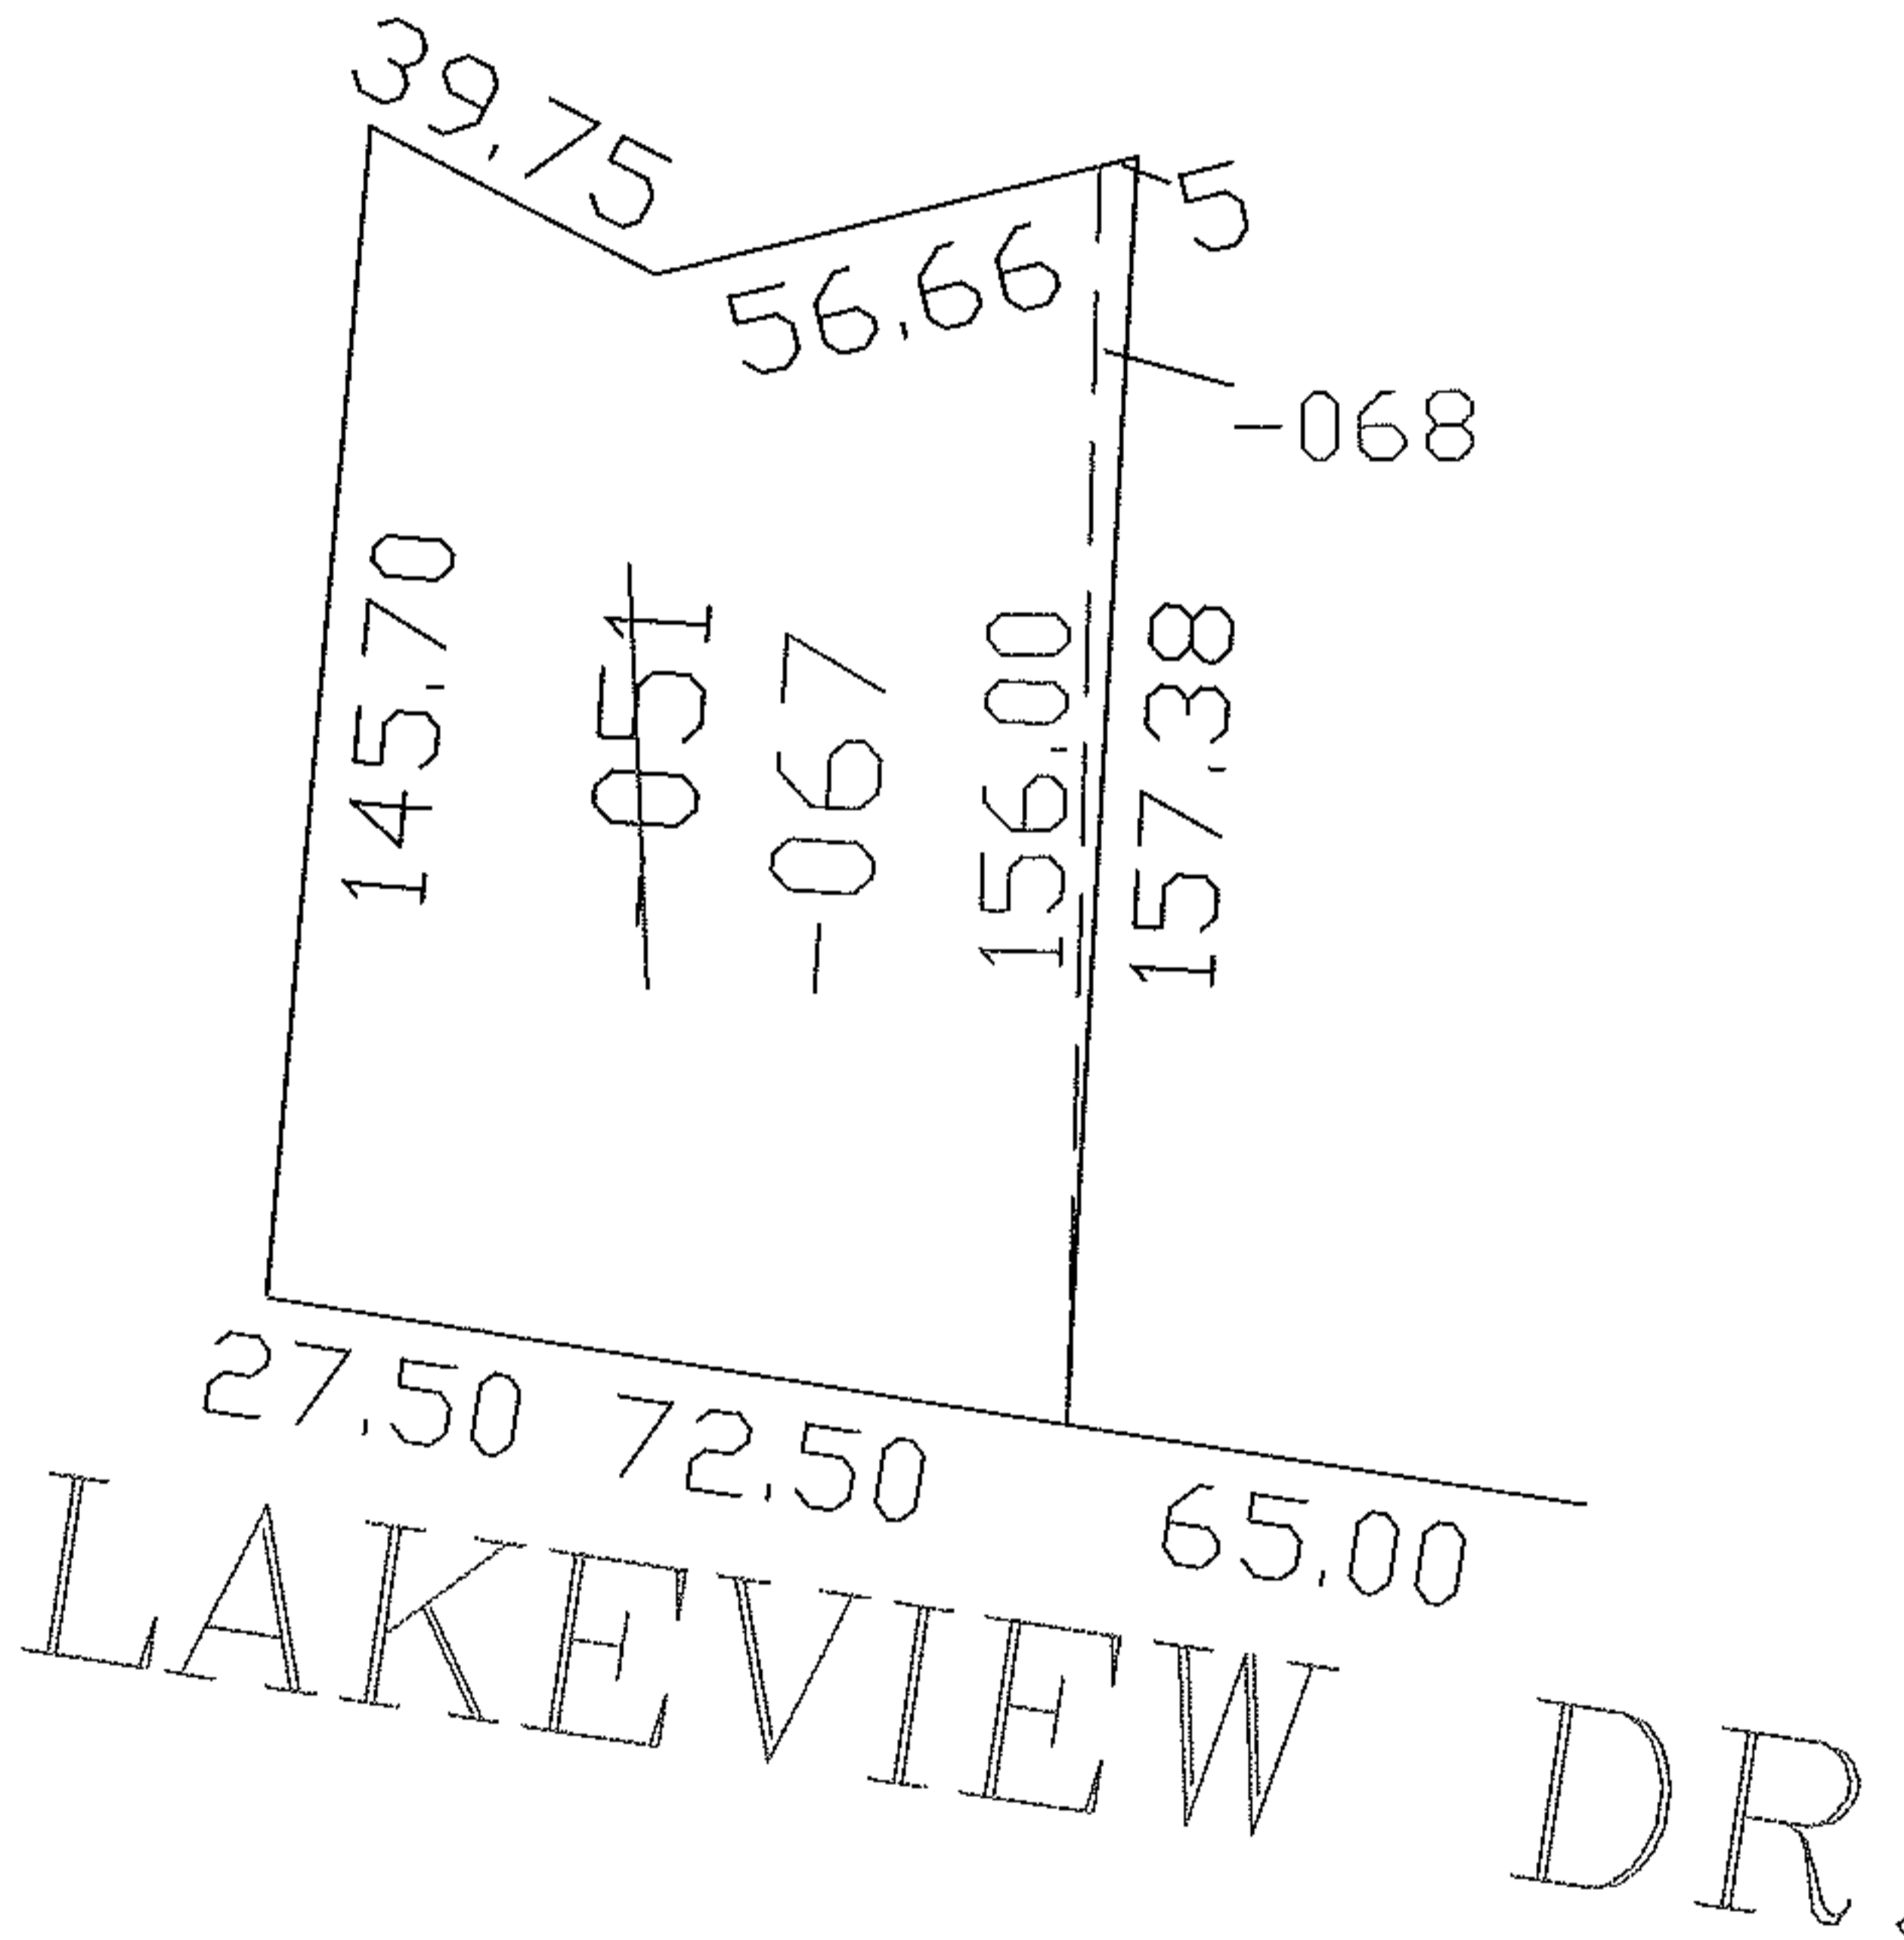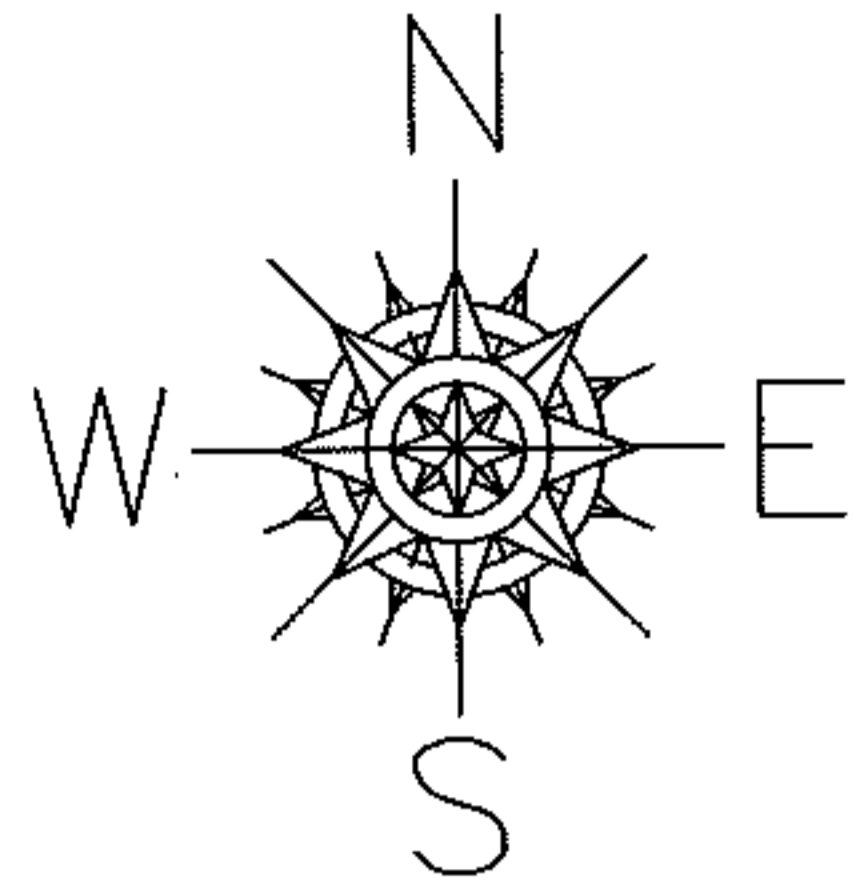

UNCOMBINATION

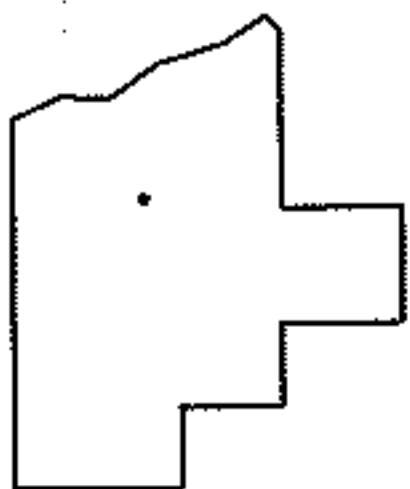

SPLITS/DEEDS PROCESSED

LORAIN COUNTY TAX MAP DEPARTMENT
226 MIDDLE AVE. ELYRIA, OHIO

SURVEYED BY: J.W.WARDEN

CLOSURE: 1:10,000

MAP PAGE(S): 10-00-015-D

APPROVED BY: DRH DATE: 7/25/08

SCALE: 1" = 50' PRIOR INSTRUMENT: 20020810874