

RASTER




PARENT PARCEL: 07-00-028-101-069

08-01638-C

CHILD PARCEL: --SAME--

STARTING POINT: INT CL SCHAEFER DR AND RIDGEVILLE - LORAIN RD

AC. CORR.
PER STREET DEDICATION
V 24/7

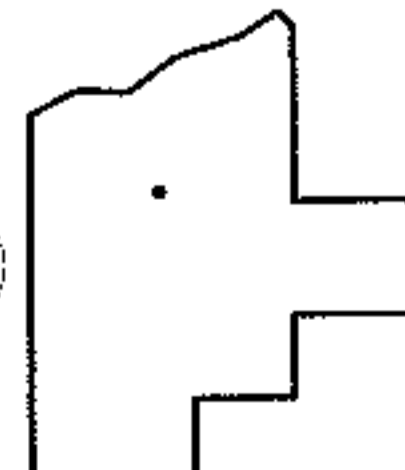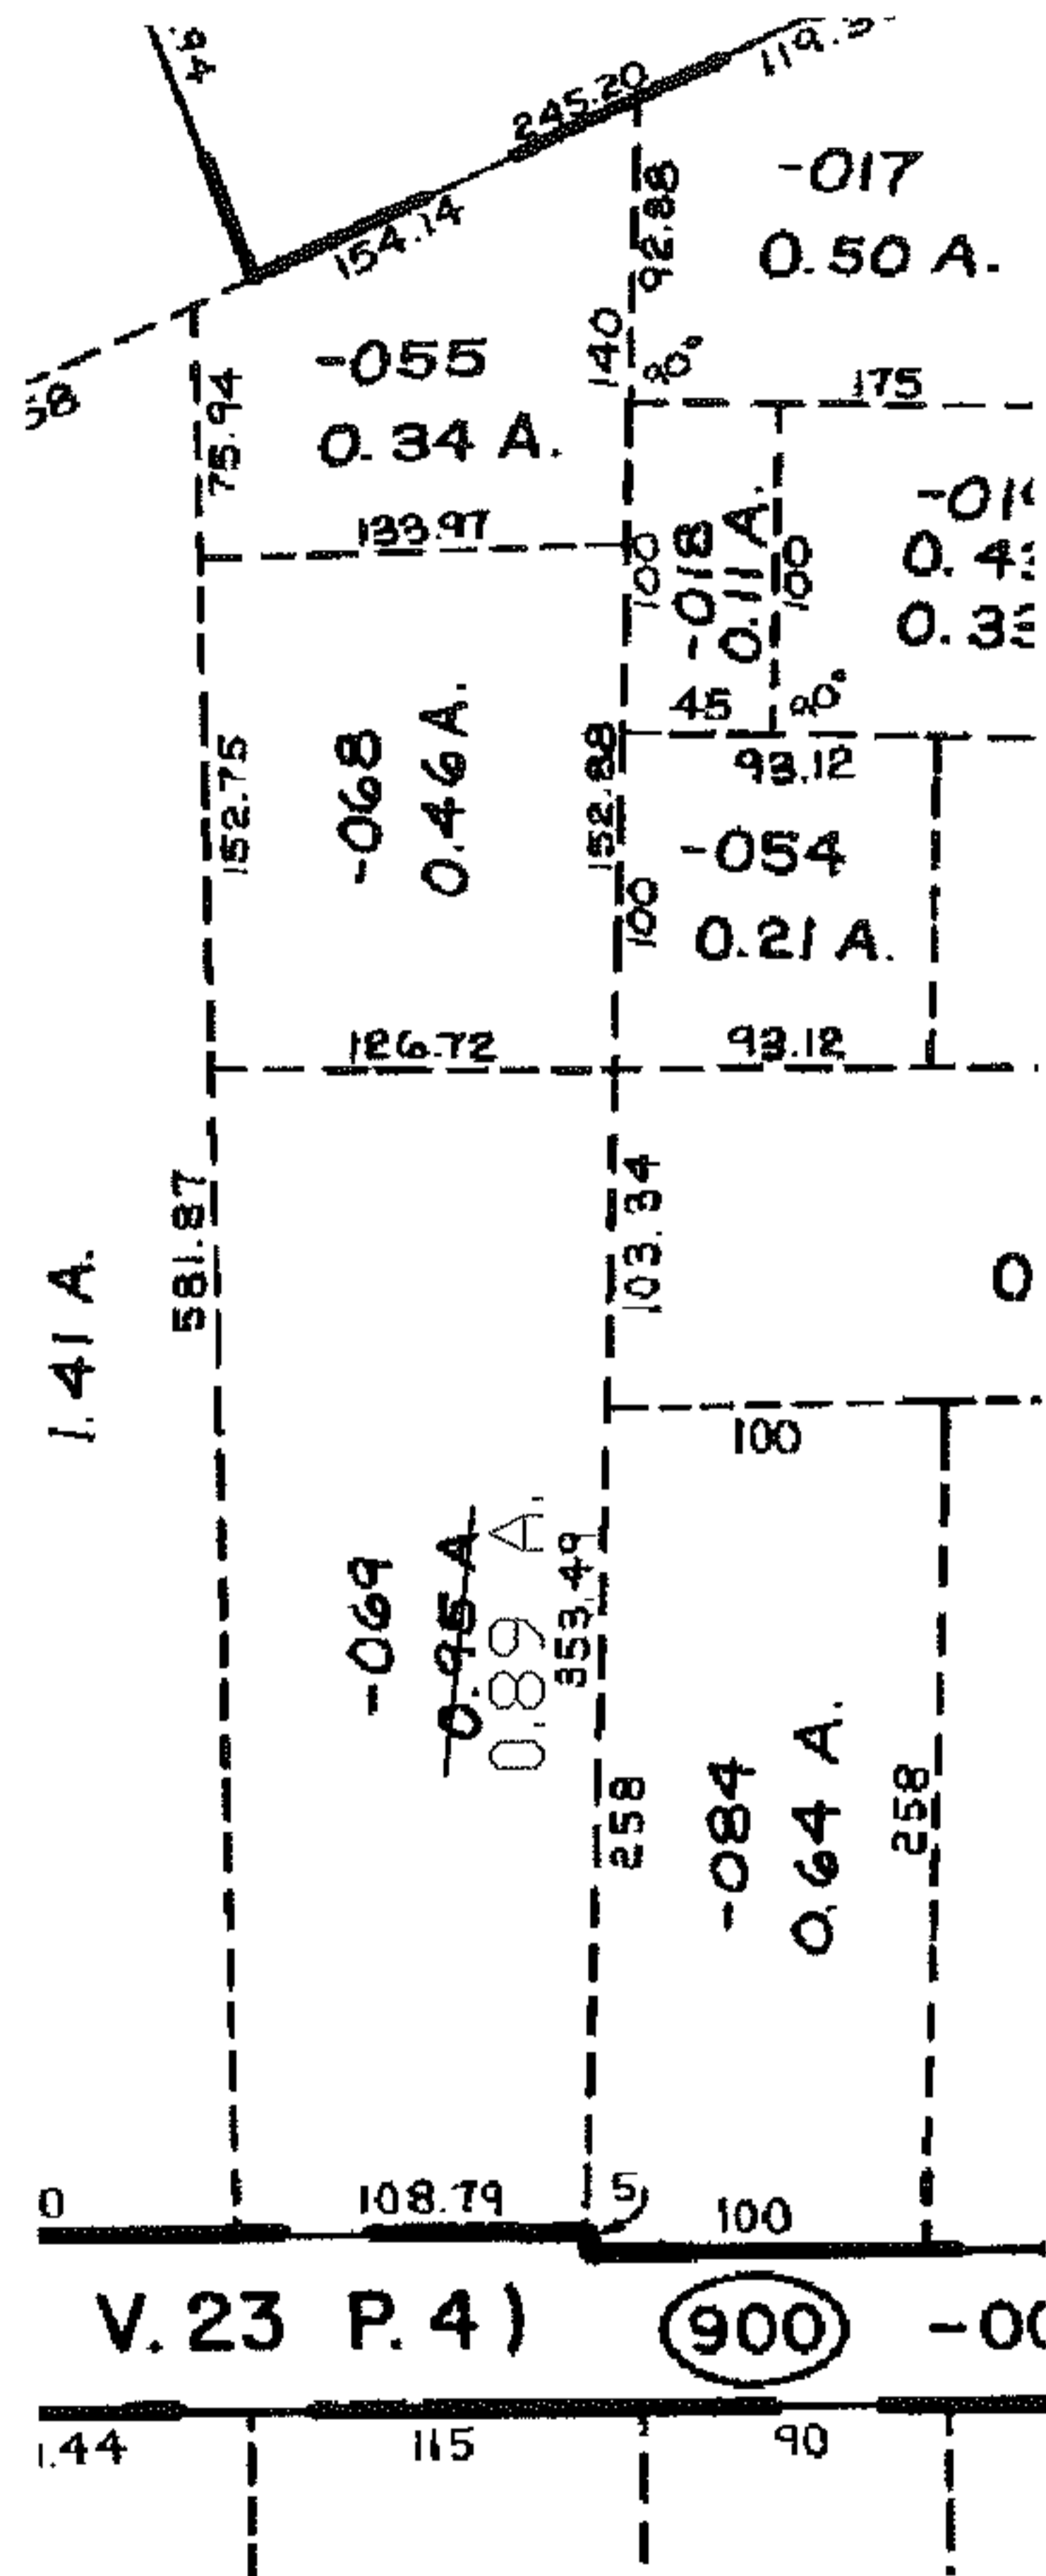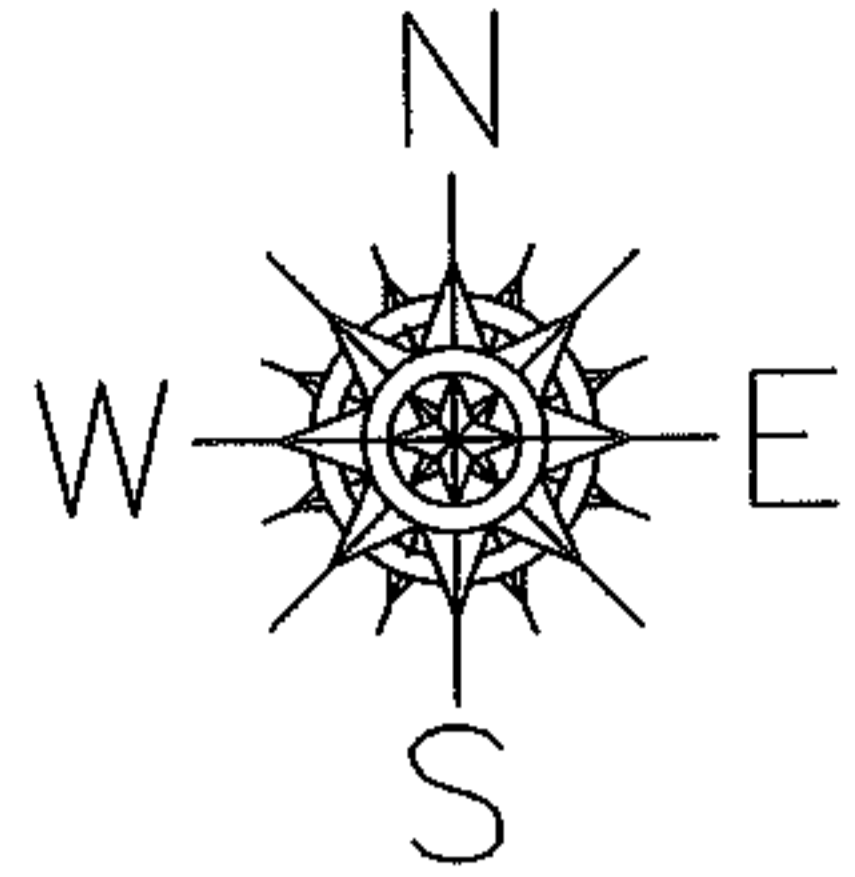

SPLITS/DEEDS PROCESSED

LORAIN COUNTY TAX MAP DEPARTMENT
226 MIDDLE AVE. ELYRIA, OHIO

SURVEYED BY: N/A
 CLOSURE: N/A
 MAP PAGE(S): 07-00-028-A
 APPROVED BY: DRH DATE: 4/22/2008
 SCALE: NOT TO SCALE PRIOR INSTRUMENT: 20070228157