
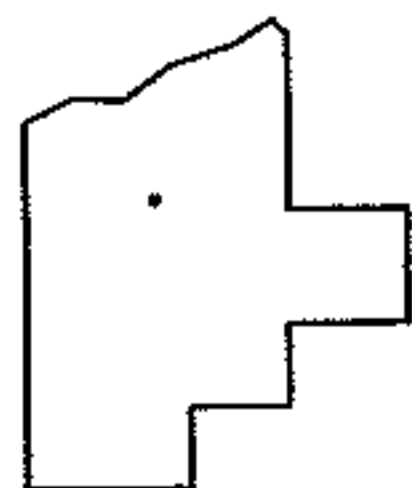
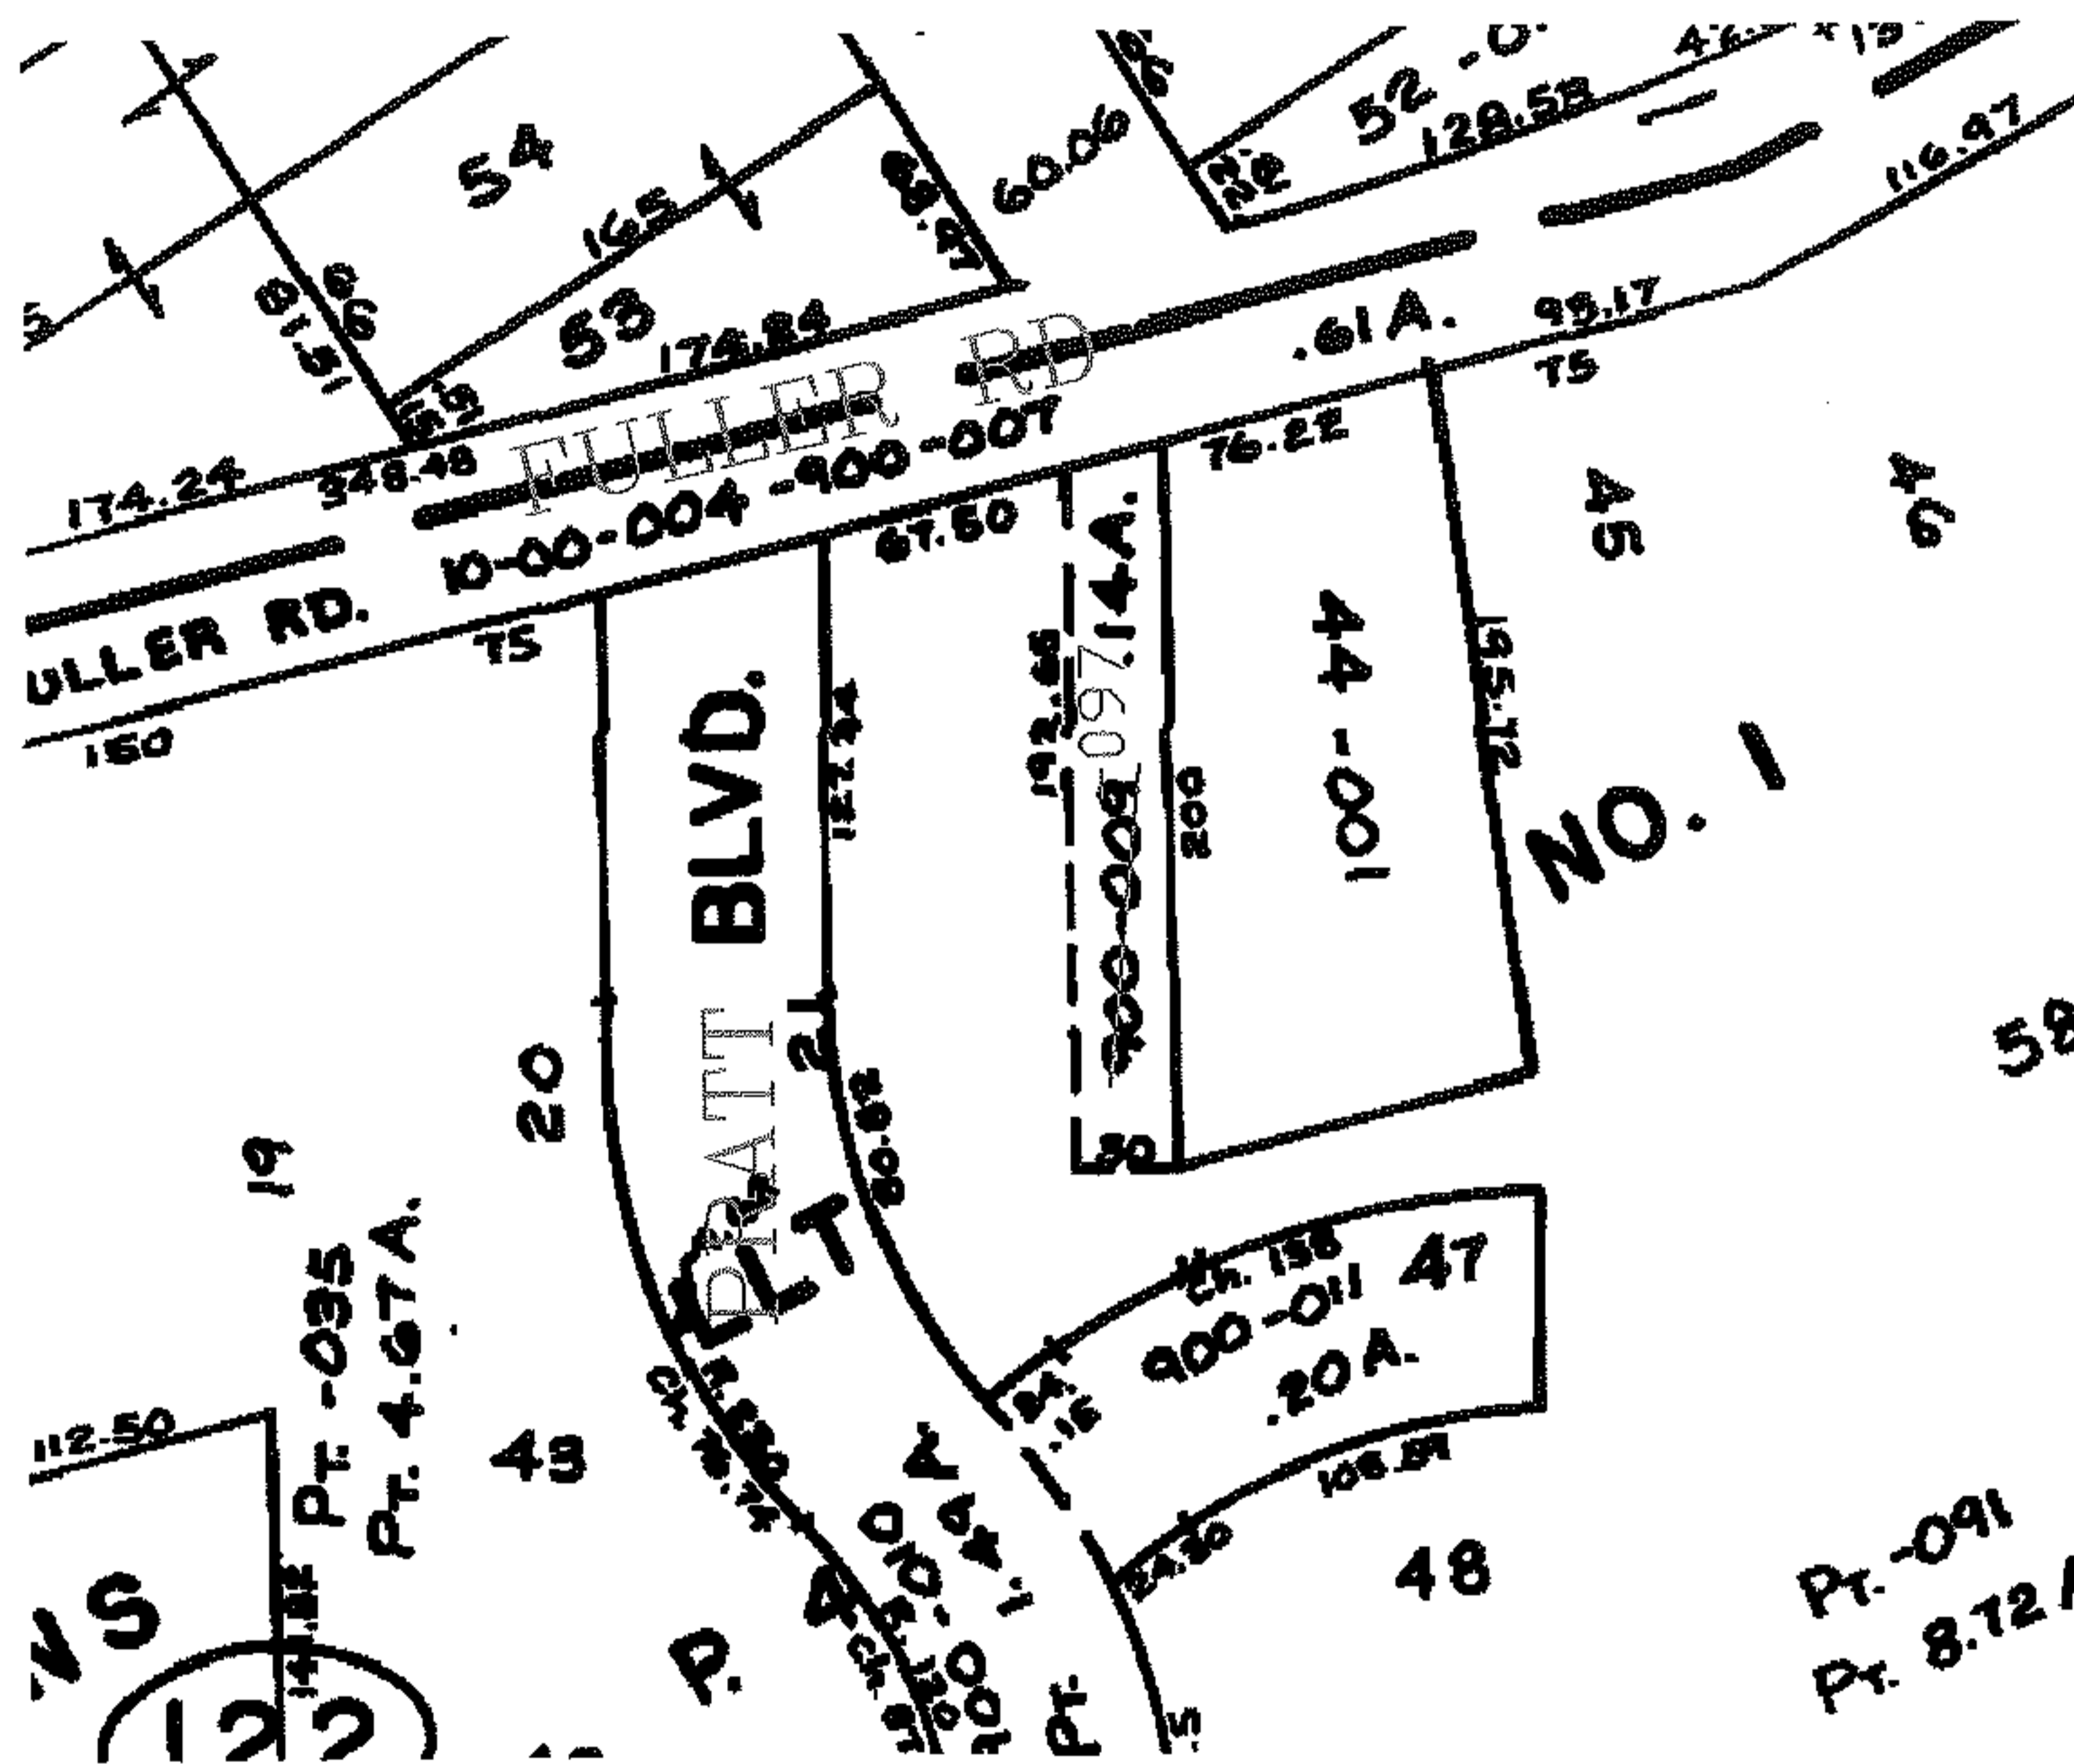


RASTER

PARENT PARCEL: 10-00-004-900-009  
CHILD PARCEL: 10-00-004-123-097  
STARTING POINT: INT CL PRATT BLVD AND FULLER RD

08-01640-X

DROP FROM DUP 10-00-004-900-009  
ADD TO DUP 10-00-004-123-097  
PARCEL WAS ADDED IN WRONG BLOCK

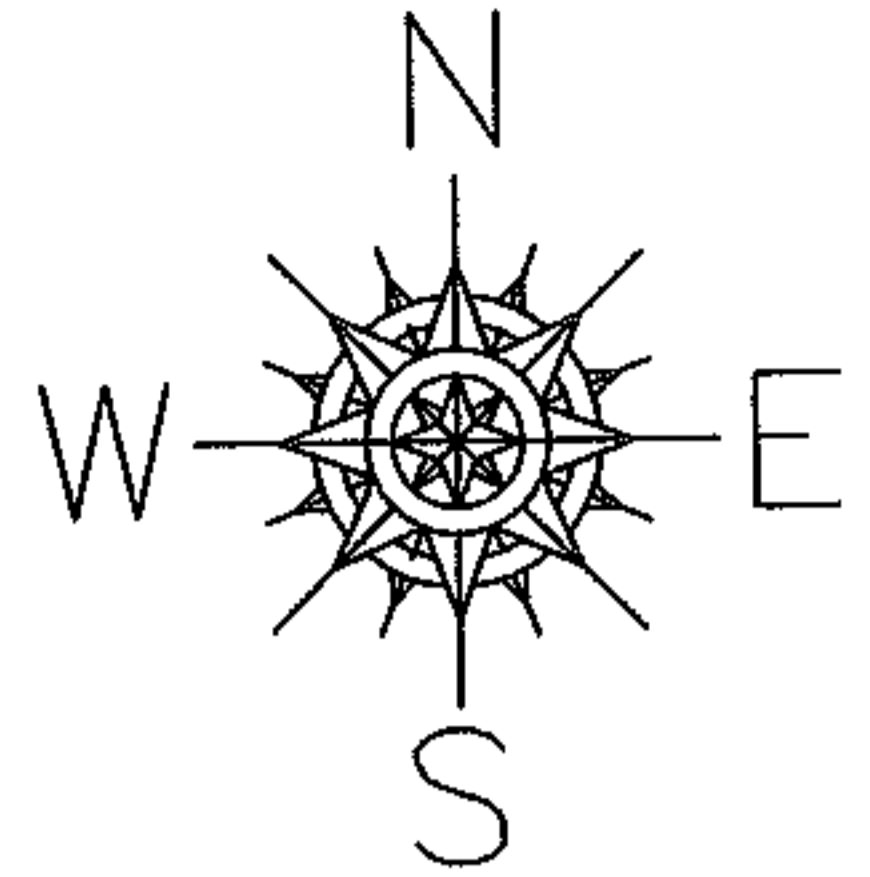

SPLITS/DEEDS PROCESSED  
LORAIN COUNTY TAX MAP DEPARTMENT  
226 MIDDLE AVE. ELYRIA, OHIO

SURVEYED BY: N/A  
CLOSURE: N/A  
MAP PAGE(S): 10-00-004-B  
APPROVED BY: DRH DATE: 4/30/2008  
SCALE: NOT TO SCALE PRIOR INSTRUMENT: