



PARENT PARCEL: 06-25-016-108-023

CHILD PARCEL: --SAME--

STARTING POINT: S/L 36

08-01650-C

# DEPTH CORR PER DEED

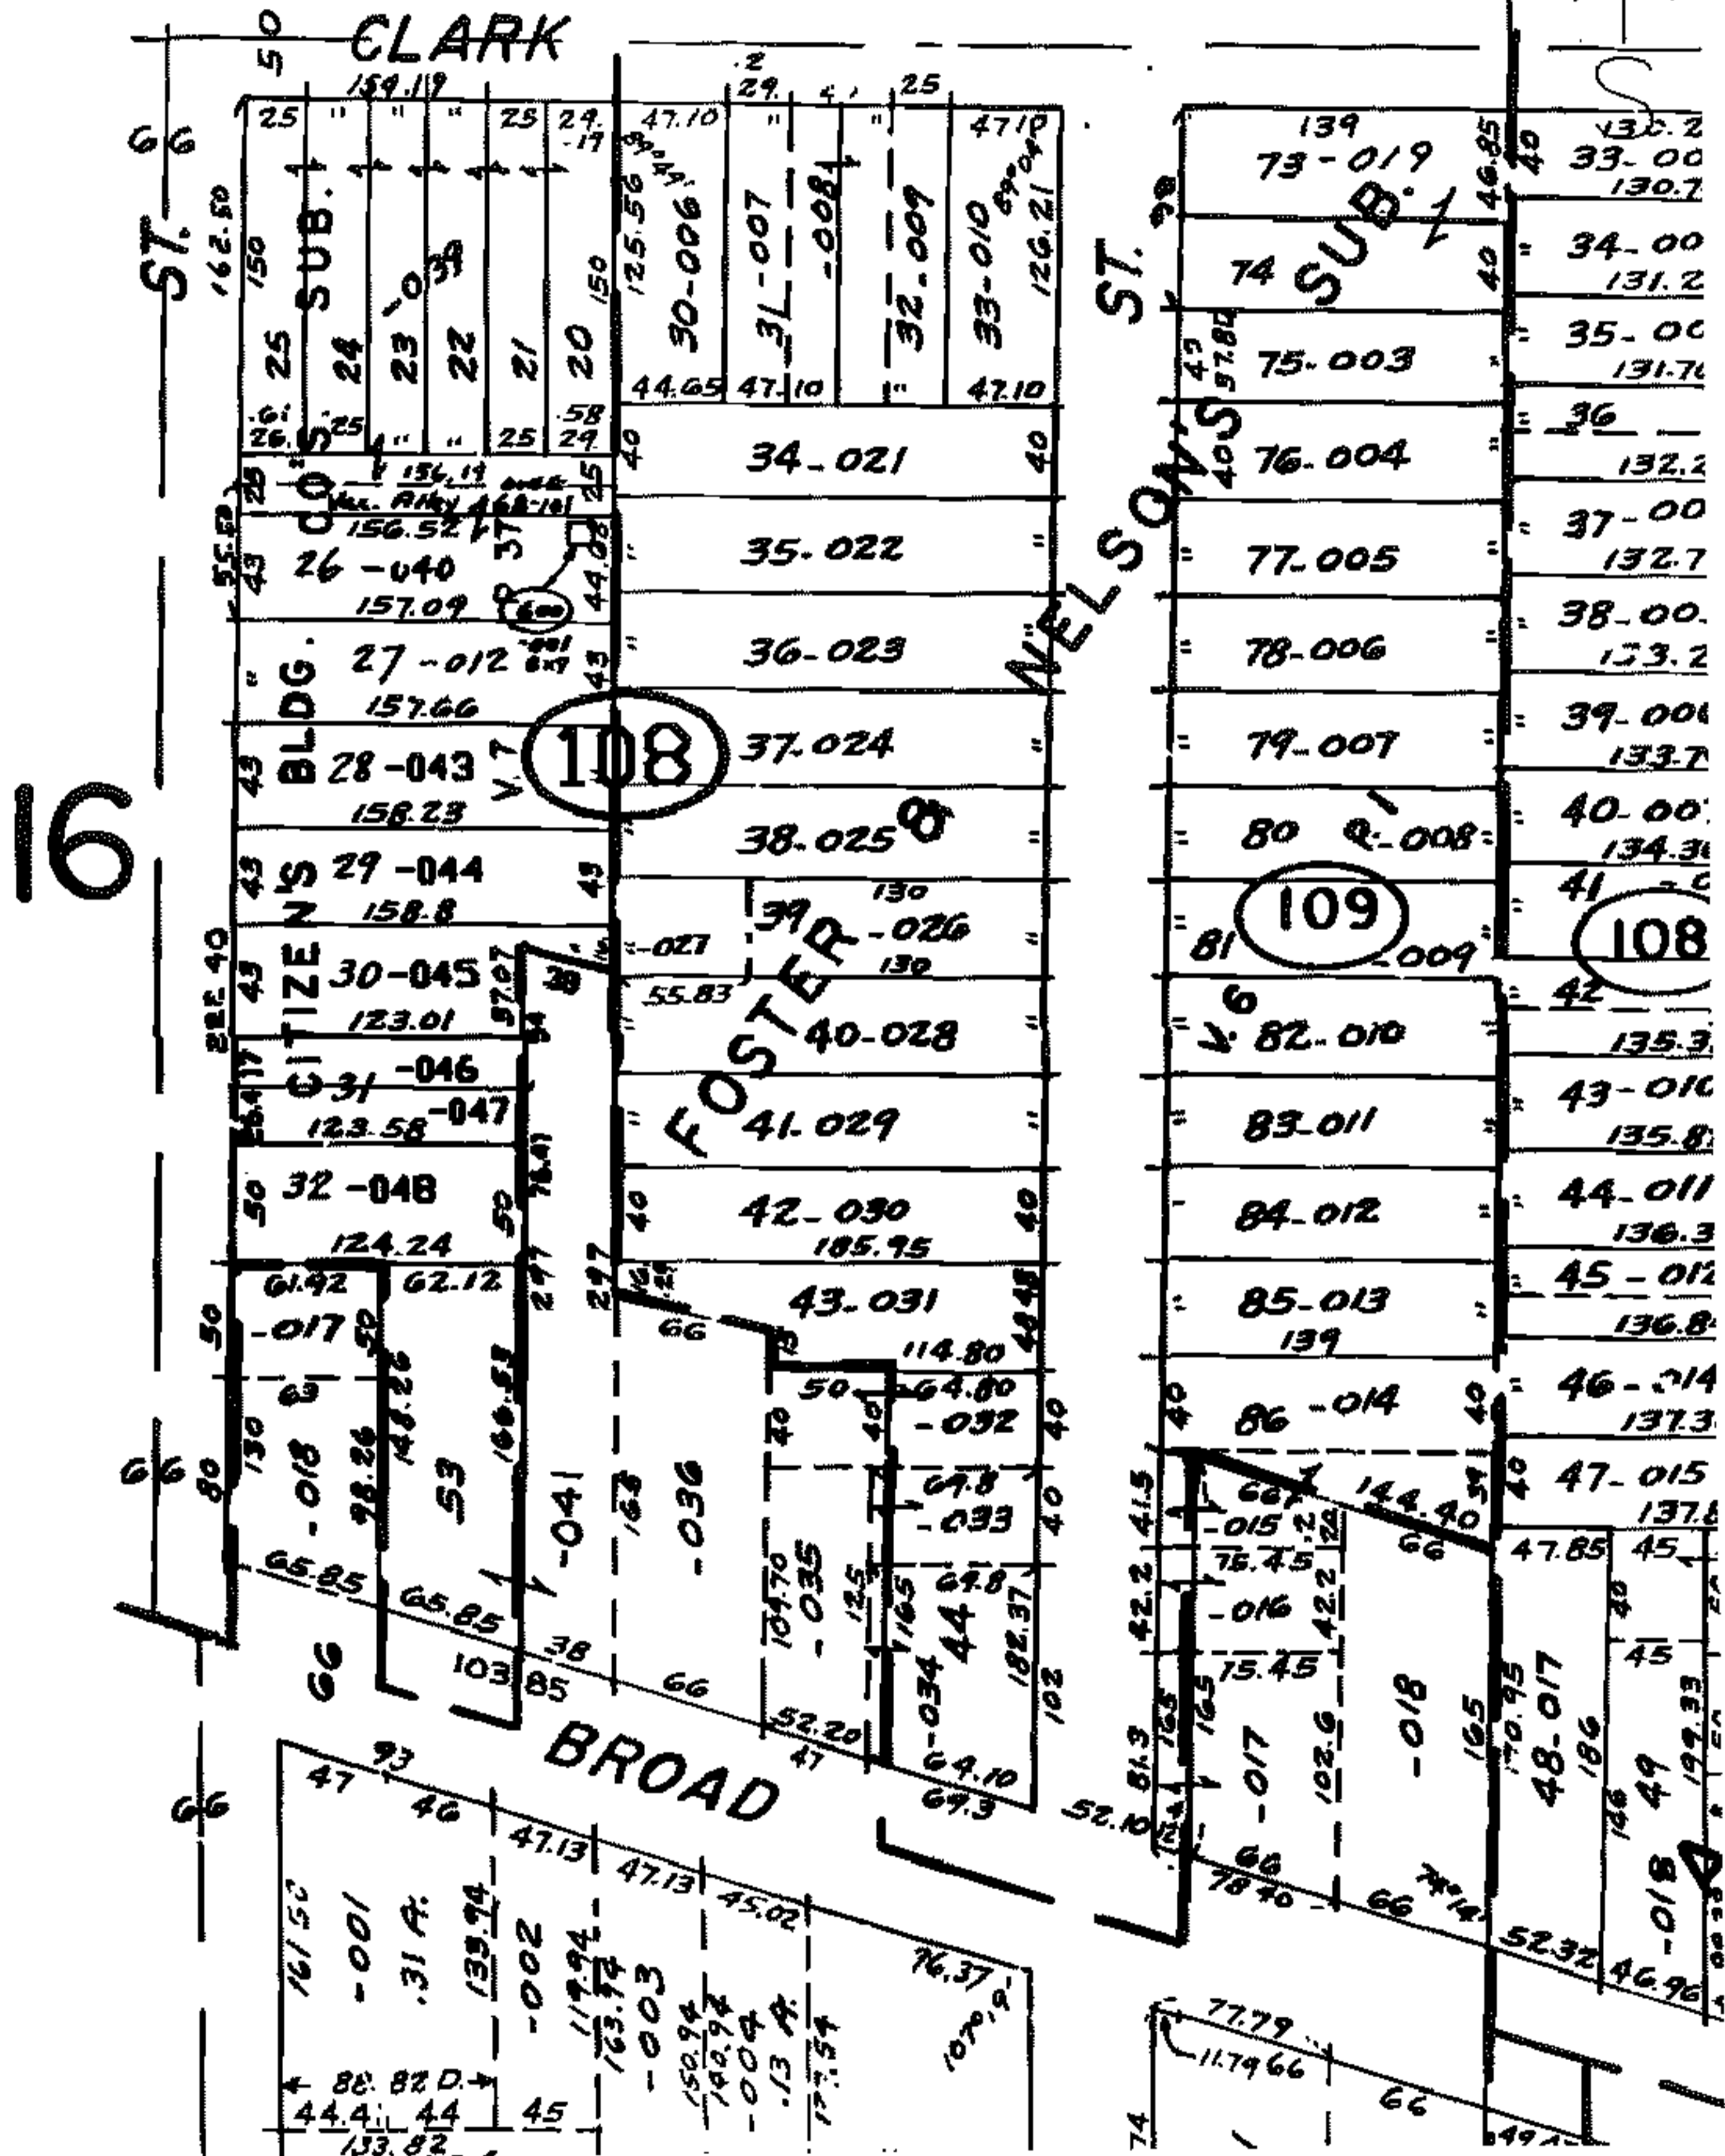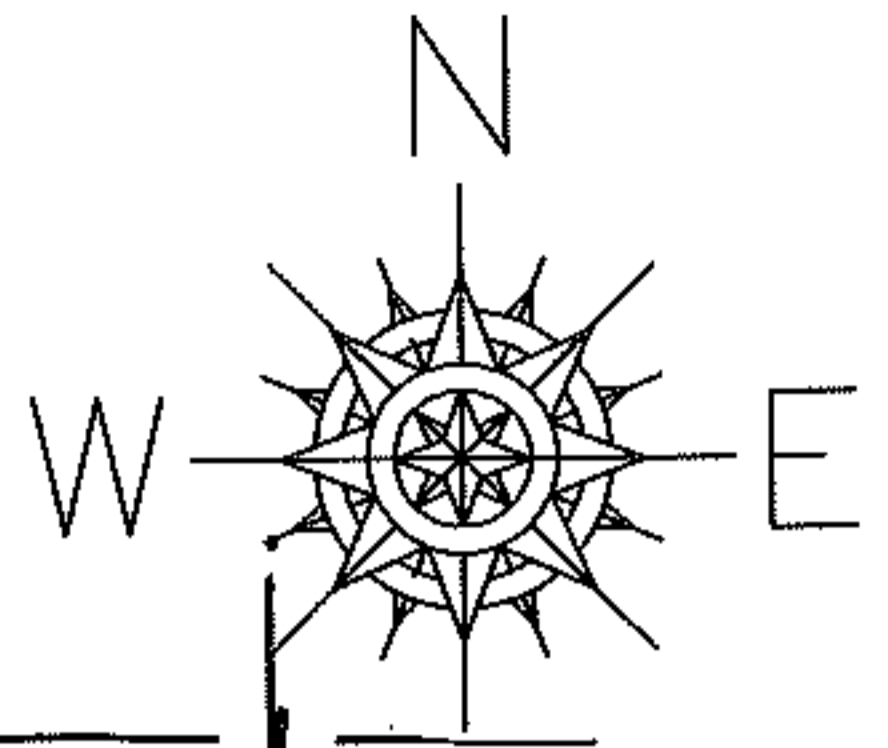

SPLITS/DEEDS PROCESSED

LORAIN COUNTY TAX MAP DEPARTMENT  
226 MIDDLE AVE. ELYRIA, OHIO

SURVEYED BY: N/A

CLOSURE: N/A

MAP PAGE(S): 06-123

APPROVED BY: DRH DATE: 8/25/2008

SCALE: NOT TO SCALE PRIOR INSTRUMENT: 19980544719