

PARENT PARCEL: SEE BELOW

CHILD PARCEL: SEE BELOW

STARTING POINT: XXXXXX

NO. 08-01653-C

ACREAGE CORRECTIONS

05-00-008-000-011

~~133.20 A.~~

131.59 A.

05-00-010-101-046

~~7.06 A.~~

7.13 A.

05-00-093-000-021

~~240.07 A.~~

240.12 A.

05-00-094-102-024

~~45.08 A.~~

45.07 A.

05-00-009-000-090

~~38.89 A.~~

38.85 A.

05-00-009-000-092

~~68.38 A.~~

68.34 A.

STRAIGHT TRANSFER

01-00-057-000-012

38.06 A.

01-00-072-000-013

45.14 A.

05-00-091-101-014

21.32 A.

05-00-091-102-015

45.72 A.

05-00-092-000-016

52.29 A.

05-00-092-000-017

5.21 A.


05-00-092-000-018

176.68 A.

05-00-009-000-078

0.24 A.

PG. 2 OF 2

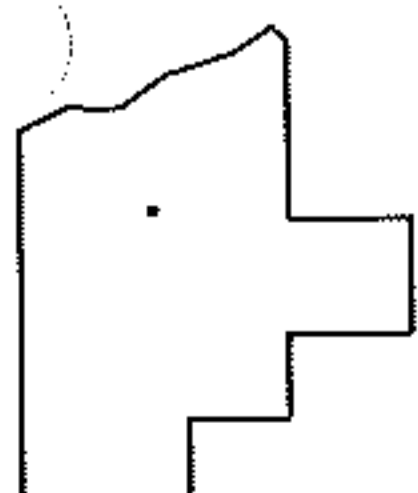

SPLITS/DEEDS PROCESSED
LORAIN COUNTY TAX MAP DEPARTMENT
226 MIDDLE AVE. ELYRIA, OHIO

SURVEYED BY: DAVID ELWELL

CLOSURE: XXXXXX

MAP PAGE(S): XX-XX-XXX

APPROVED BY: TJS DATE: 6/13/08

SCALE: 1" = 300' PRIOR INSTRUMENT: 20070235144