


RASTER

PARENT PARCEL: 10-00-006-110-005, -006



08-01660-D

CHILD PARCEL: --SAME--

STARTING POINT: INT CL JERROL CT AND GRAFTON RD

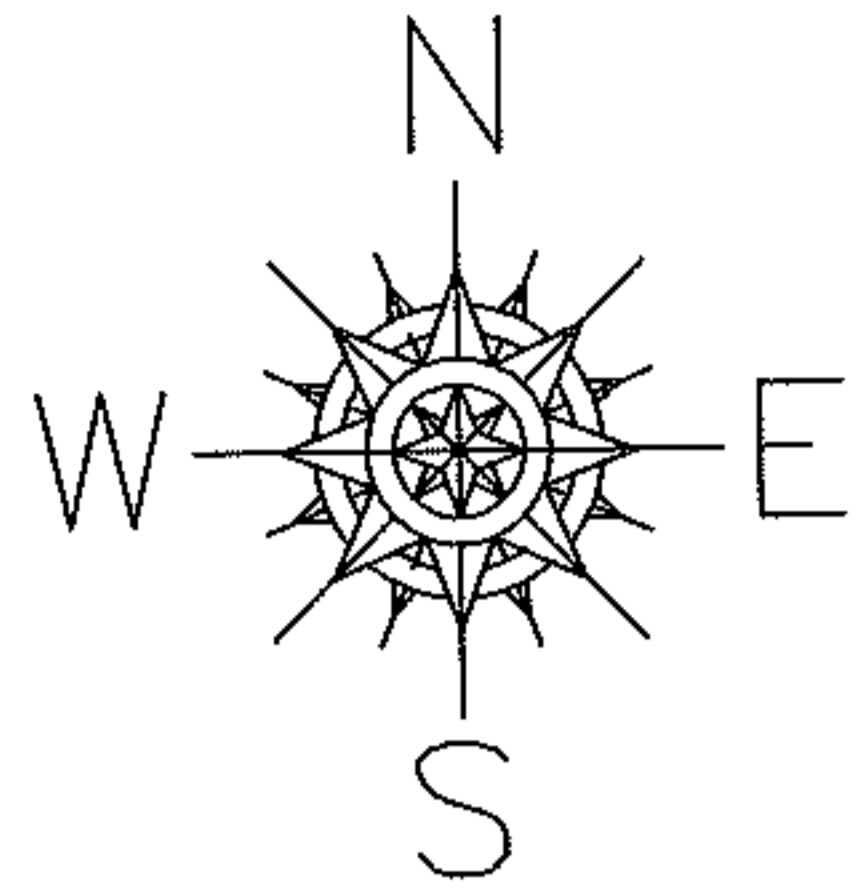

AC. CORR.
PER SURVEY
DALE HAYWOOD

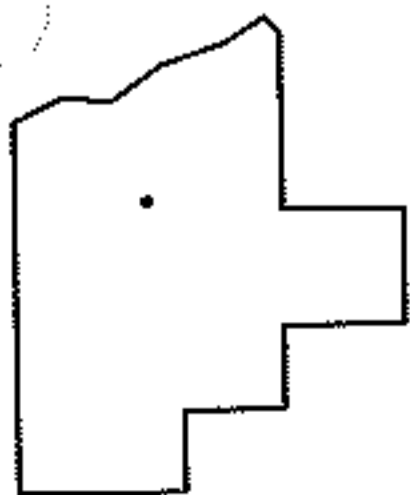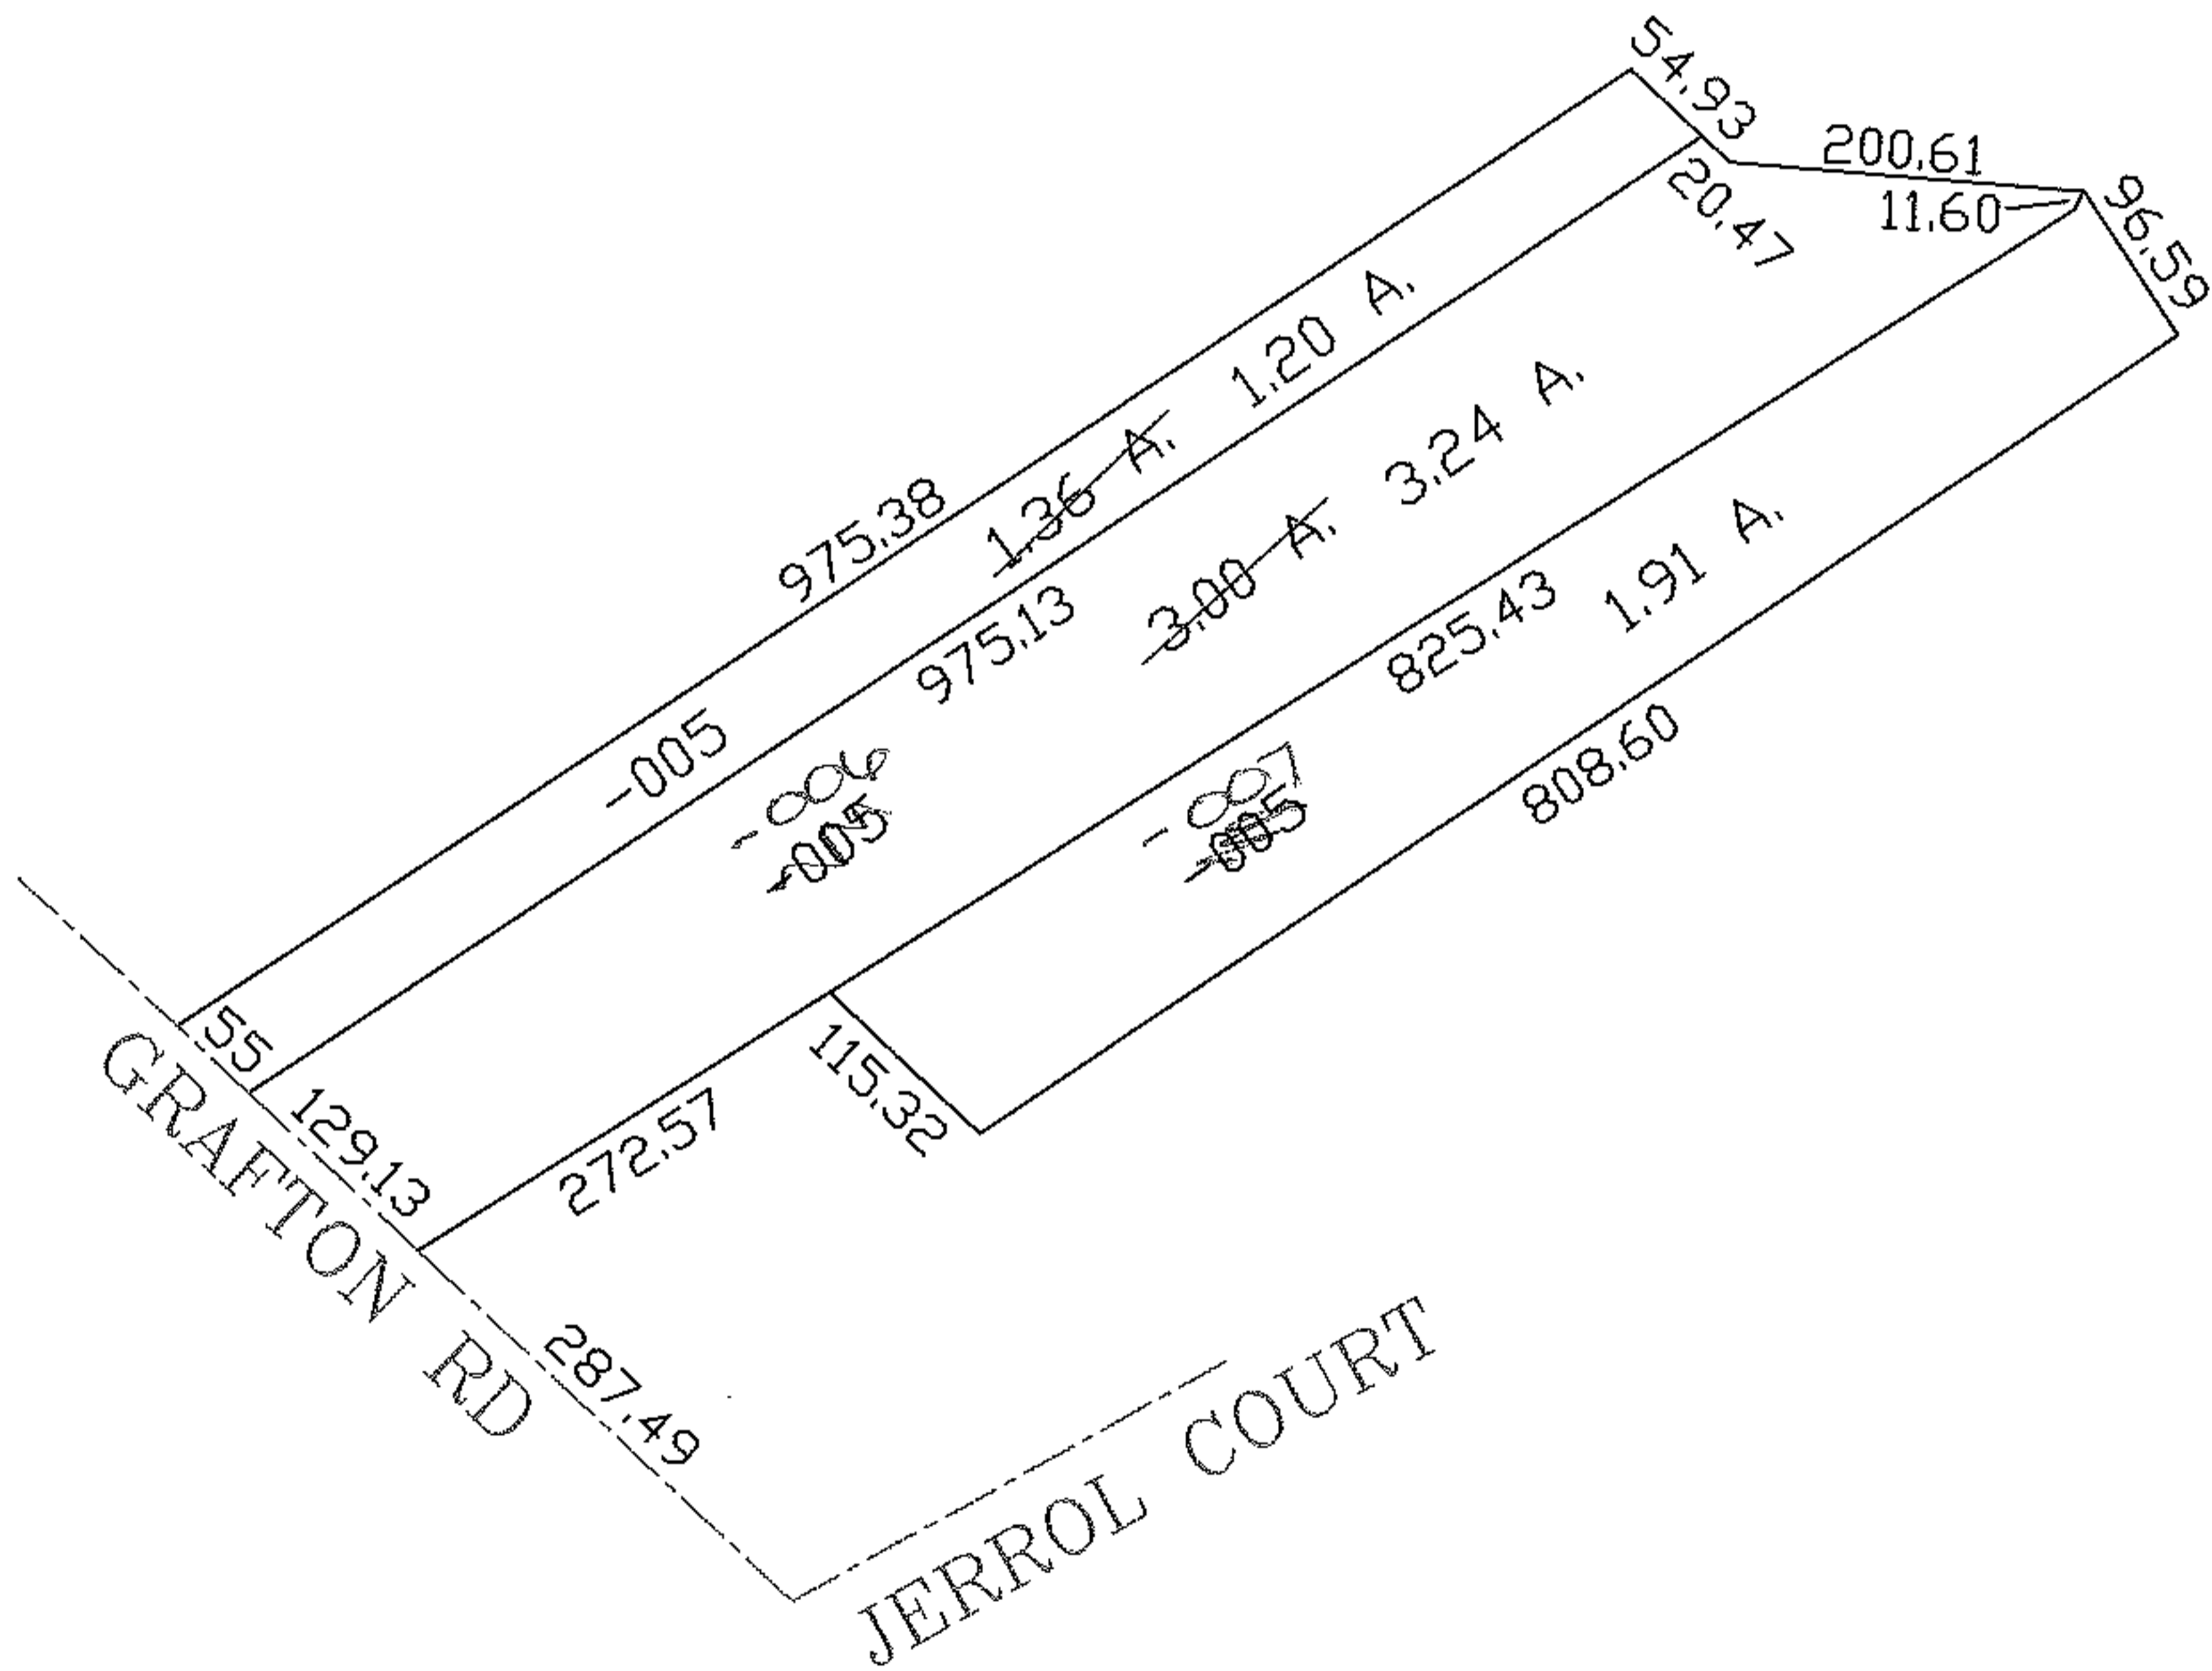

SPLITS/DEEDS PROCESSED
LORAIN COUNTY TAX MAP DEPARTMENT
226 MIDDLE AVE. ELYRIA, OHIO

SURVEYED BY: DALE HAYWOOD
CLOSURE: 1:10,000
MAP PAGE(S): 10-00-006-C
APPROVED BY: DRH DATE: 6/10/2008
SCALE: 1" = 200' PRIOR INSTRUMENT: 20000701653