

RASTER



PARENT PARCEL: 19-03-013-000-008

CHILD PARCEL: --SAME--

STARTING POINT: INT CL SR 301 AND SR 18

08-01676-C

# AC. CORR. PER SURVEY DALE HAYWOOD

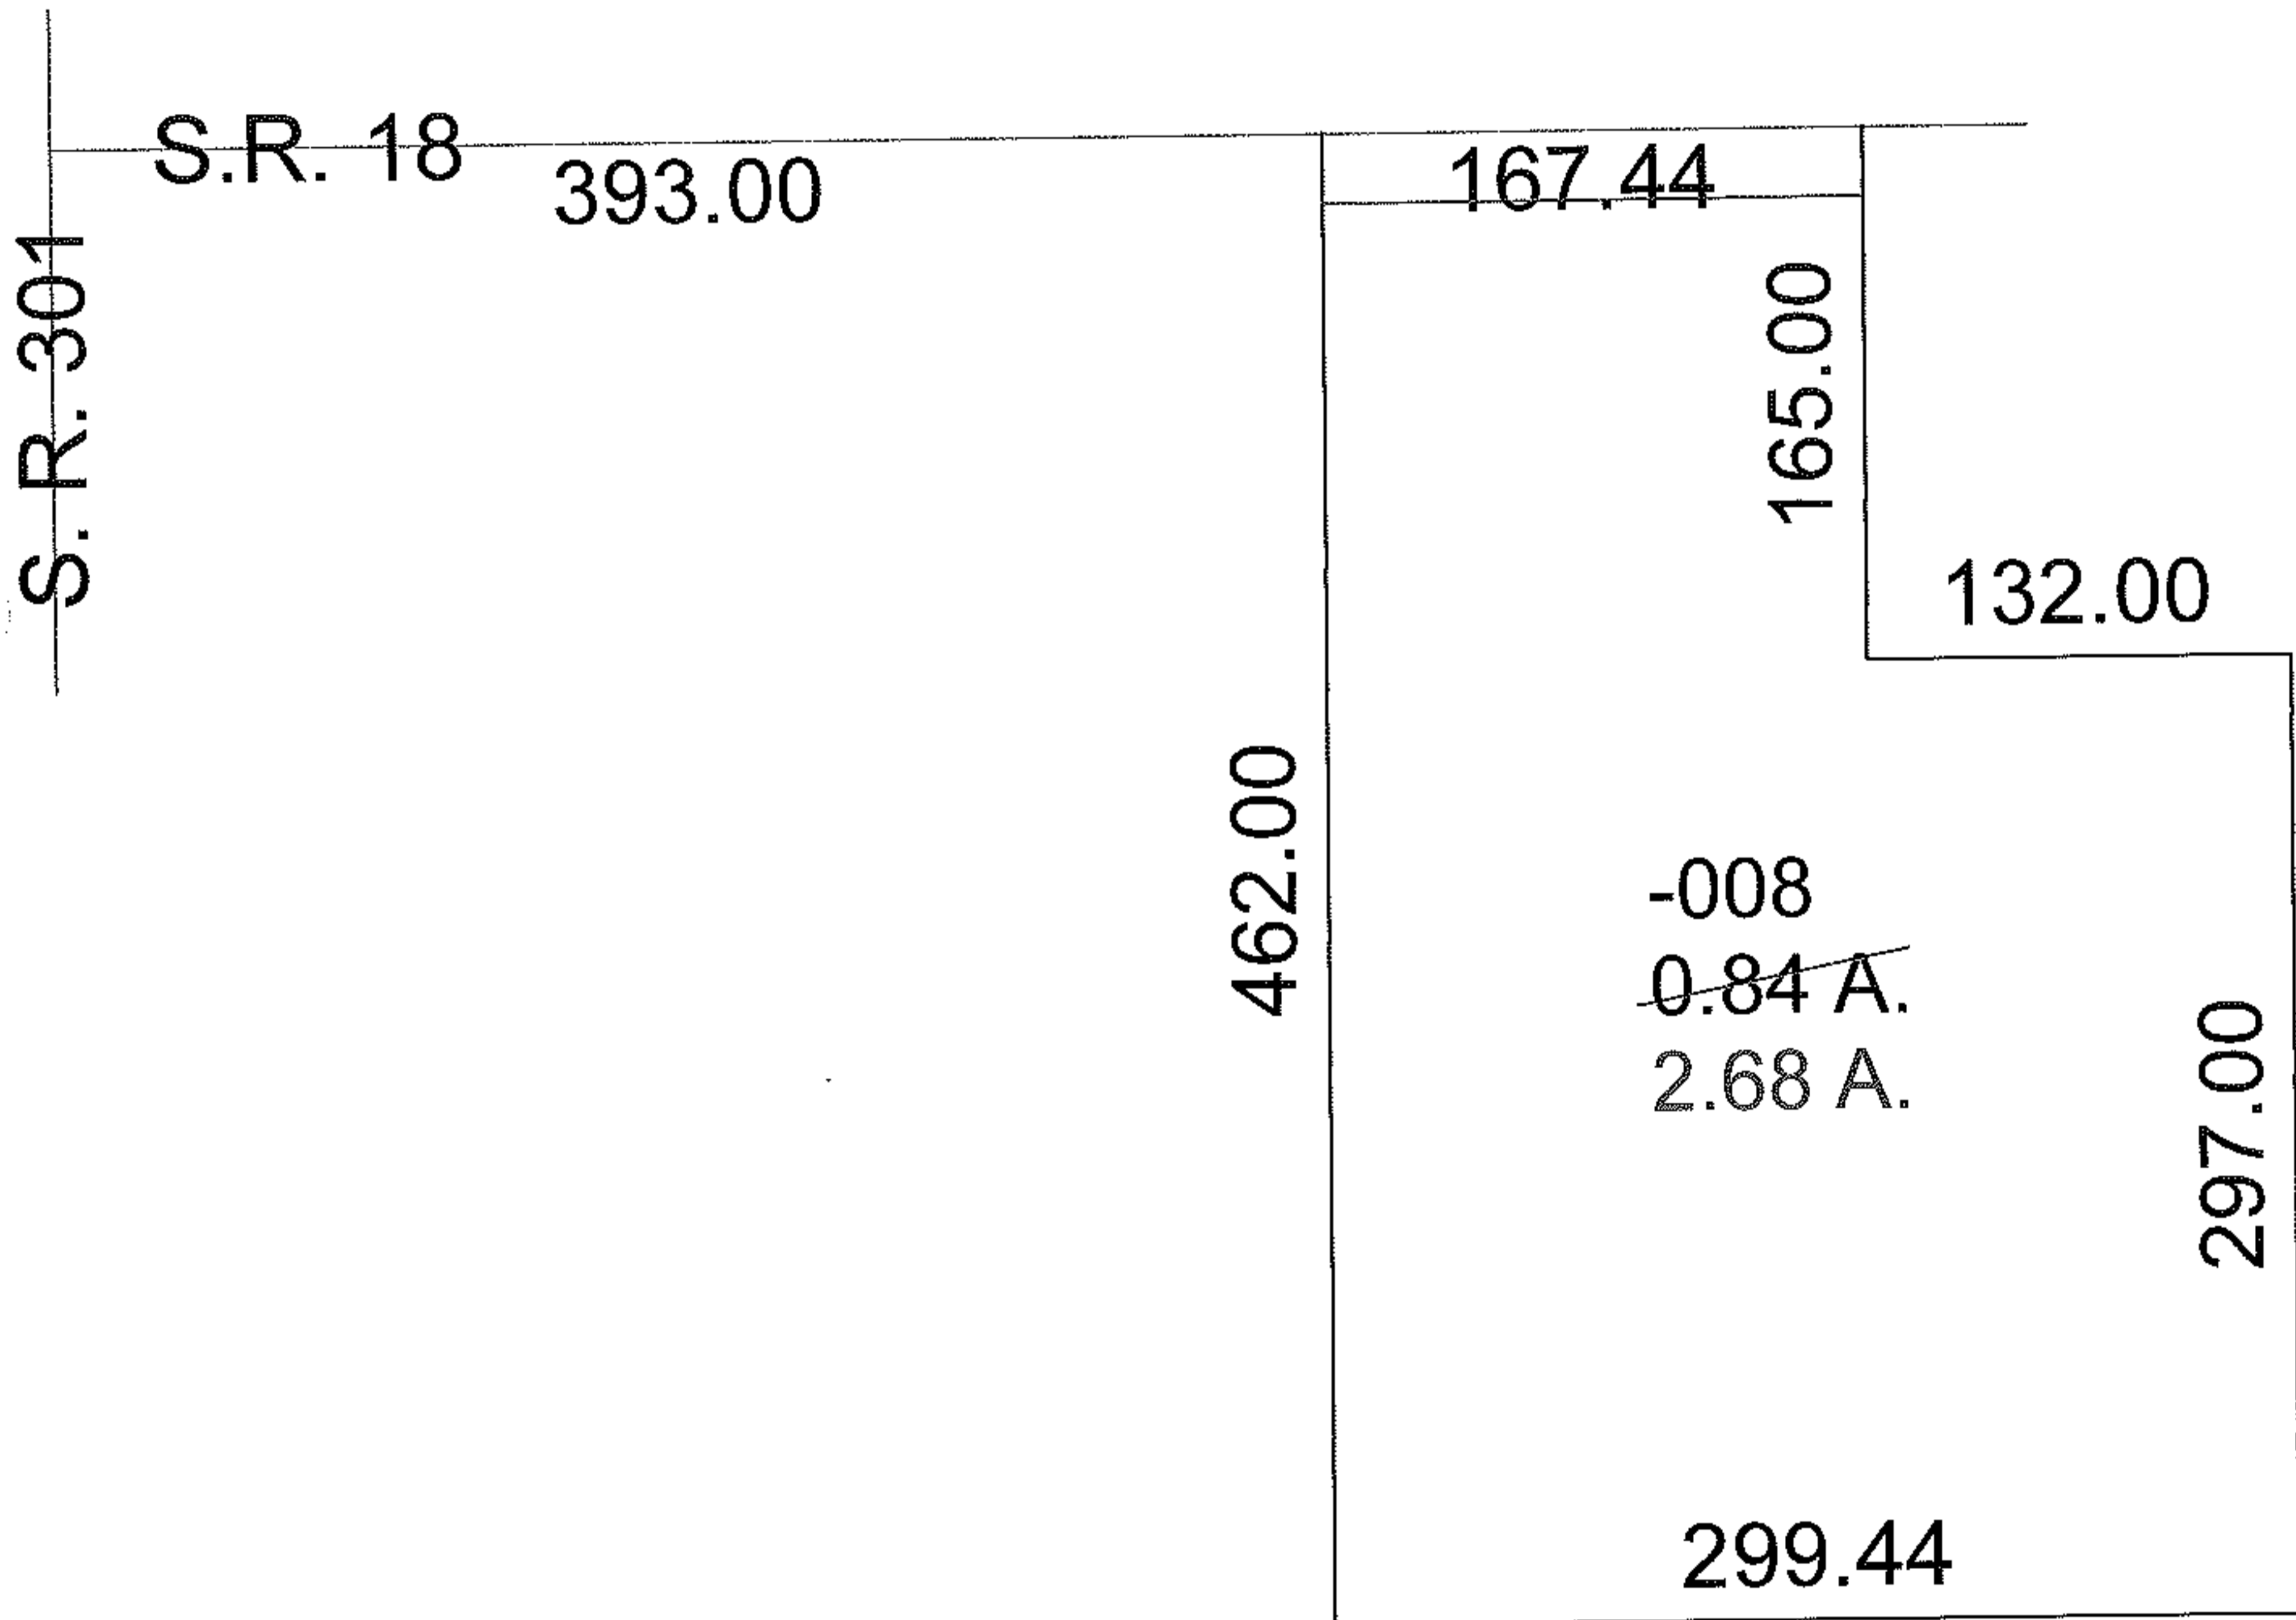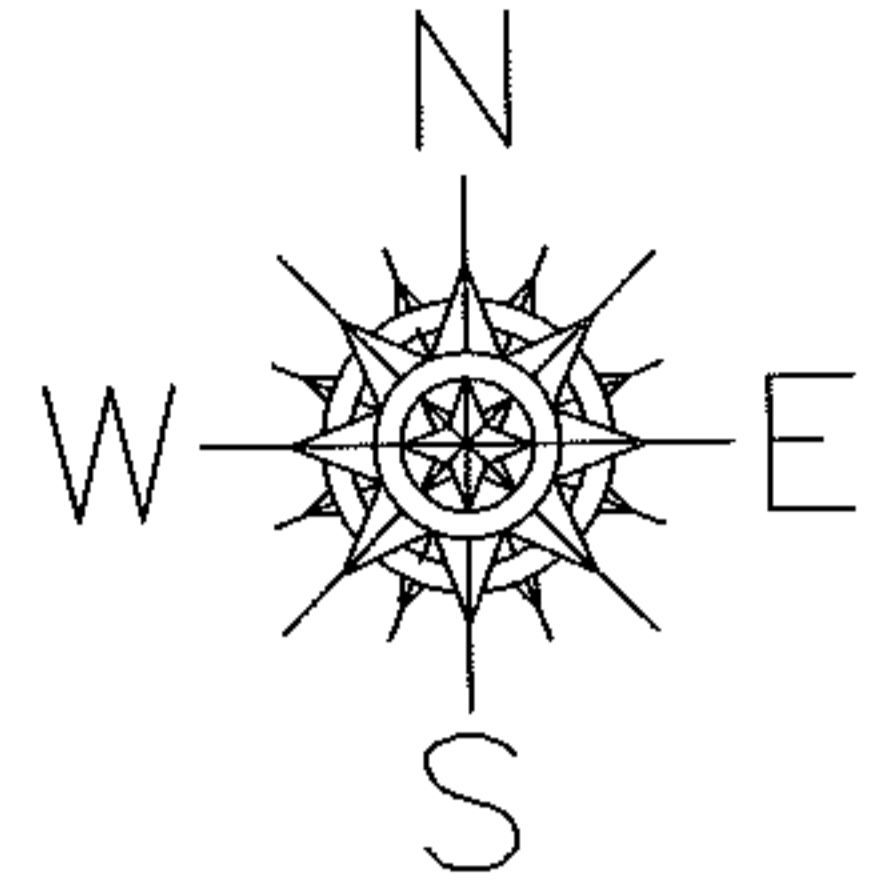

SPLITS/DEEDS PROCESSED

LORAIN COUNTY TAX MAP DEPARTMENT  
226 MIDDLE AVE. ELYRIA, OHIO

SURVEYED BY: DALE HAYWOOD

CLOSURE: 1:10.000

MAP PAGE(S): 19-03-013

APPROVED BY: DRH DATE: 8/19/2008

SCALE: 1" = 100 PRIOR INSTRUMENT: DV 68/65