


RASTER

PARENT PARCEL: 15-00-065-000-096

CHILD PARCEL: 15-00-065-000-096

STARTING POINT: MON. BOX, CL OF WHITNEY RD. & S.W. CORNER OF O.L. 65

08-01677-A

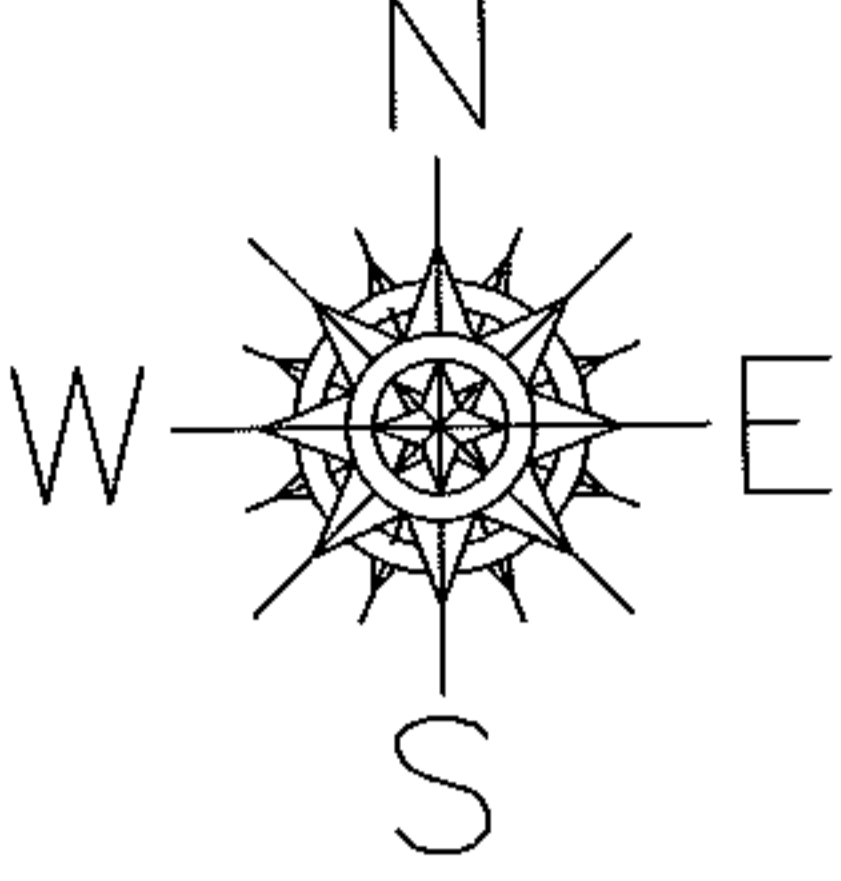


POGACSNIK LANE 60'

AC. CORR.  
PER SURVEY  
ROBERT GANNON

98.59	310	-095	0.71 A.	100
	310			100
100		-019	0.71 A.	100
100		-015	0.71 A.	100
100		-021	0.71 A.	100
100		-022	0.71 A.	100
200		-017	1.42 A.	200

LAGRANGE RD. 60'

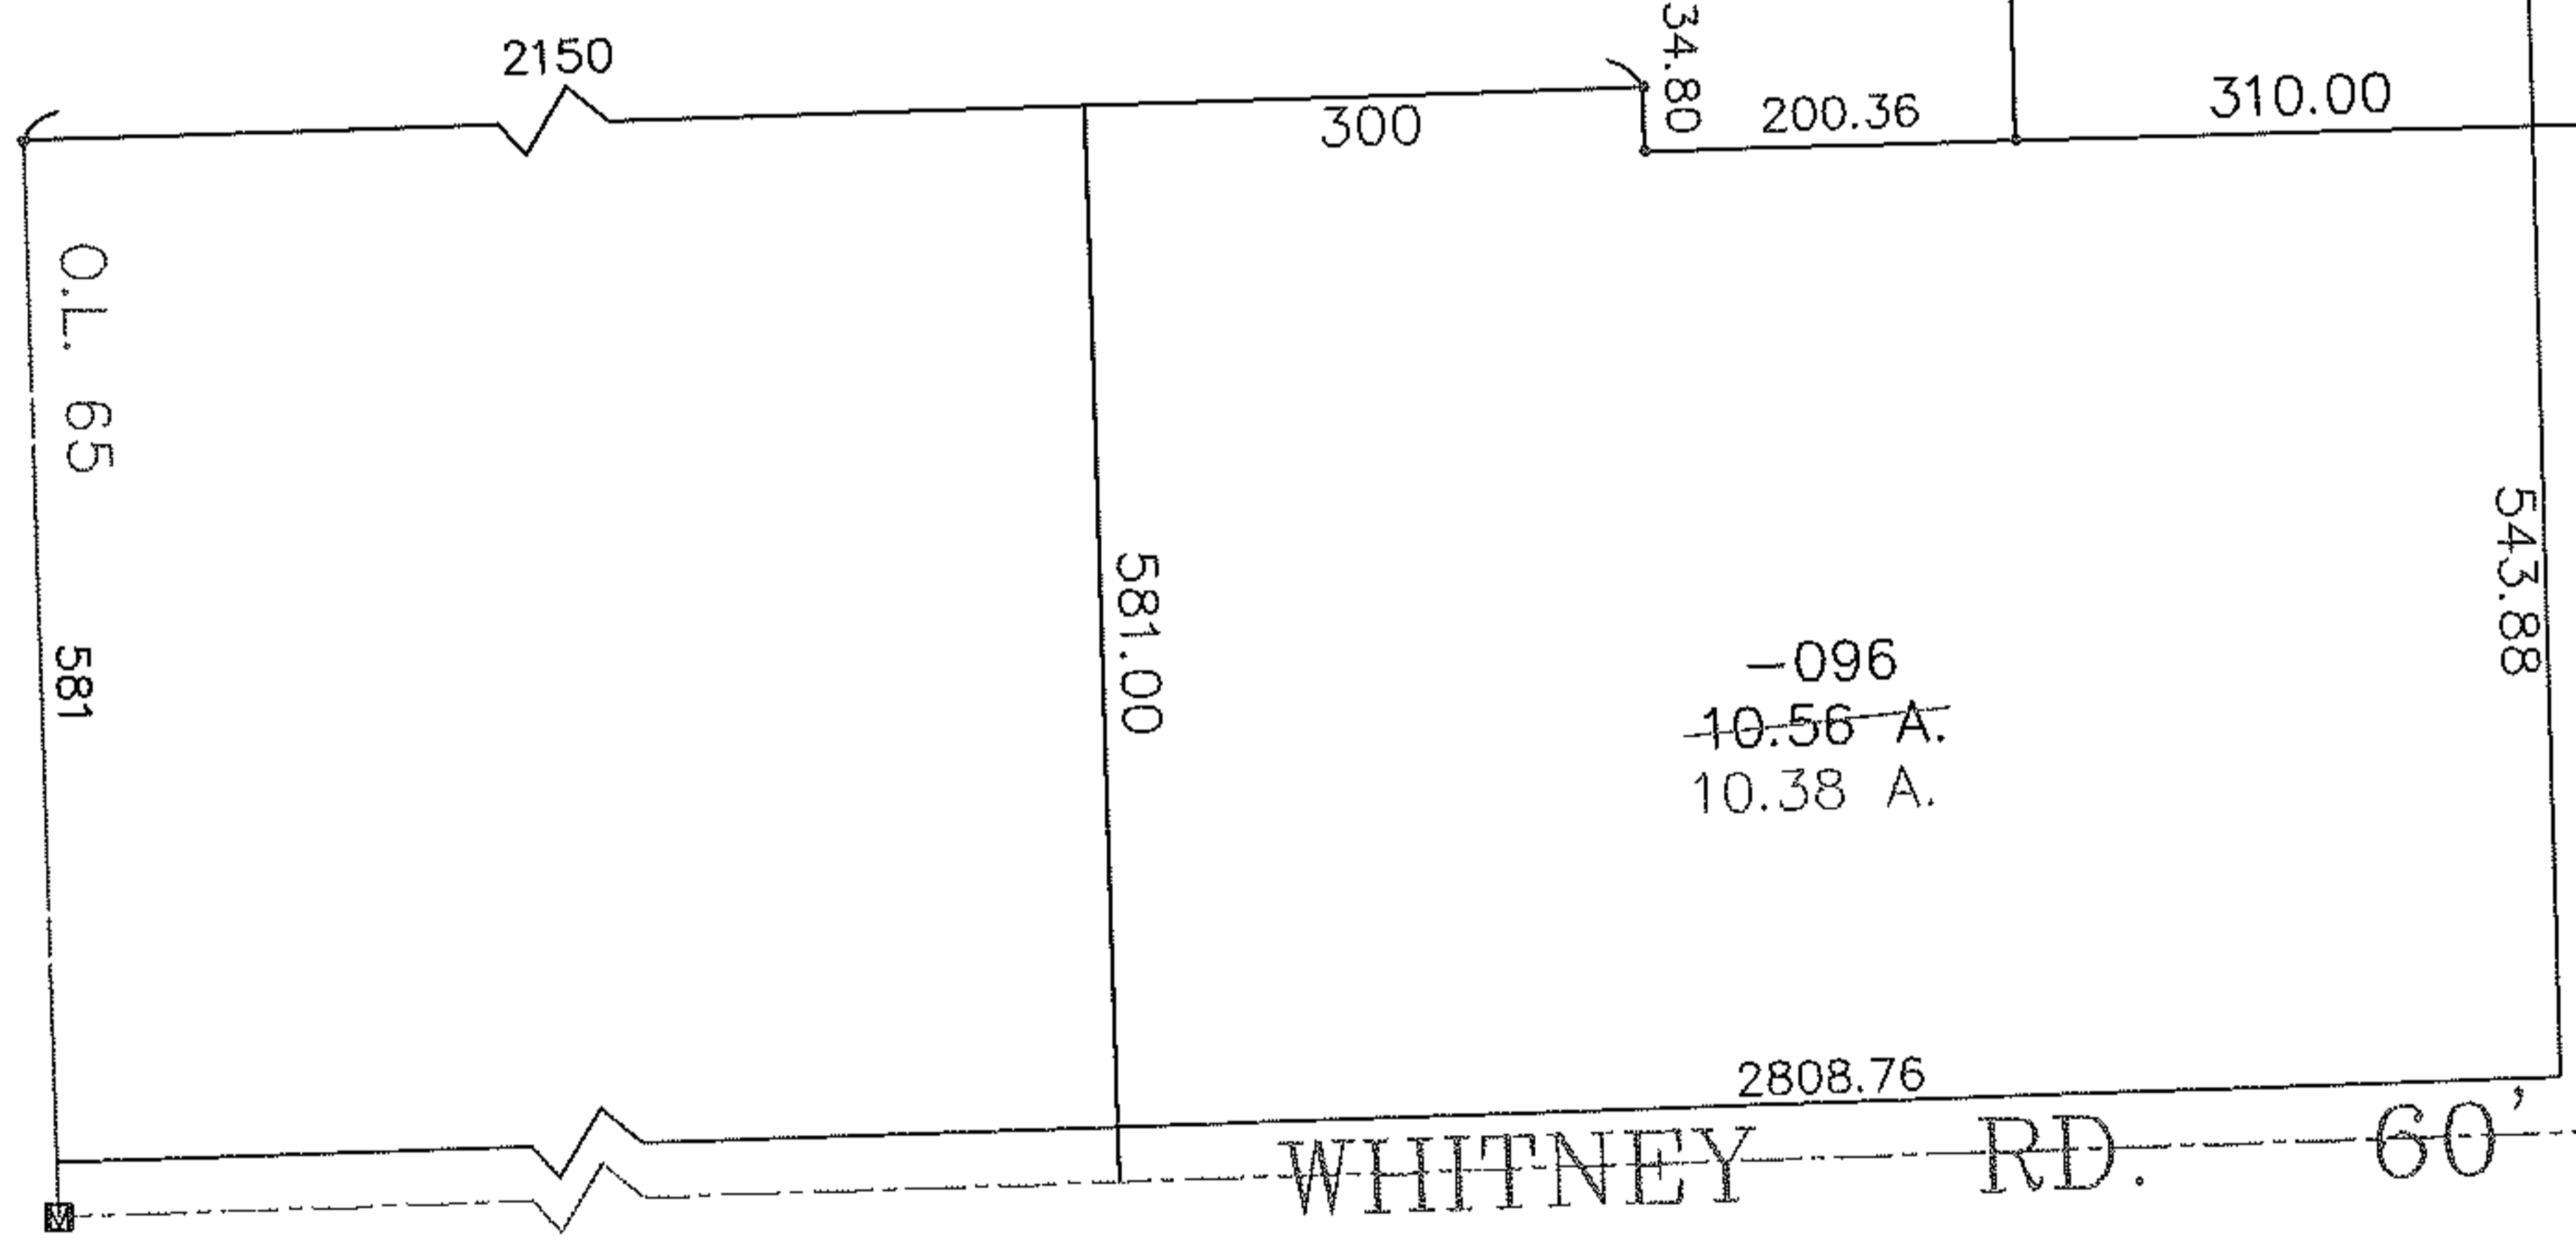

SURVEYED BY: ROBERT L. GANNON  
 CLOSURE: 1:10,000  
 MAP PAGE(S): 15-00-065-B  
 APPROVED BY: DRH DATE: 8/19/2009  
 SCALE: 1" = 200' PRIOR INSTRUMENT: OR 769/576

**SPLITS/DEEDS PROCESSED**  
 LORAIN COUNTY TAX MAP DEPARTMENT  
 226 MIDDLE AVE. ELYRIA, OHIO

