



RASTER

PARENT PARCEL: _____
CHILD PARCEL: _____
STARTING POINT: _____

08-01694-C

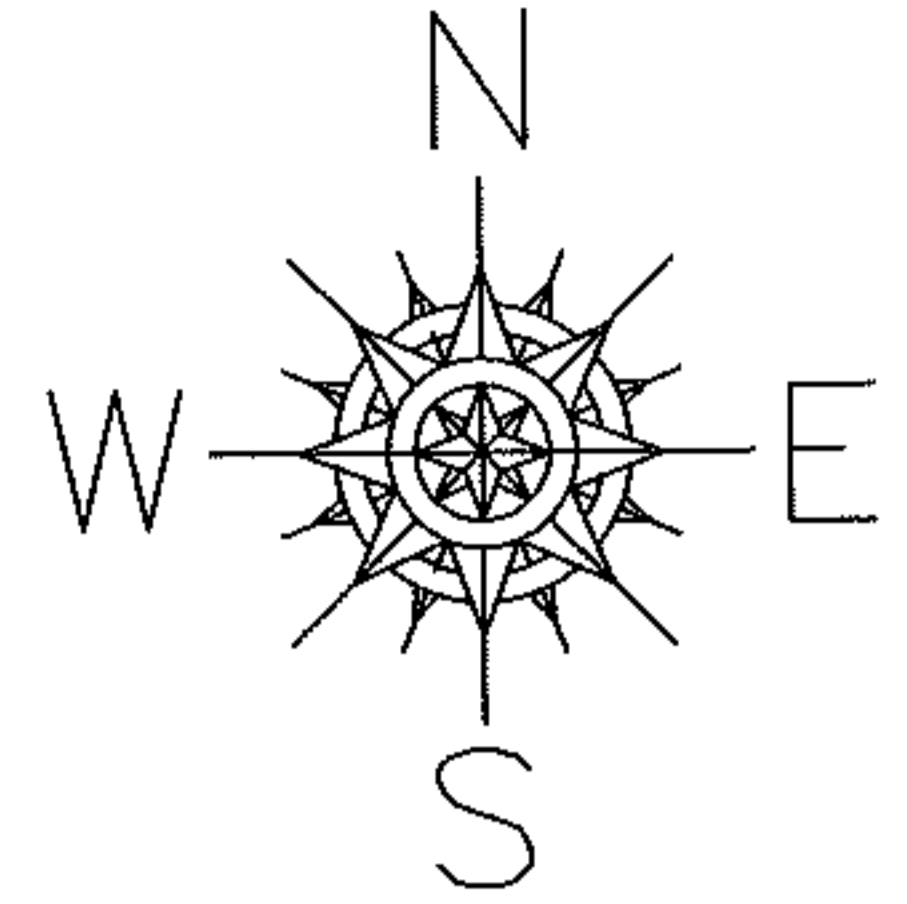

PARKSIDE SUB. #6
STREET NAME
SOUTHWOODS AVE
CHANGED TO:
NORTHWOODS AVE

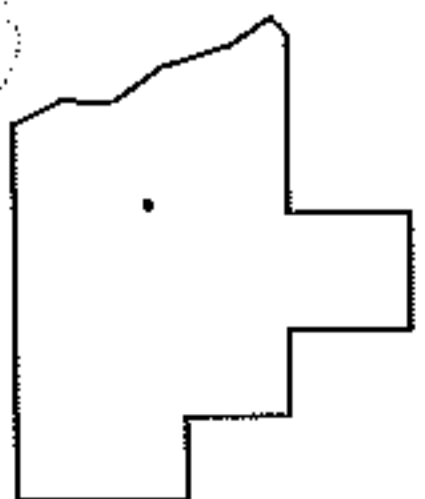

SPLITS/DEEDS PROCESSED

LORAIN COUNTY TAX MAP DEPARTMENT
226 MIDDLE AVE. ELYRIA, OHIO

SURVEYED BY: DALE R. HAYWOOD
CLOSURE: N/A
MAP PAGE(S): 18-00-026-A
APPROVED BY: DRH DATE: 11/3/2008
SCALE: NOT TO SCALE PRIOR INST.: PV 92/78