
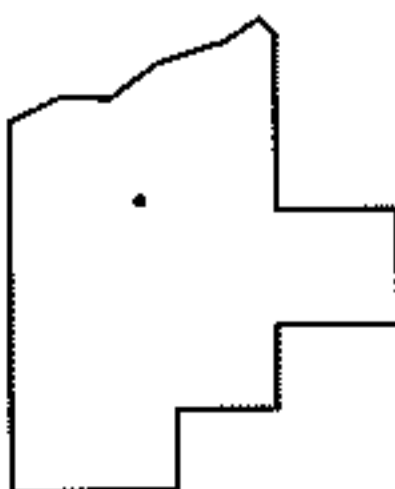
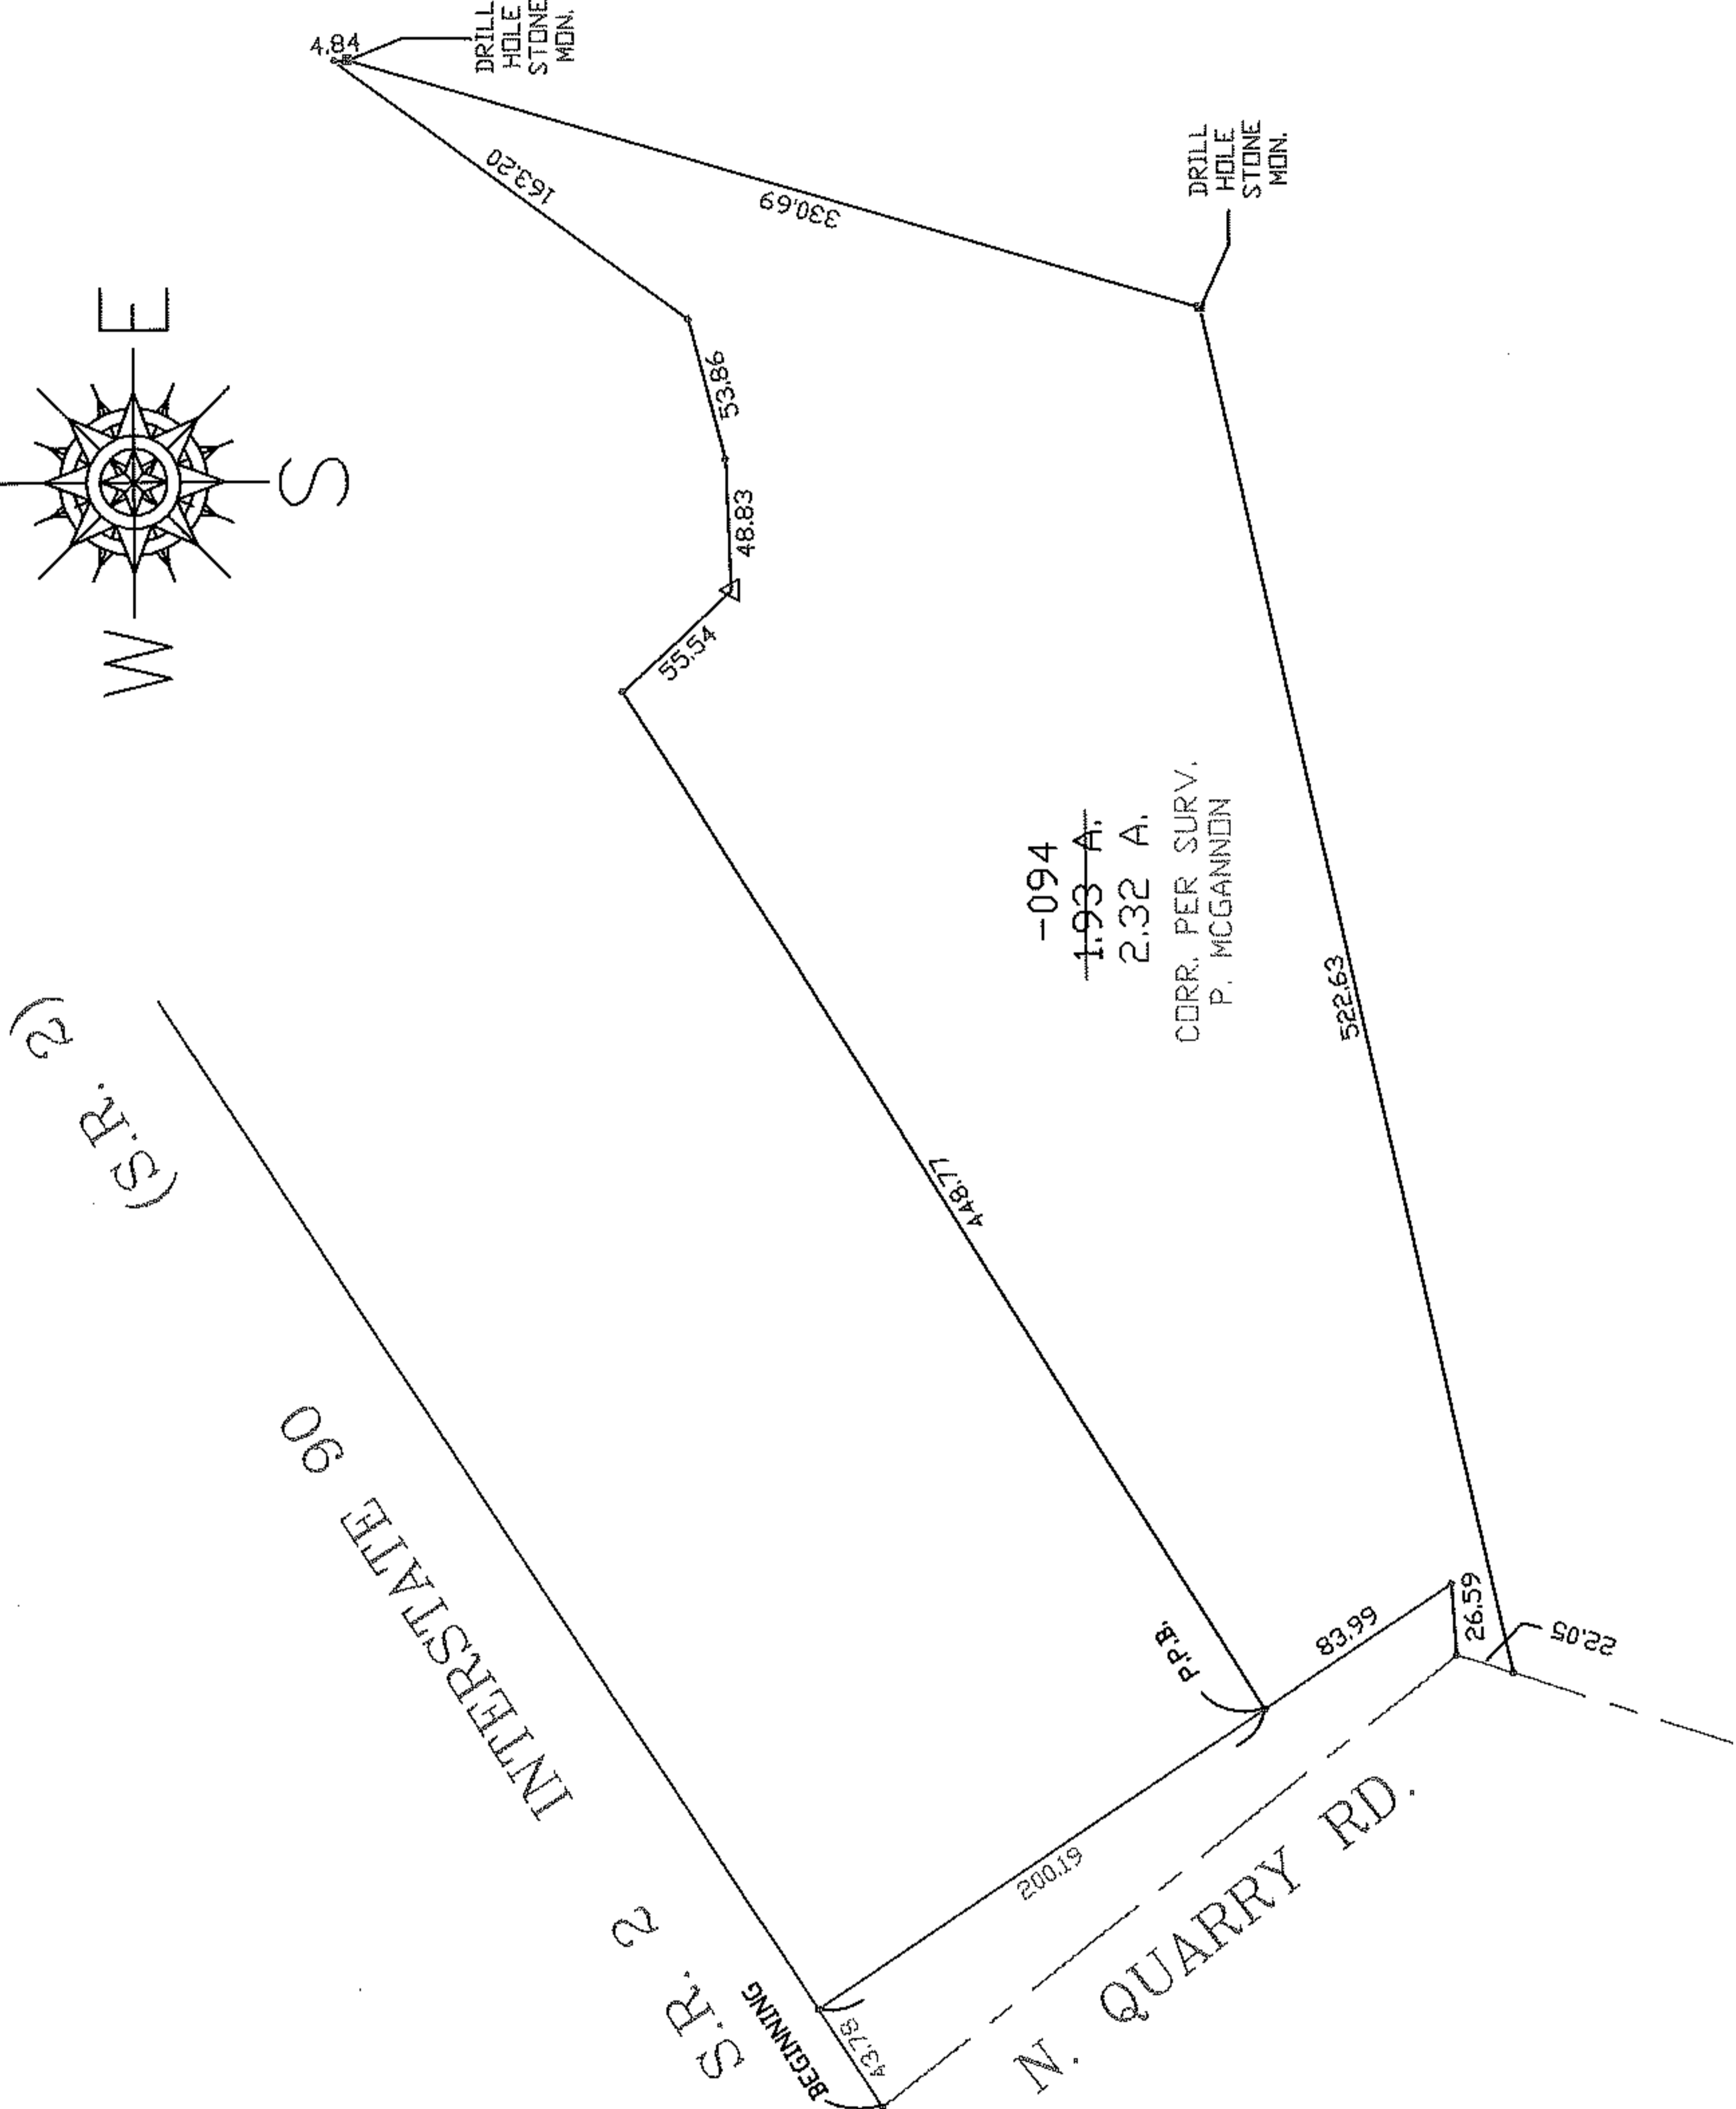


PARENT PARCEL: 05-00-099-000-094

CHILD PARCEL: XX-XX-XXX-XXX-XXX

STARTING POINT: I.P. FOUND CL OF QUARRY AND SOUTH R.O.W. OF S.R. 2

NO. 08-01703-C

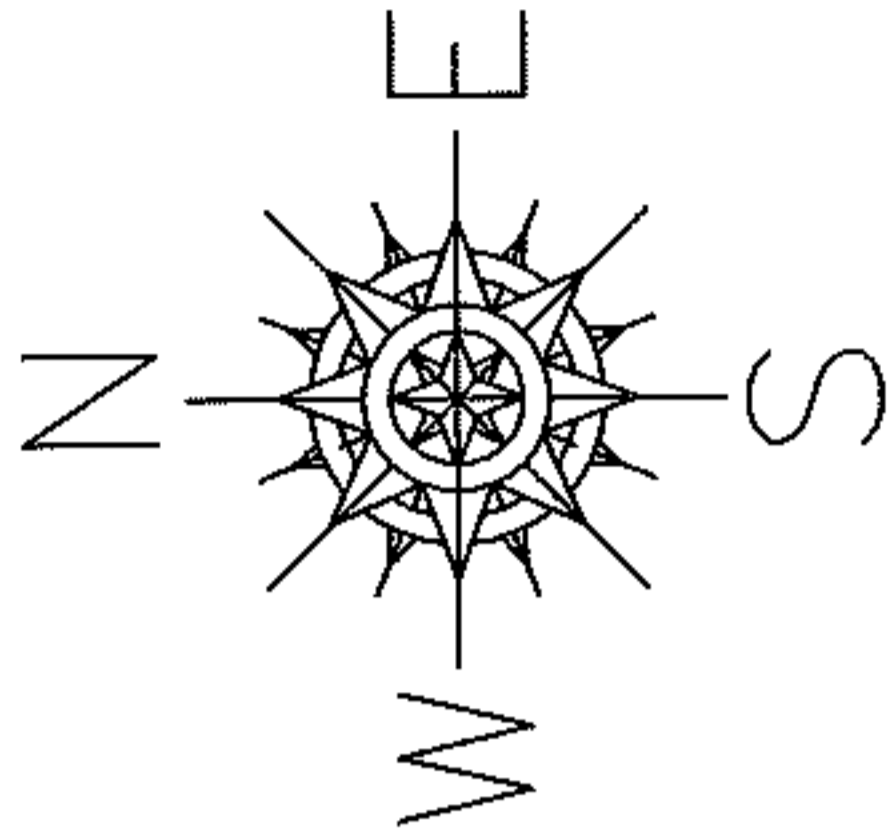

SPLITS/DEEDS PROCESSED

LORAIN COUNTY TAX MAP DEPARTMENT
226 MIDDLE AVE. ELYRIA, OHIO

SURVEYED BY: PATRICK A. MCGANNON
 CLOSURE: 0.01 : 10,000
 MAP PAGE(S): 05-00-099-C
 APPROVED BY: TJS DATE: 10/21/08
 SCALE: 1" = 100' PRIOR INSTRUMENT: 20050091338