

RASIER




PARENT PARCEL: 04-00-011-107-177

08-01713-A

CHILD PARCEL: --SAME--

STARTING POINT: INT CL HARRIMAN TRAIL AND STONEY RIDGE RD

AC. CORR. PER SURVEY M. SPELLACY

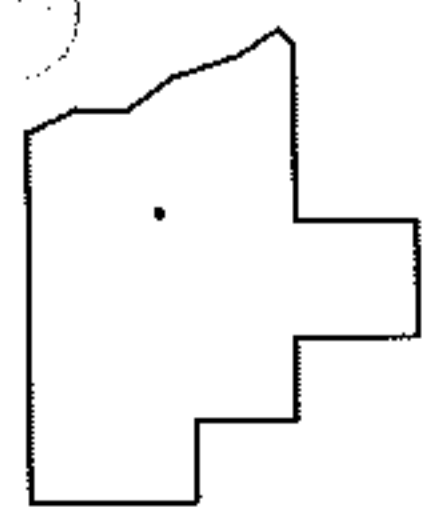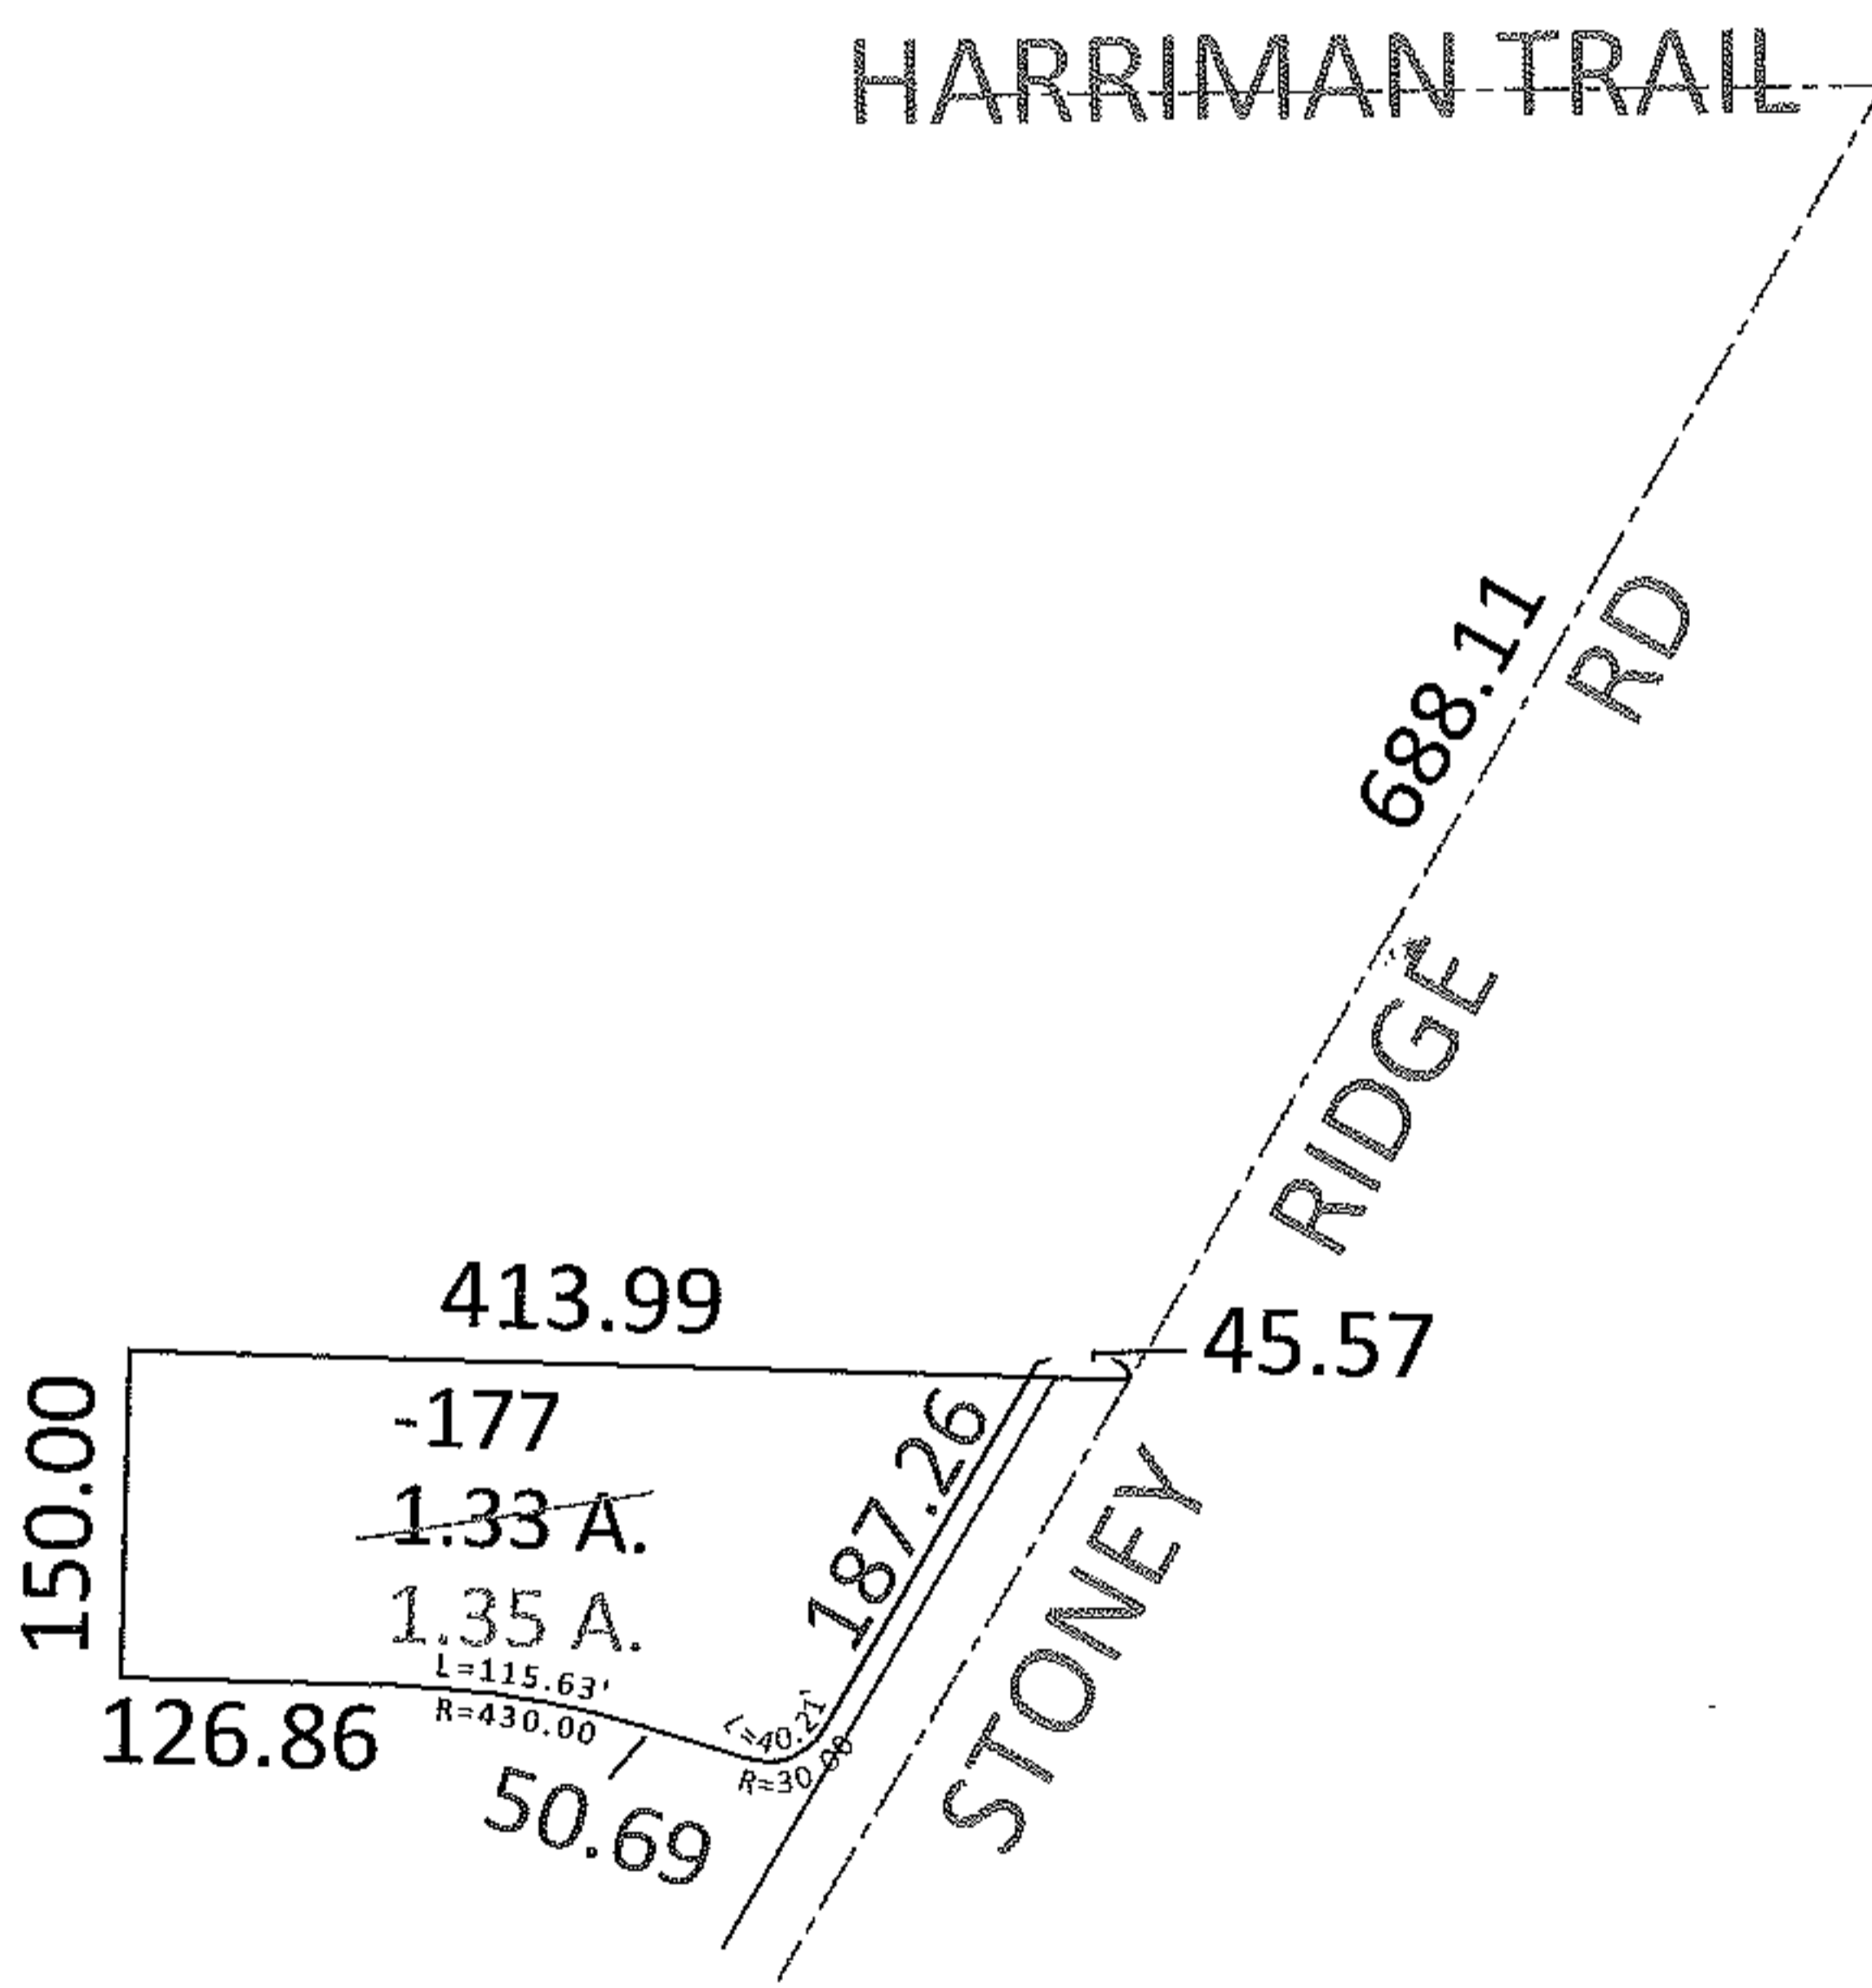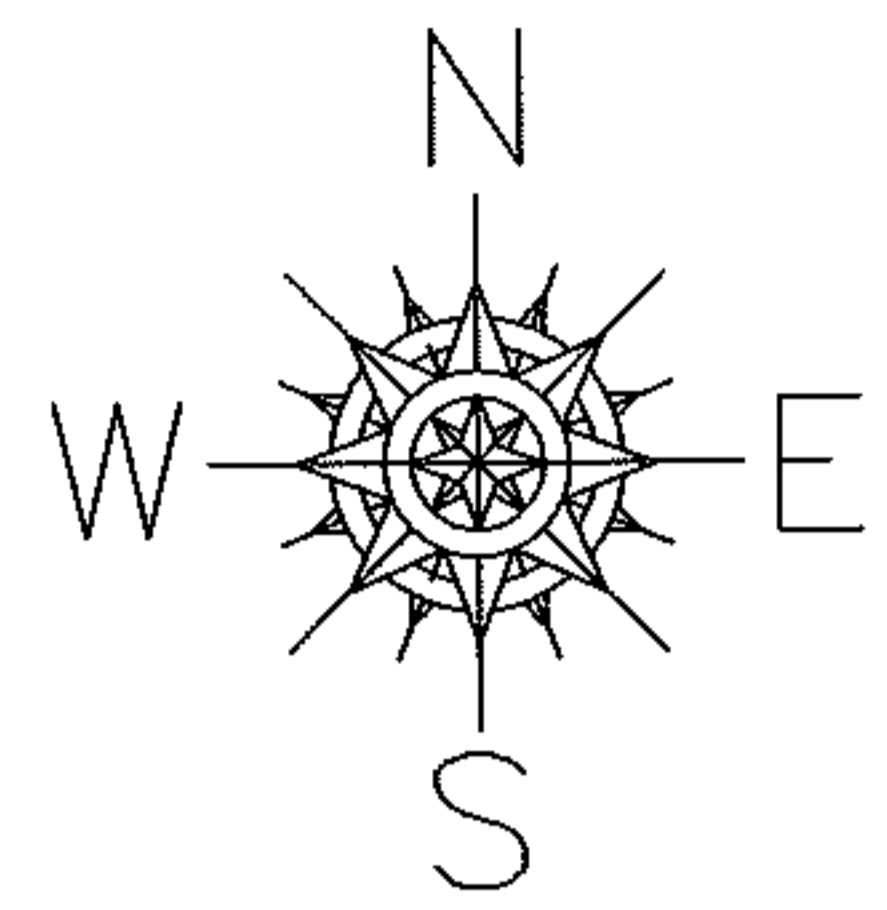

SPLITS/DEEDS PROCESSED

LORAIN COUNTY TAX MAP DEPARTMENT
226 MIDDLE AVE. ELYRIA, OHIO

SURVEYED BY: MICHAEL P. SPELLACY
 CLOSURE: 1:10,000
 MAP PAGE(S): 04-00-011-G
 APPROVED BY: DRH DATE: 11/3/2008
 SCALE: 1"= 200 PRIOR INST.: 20080240817