
PARENT PARCEL: 03-00-098-126-018


CHILD PARCEL: \_\_-SAME--

ARTING POINT: S/L 45 HIGHLAND ADDITION

08-01719-C

## FRONTAGE CORR PER DEED

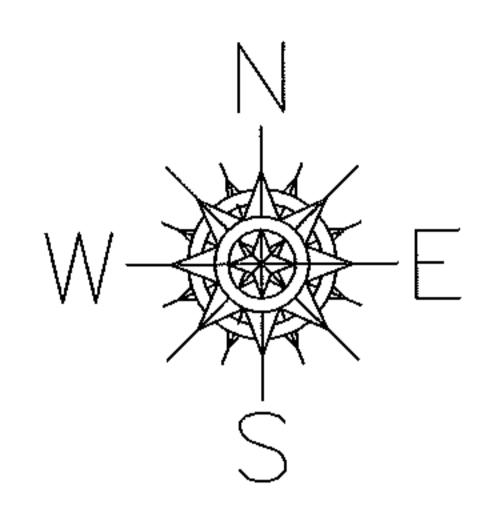

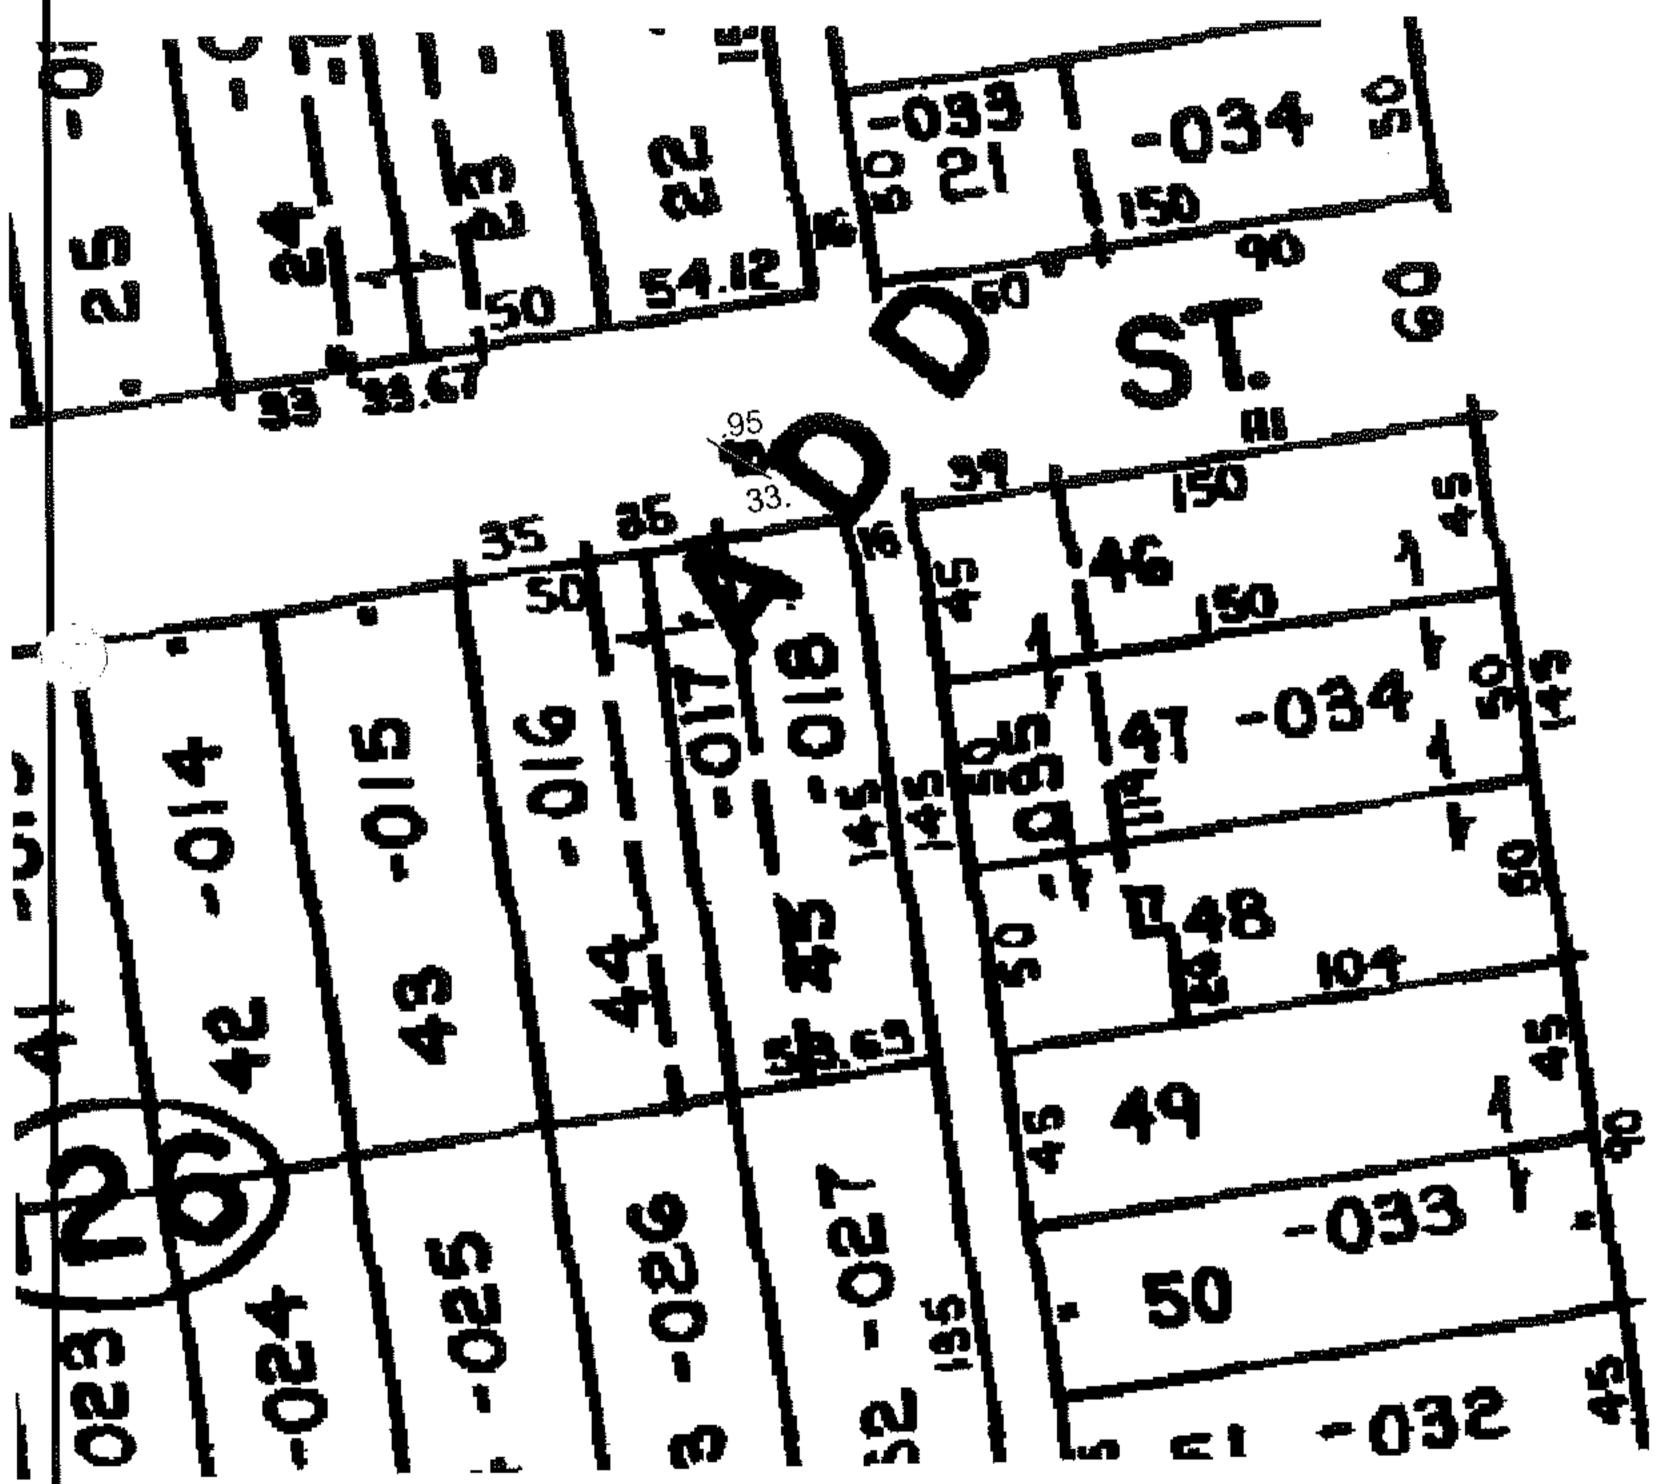

## SPLITS/DEEDS PROCESSED

LORAIN COUNTY TAX MAP DEPARTMENT 226 MIDDLE AVE. ELYRIA, OHIO

SURVEYED BY: N/A

CLOSURE: N/A

MAP PAGE(S): <u>03-00-098-A</u>

APPROVED BY: <u>DRH</u> DATE: <u>11/17/2008</u>

SCALE: NOT TO SCALE PRIOR INST.: OR 743/338