

RASTER




PARENT PARCEL: 06-24-123-000-017

CHILD PARCEL: --SAME--

STARTING POINT: S/L 123 TATTERSAL'S SUB.

08-01728-C

DUPLICATE CORR.
NO MAP CORR.

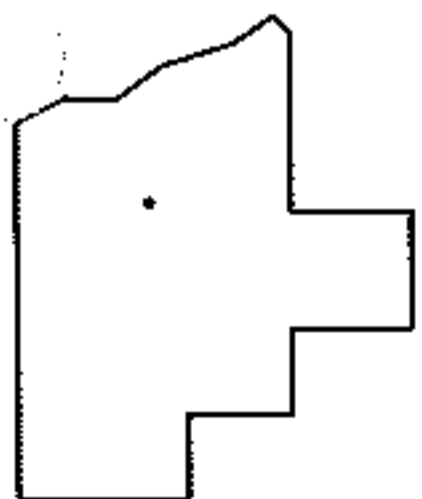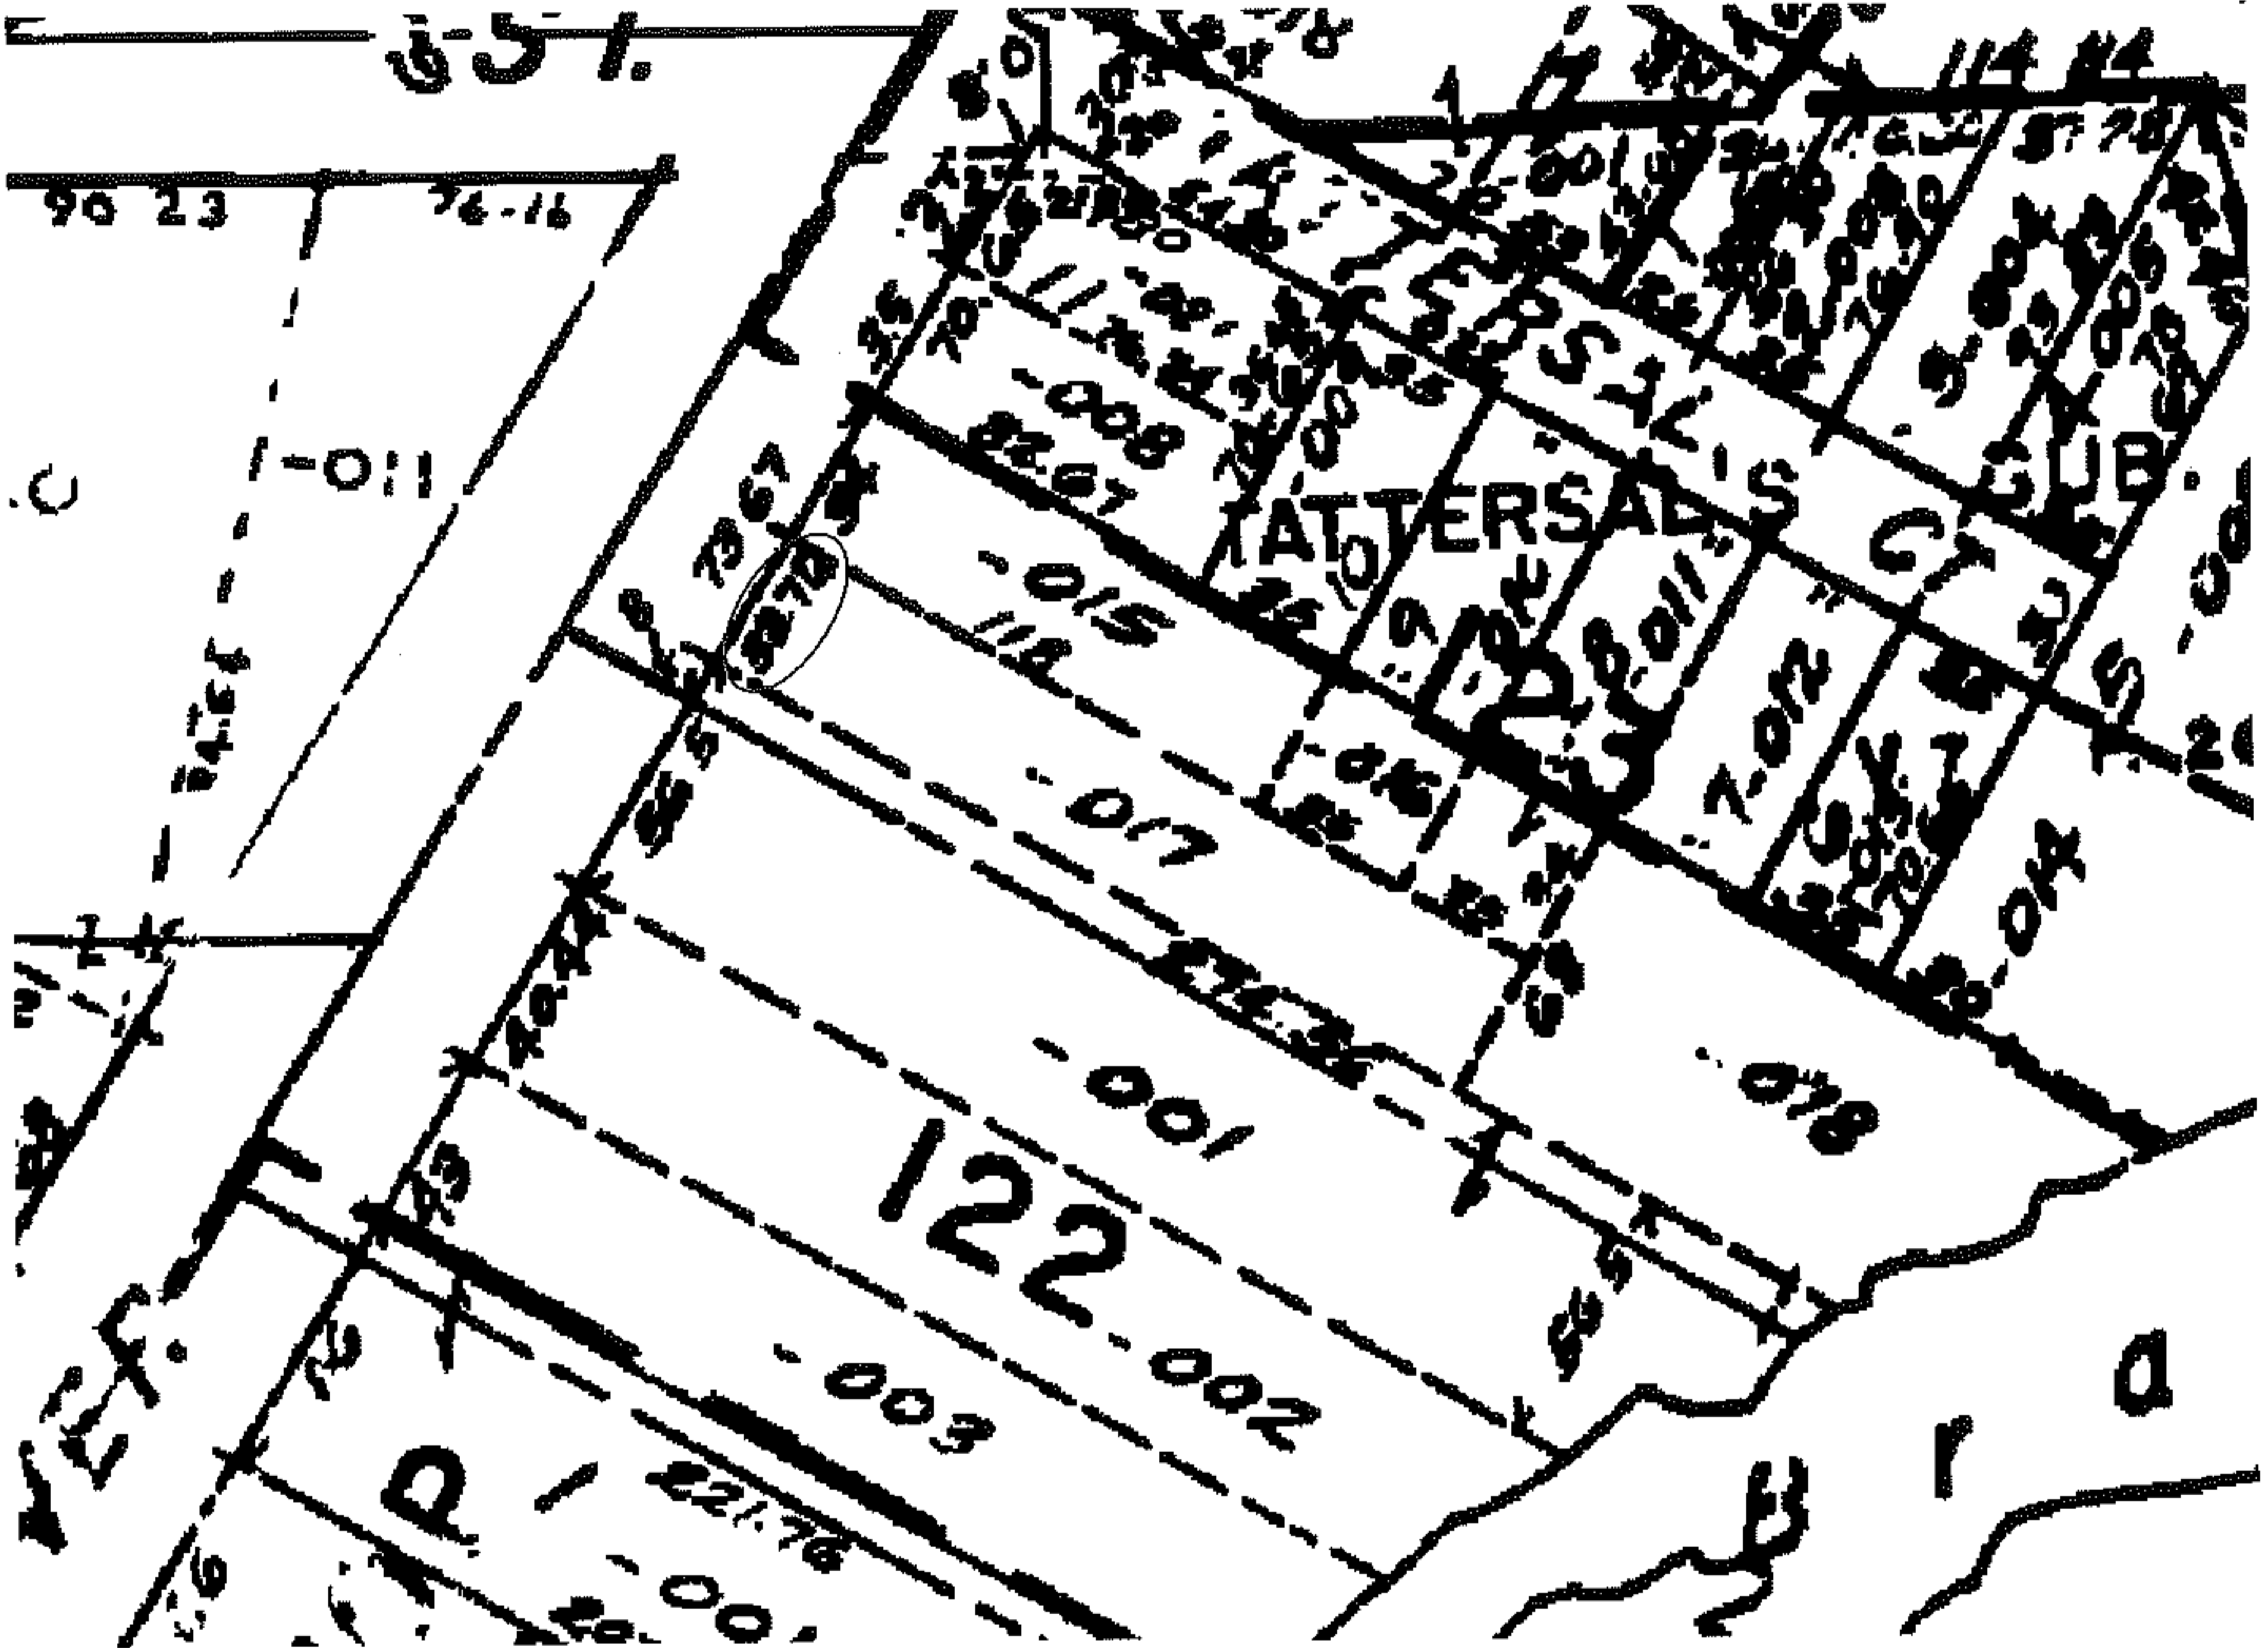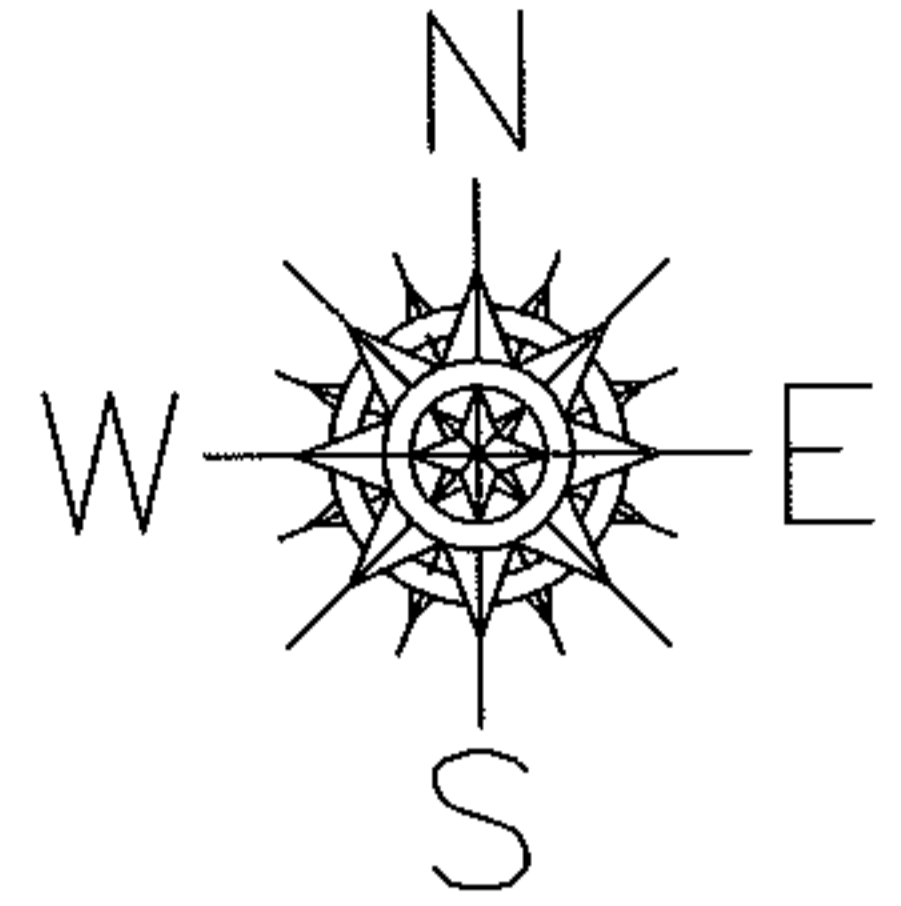

SPLITS/DEEDS PROCESSED

LORAIN COUNTY TAX MAP DEPARTMENT
226 MIDDLE AVE. ELYRIA, OHIO

SURVEYED BY: N/A

CLOSURE: N/A

MAP PAGE(S): 06-100

APPROVED BY: DRH DATE: 12/8/2008

SCALE: NOT TO SCALE PRIOR INST.: OR 1451/0395