

RASTER

PARENT PARCEL: 11-00-036-112-004




CHILD PARCEL: --SAME--

STARTING POINT: S/L 455 IN EATON HOME SUB

08-01731-C

DIM
CORR
PER
PLAT

BLVD. 120

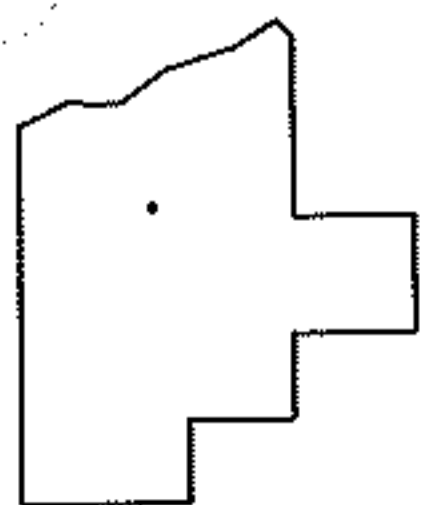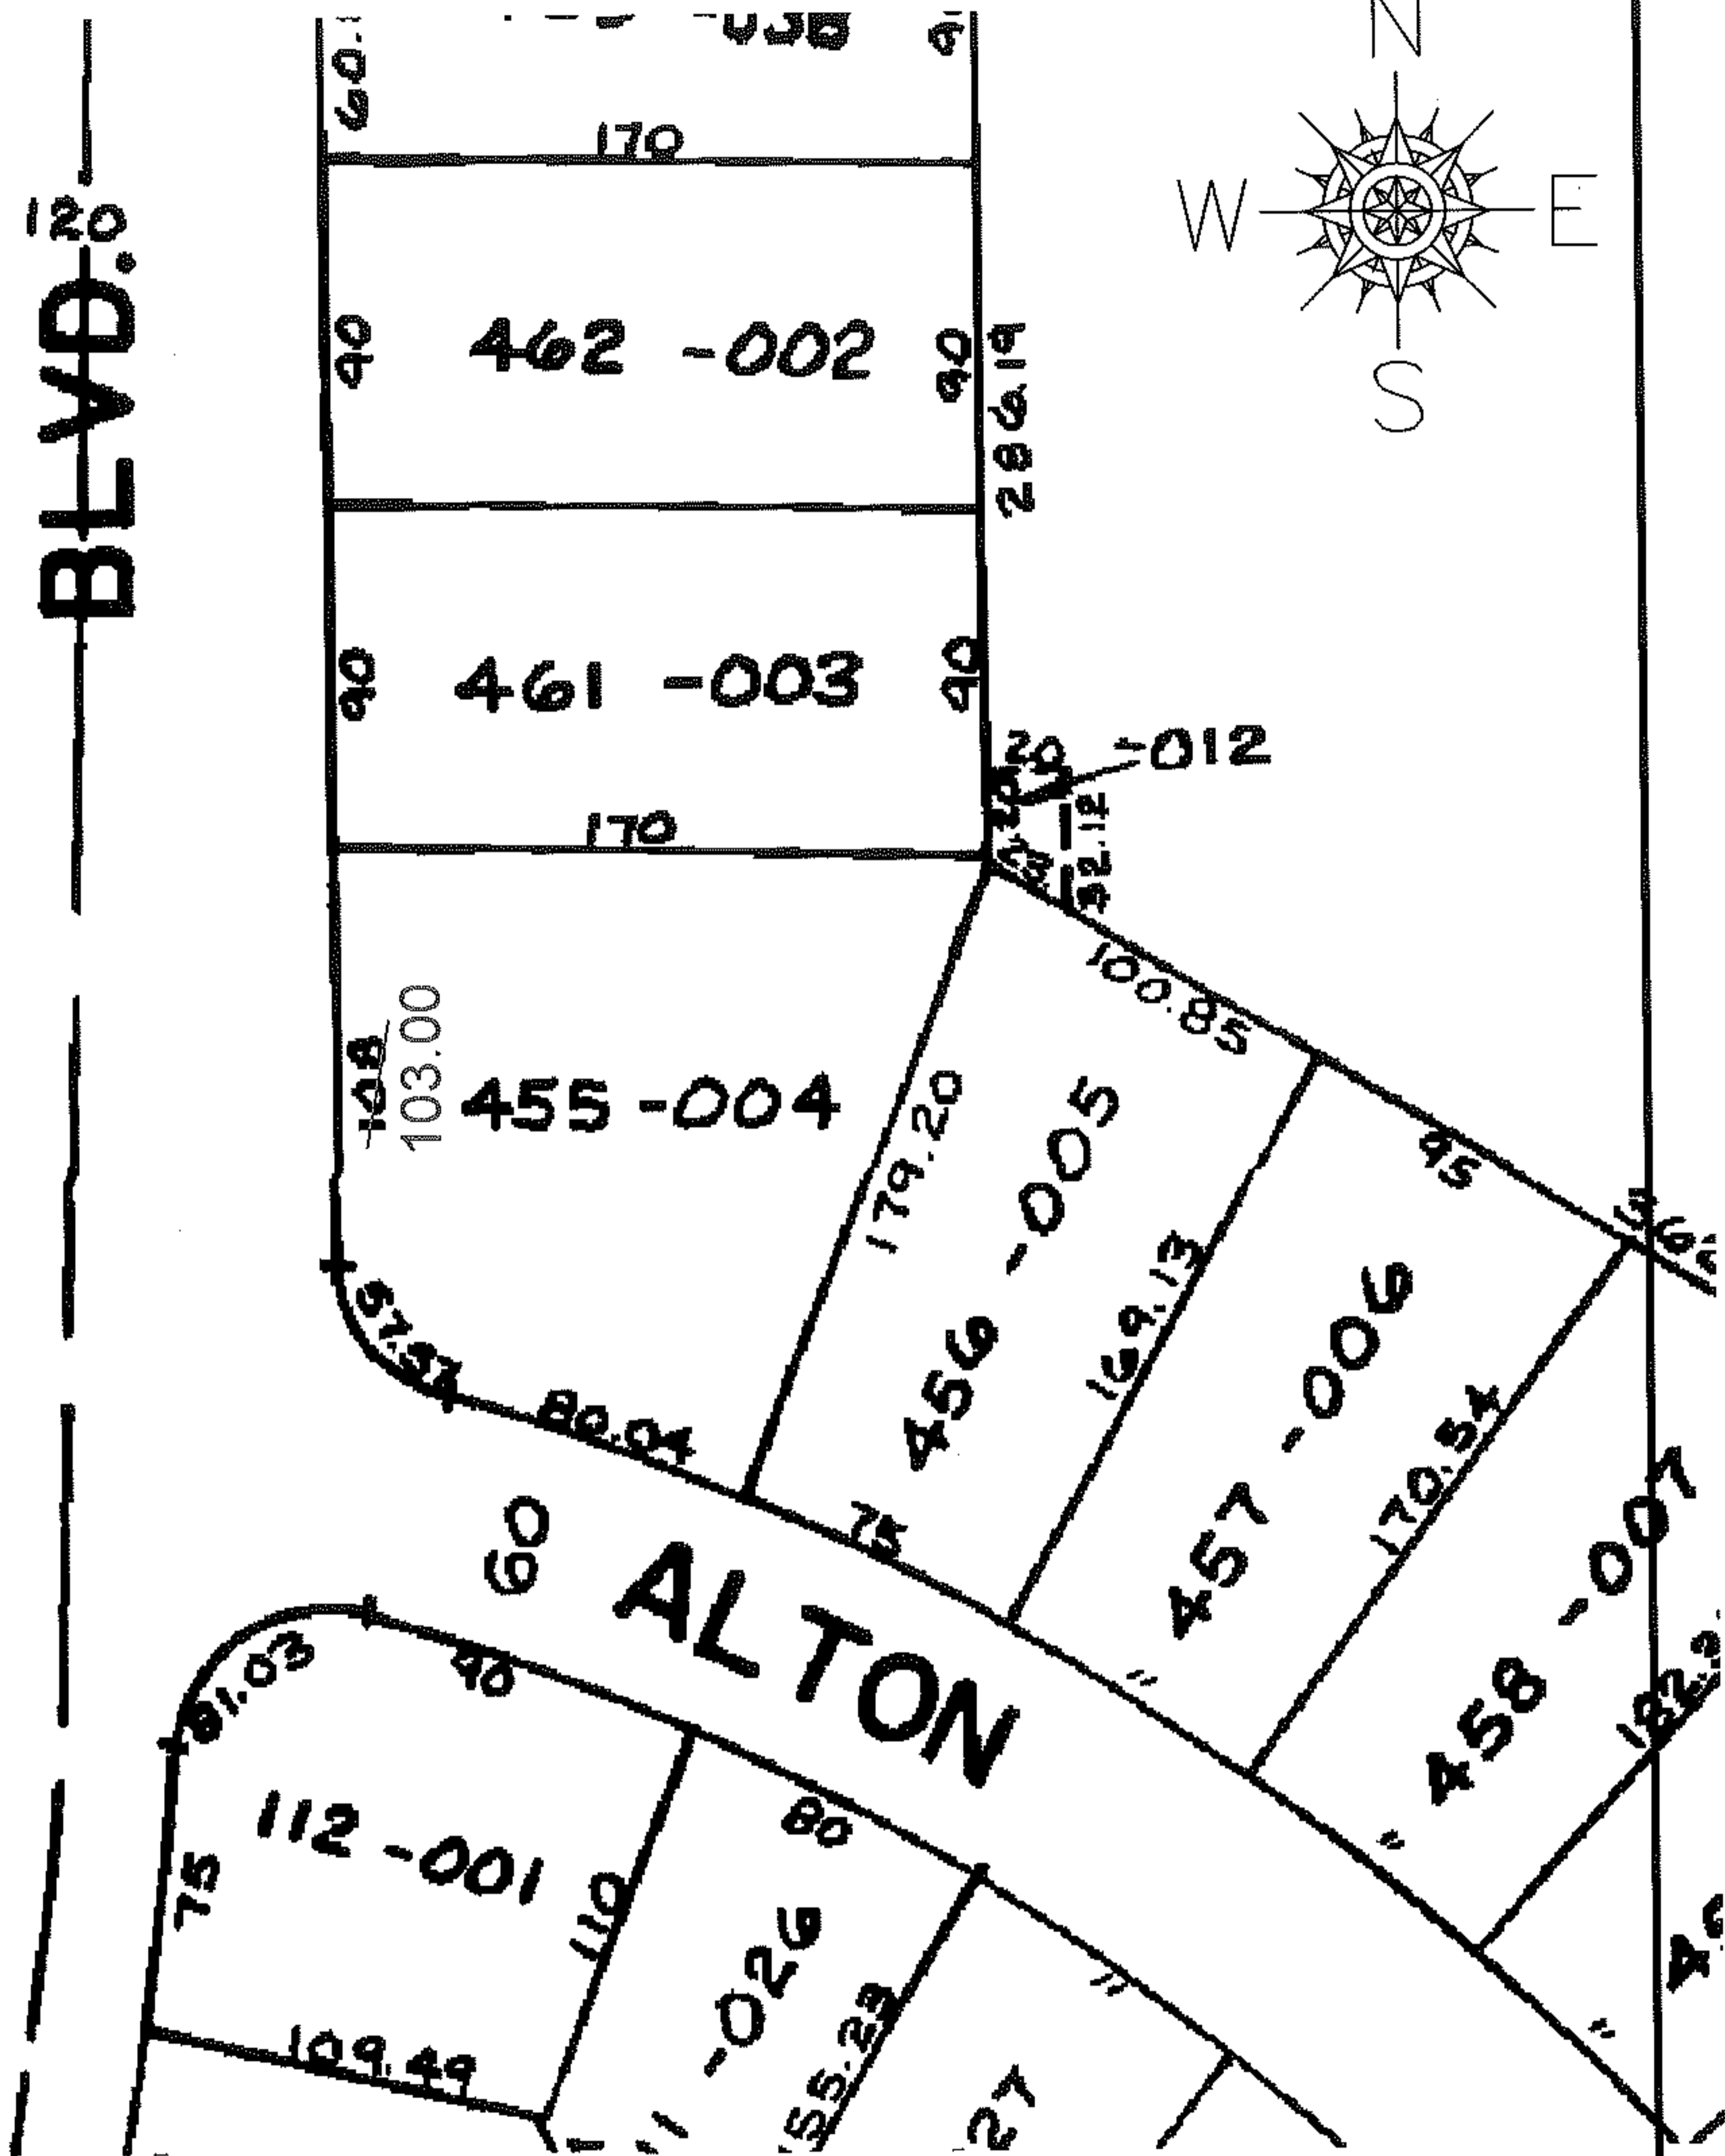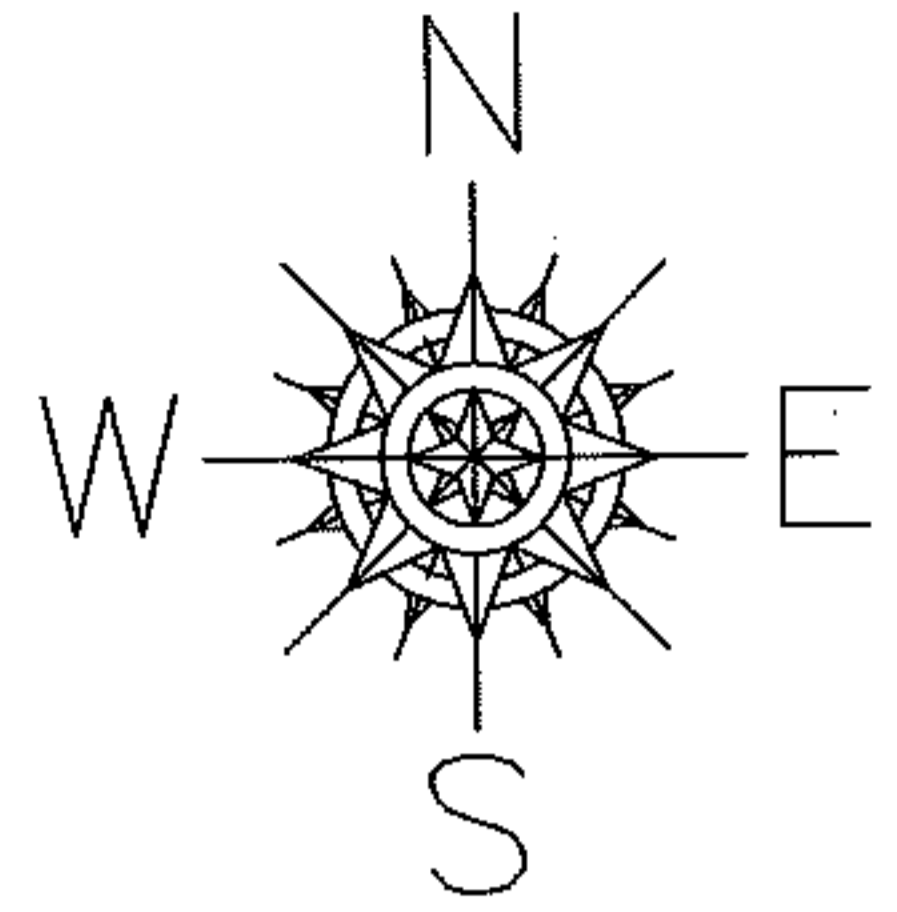

SPLITS/DEEDS PROCESSED

LORAIN COUNTY TAX MAP DEPARTMENT
226 MIDDLE AVE. ELYRIA, OHIO

SURVEYED BY: N/A

CLOSURE: N/A

MAP PAGE(S): 11-00-036-B

APPROVED BY: DRH DATE: 12/10/2008

SCALE: NOT TO SCALE PRIOR INST.: 20070188525