
PARENT PARCEL: 02-02-029-103-004


CHILD PARCEL: __--SAME--

RTING POINT: INT CHALMERS ST AND HARBORVIEW BLVD

09-01747-C

DEPTH CORR PER PLAT AND DEED

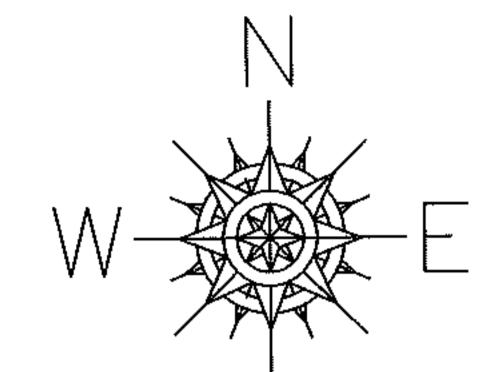

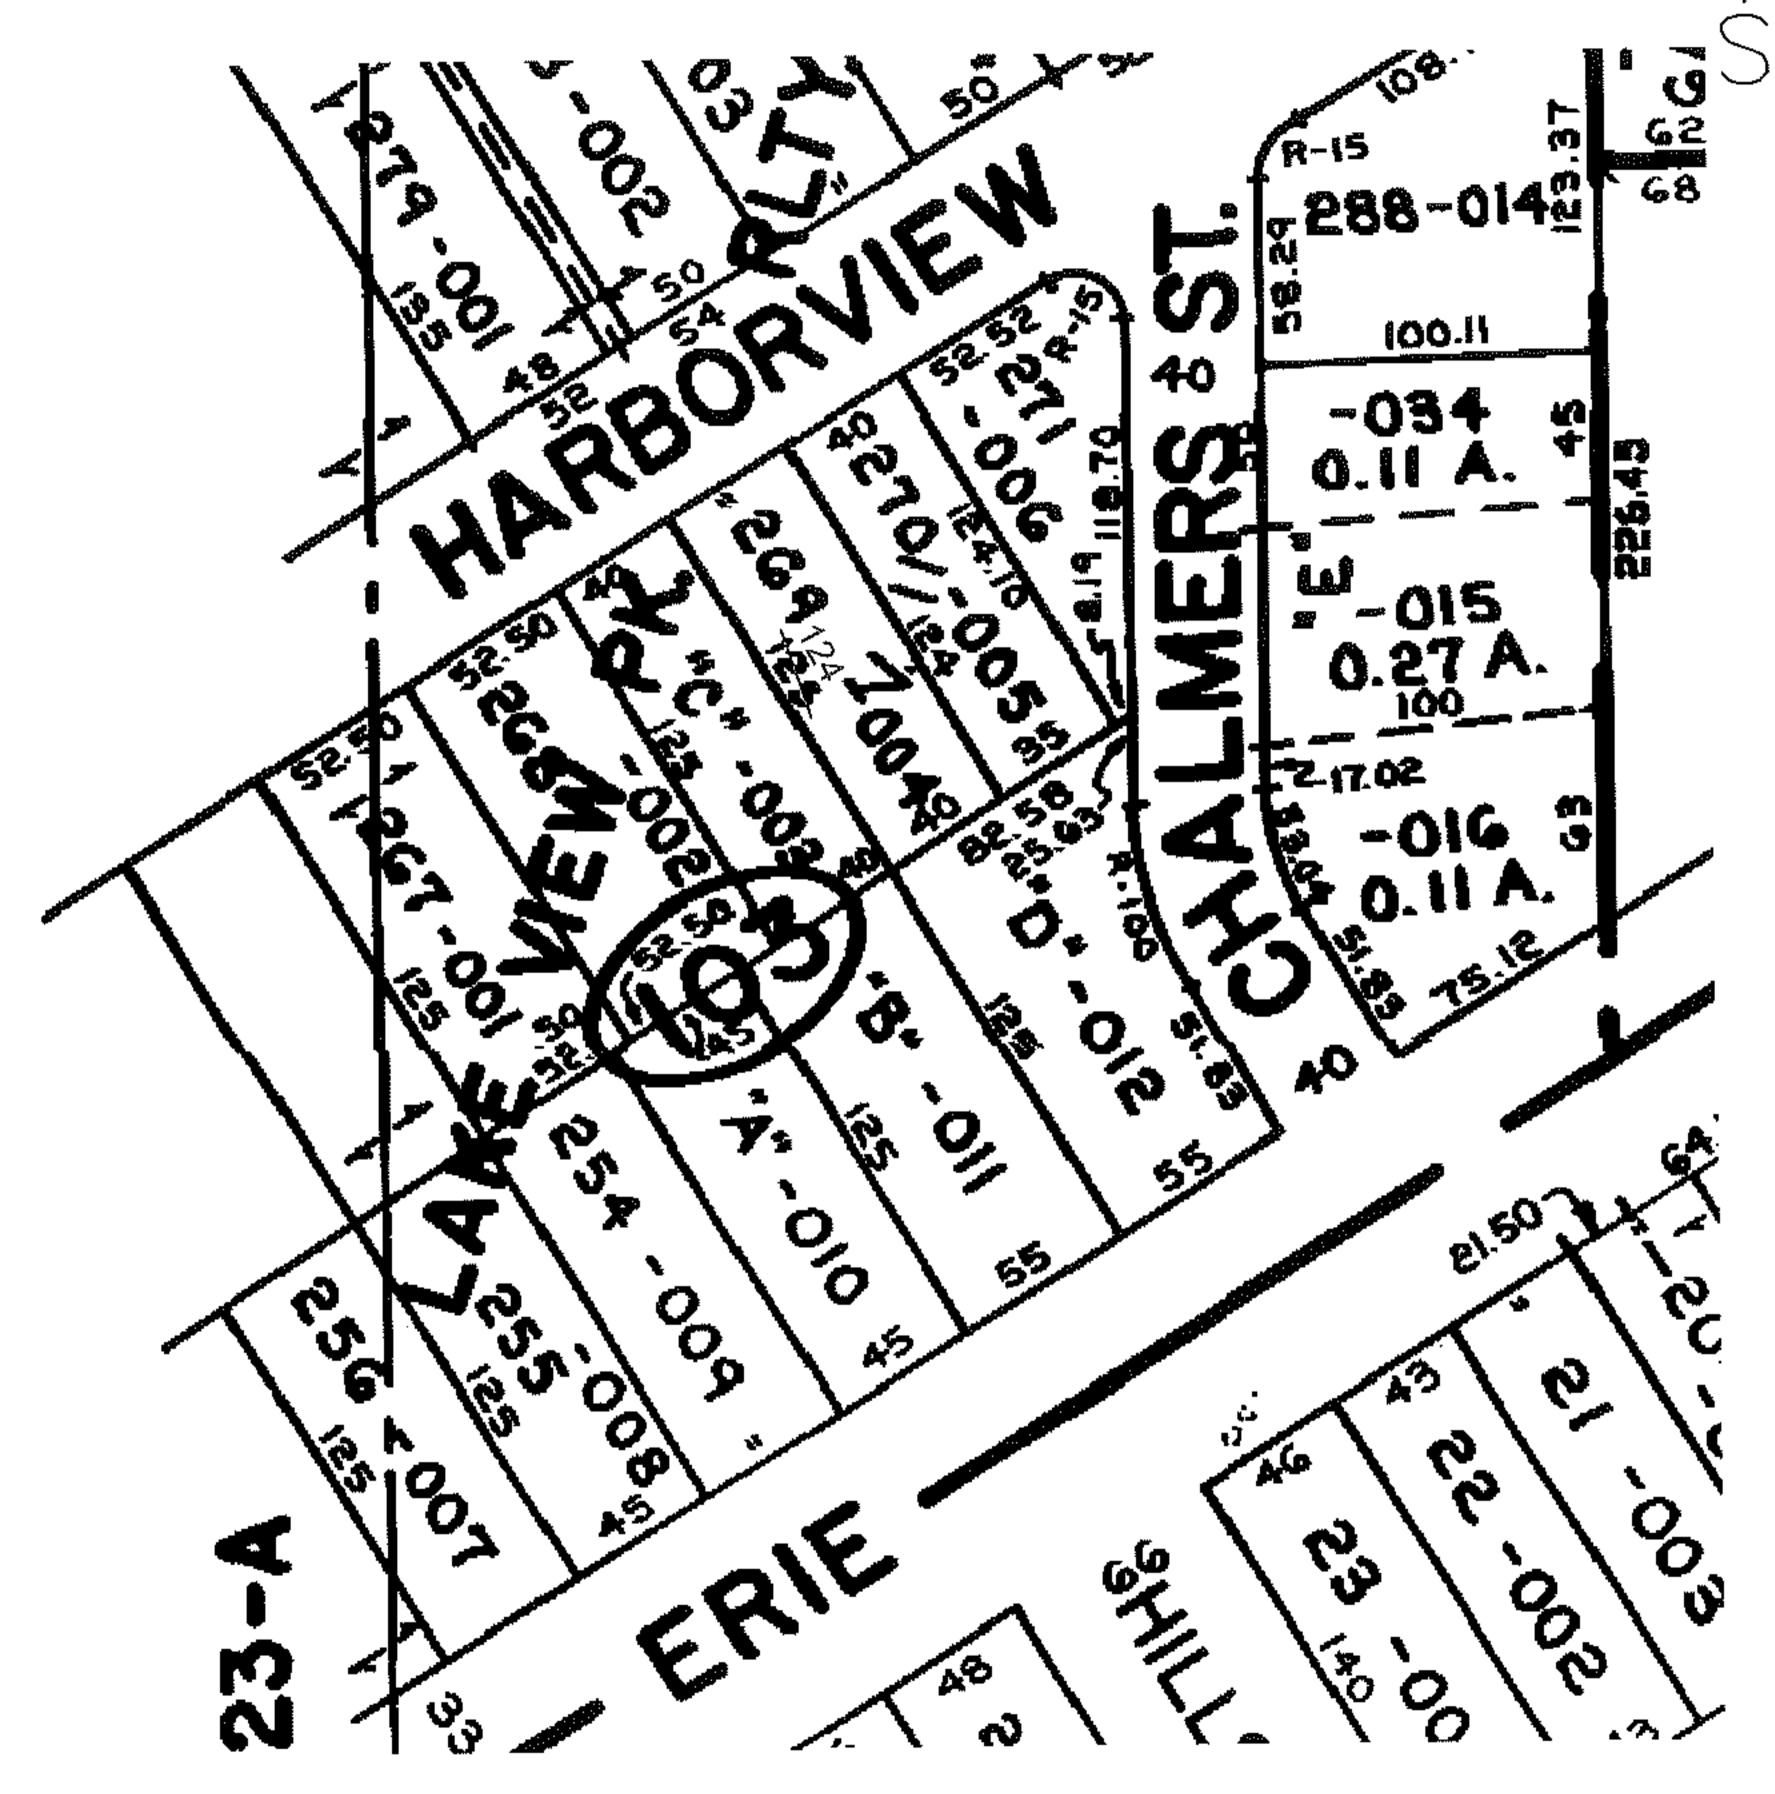

SPLITS/DEEDS PROCESSED

LORAIN COUNTY TAX MAP DEPARTMENT 226 MIDDLE AVE. ELYRIA, OHIO

SURVEYED BY: N/A

CLOSURE: N/A

MAP PAGE(S): 02-02-029

APPROVED BY: <u>DRH</u> DATE: <u>2/13/2009</u>

SCALE: NOT TO SCALE PRIOR INST.: PV 11/36