

RASTER


PARENT PARCEL: 02-03-002-<sup>103</sup>013-002

09-01754-D

CHILD PARCEL: --SAME--

STARTING POINT: INT CL WEST ERIE AVE AND OAK POINT RD

AC. CORR.  
PER SURVEY  
PAT MCGANNON

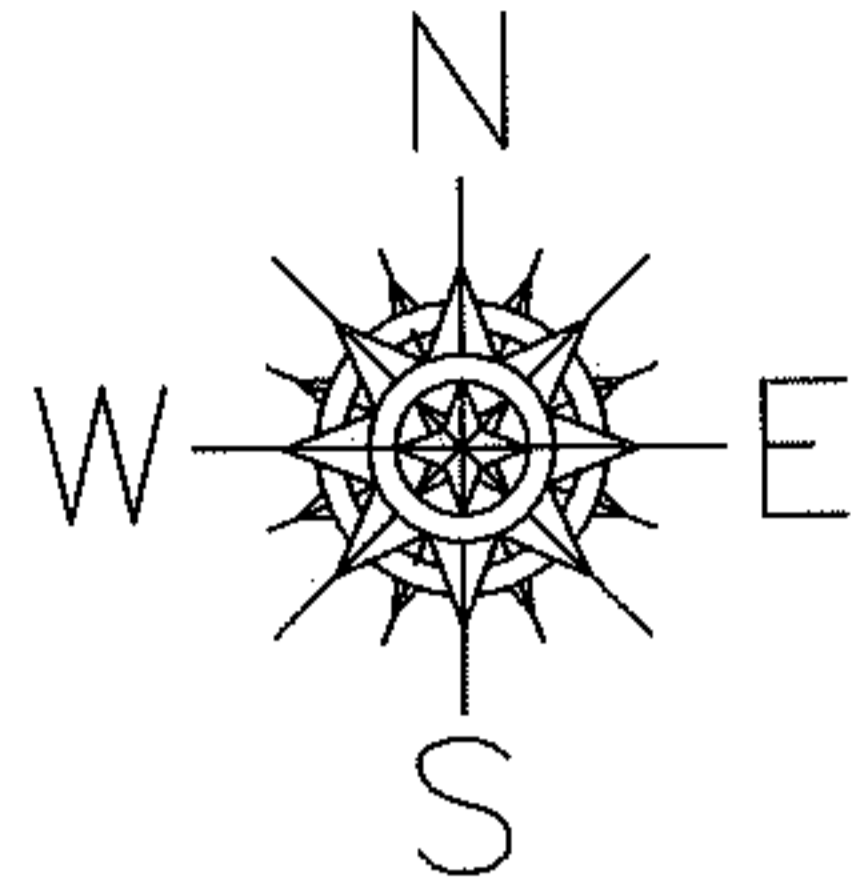

WEST ERIE AVE

OAK POINT RD

L=120.66'  
R=1964.86  
L=94.72'  
R=83.00

-002  
~~0.88 A.~~  
0.83 A.

185.81


214.00

177.99

12

54.37

30.18

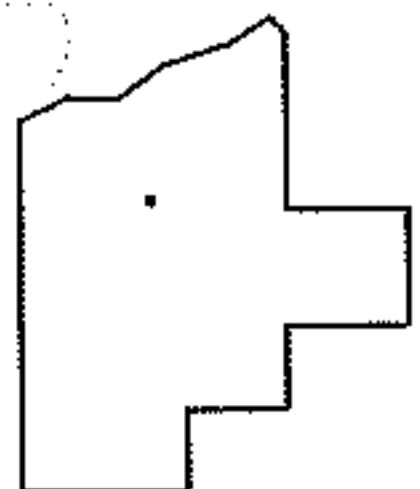

SPLITS/DEEDS PROCESSED

LORAIN COUNTY TAX MAP DEPARTMENT  
226 MIDDLE AVE. ELYRIA, OHIO

SURVEYED BY: PATRICK A. MCGANNON

CLOSURE: 1:10,000

MAP PAGE(S): 02-03-002-A

APPROVED BY: DRH DATE: 2/5/2009

SCALE: 1"= 50' PRIOR INST.: 20050067795