

RASTER




PARENT PARCEL: 14-00-016-000-032

CHILD PARCEL: --SAME--

STARTING POINT: INT CL S.R. 58 AND S.R. 20

09-01755-D

AC. CORR. PER SURVEY DALE HAYWOOD

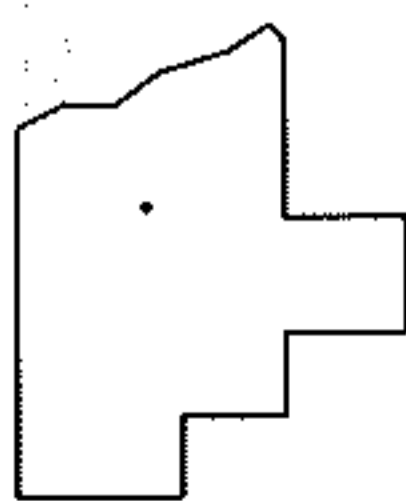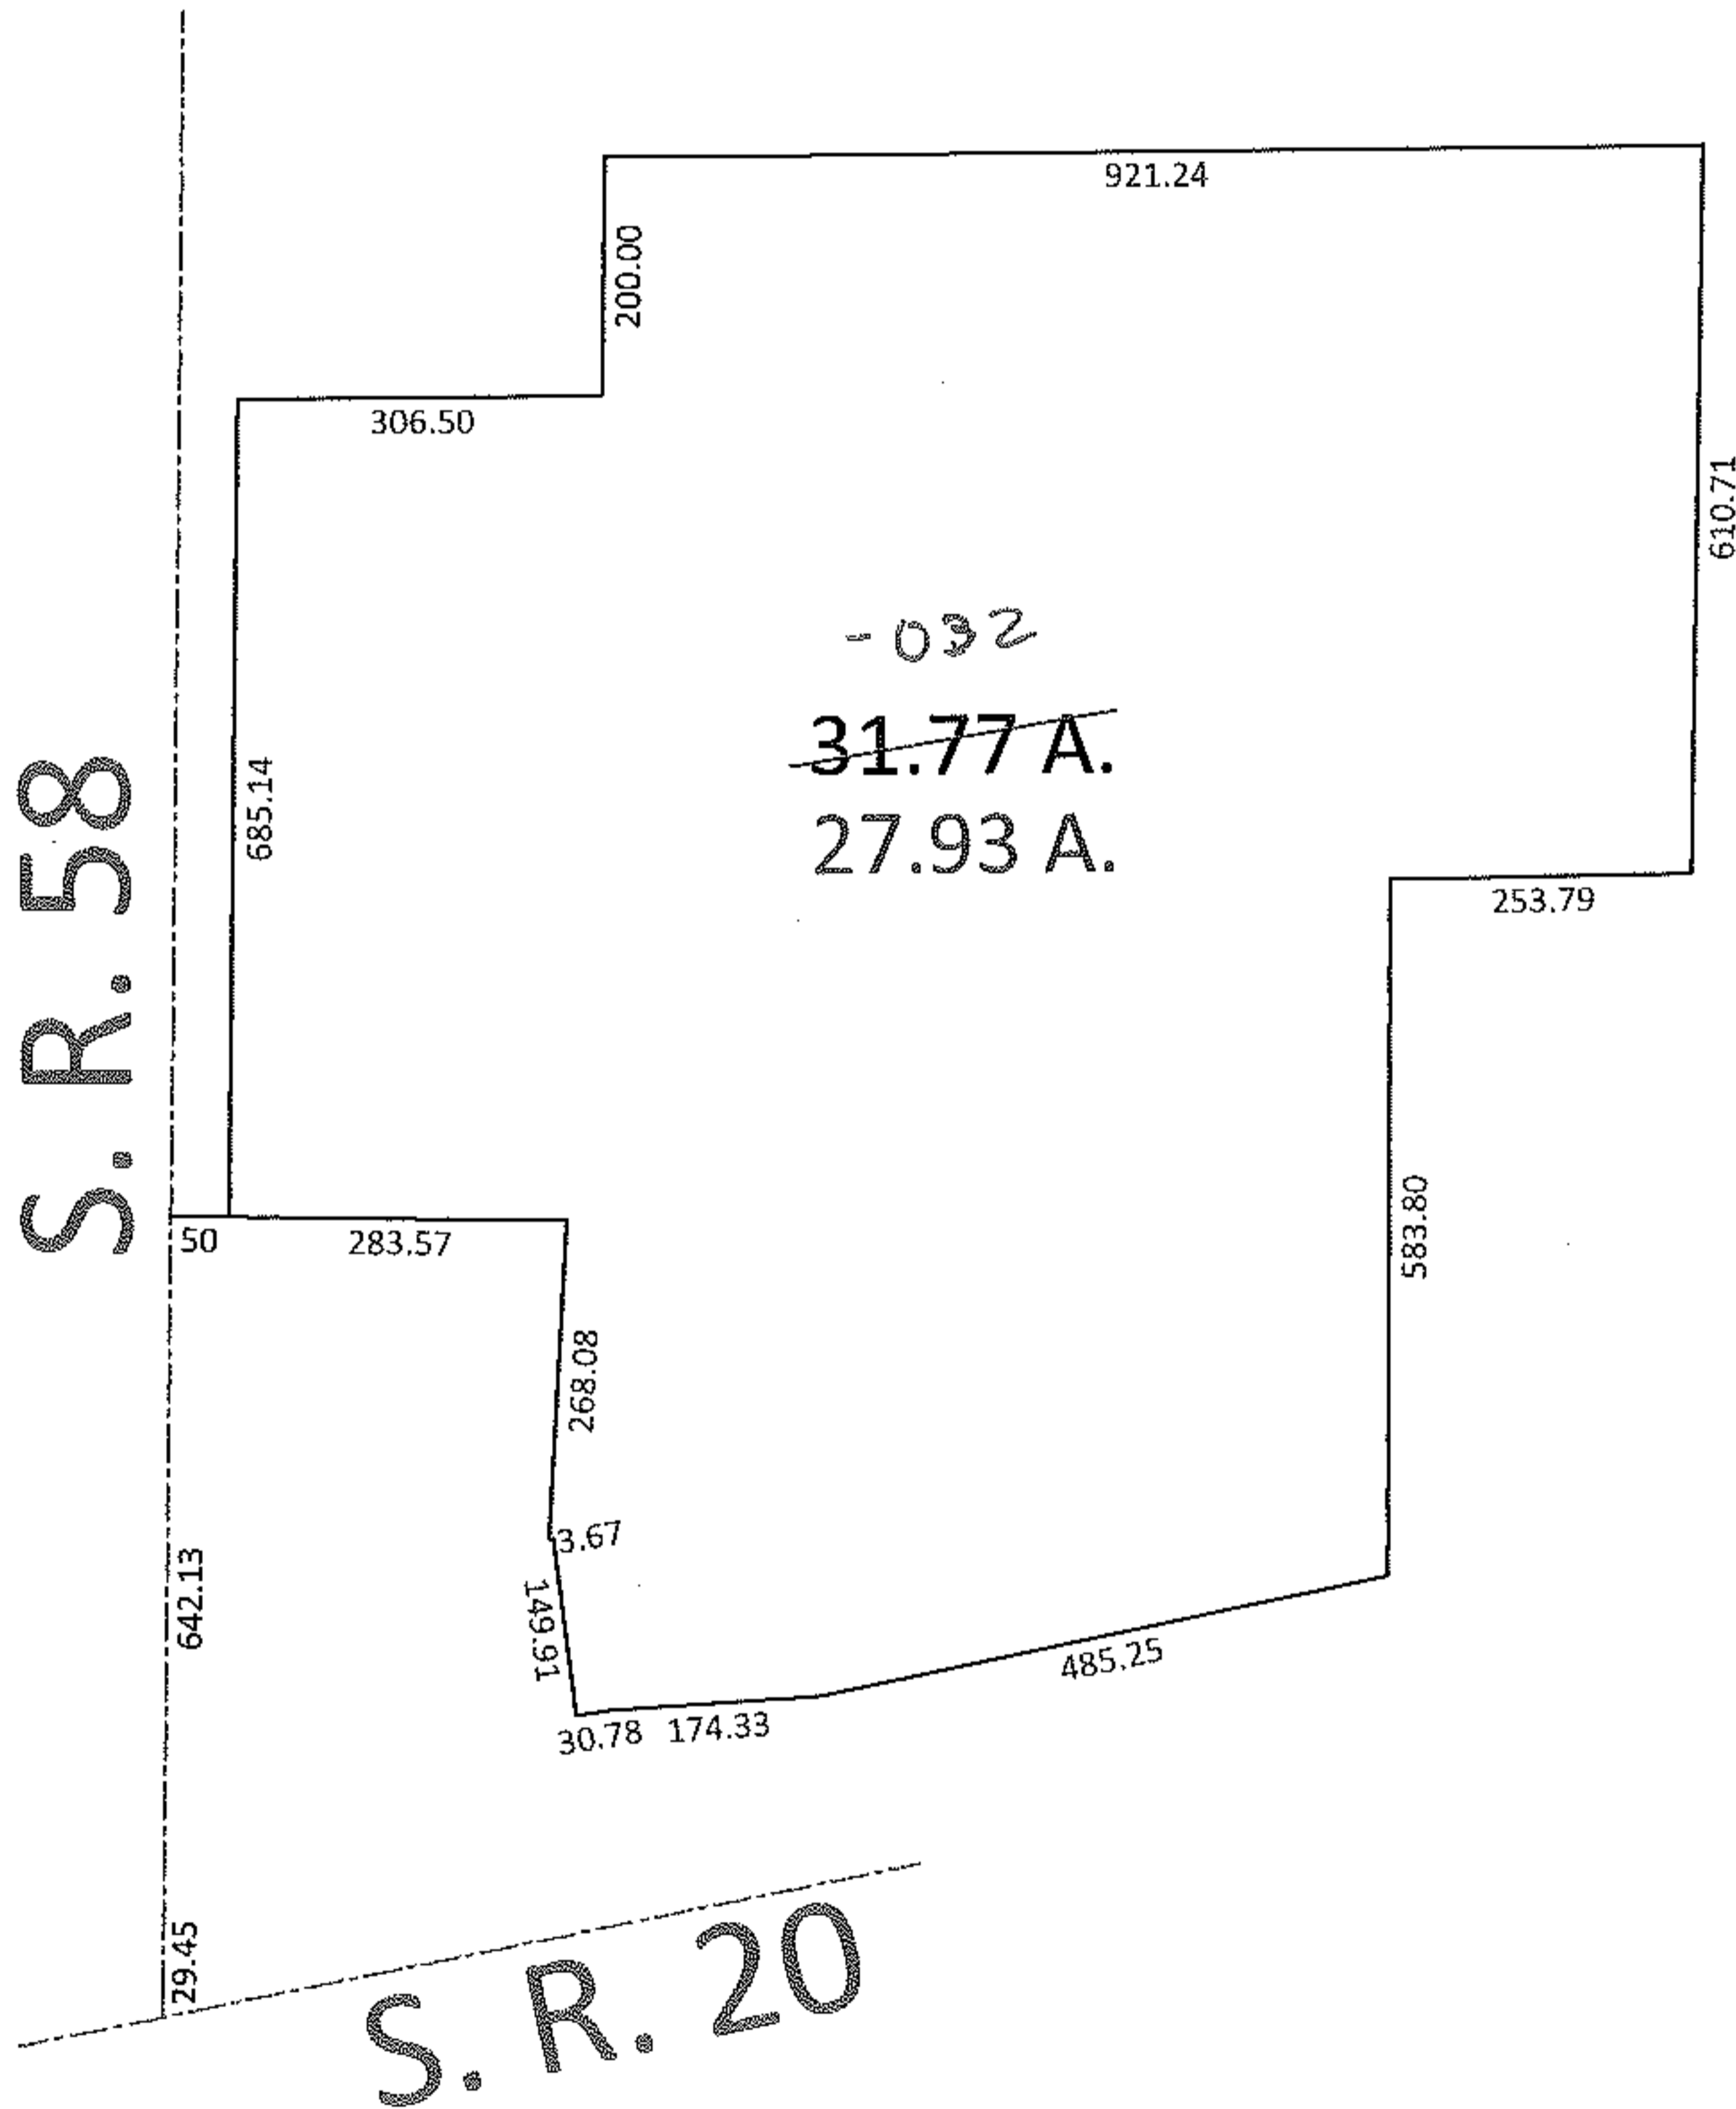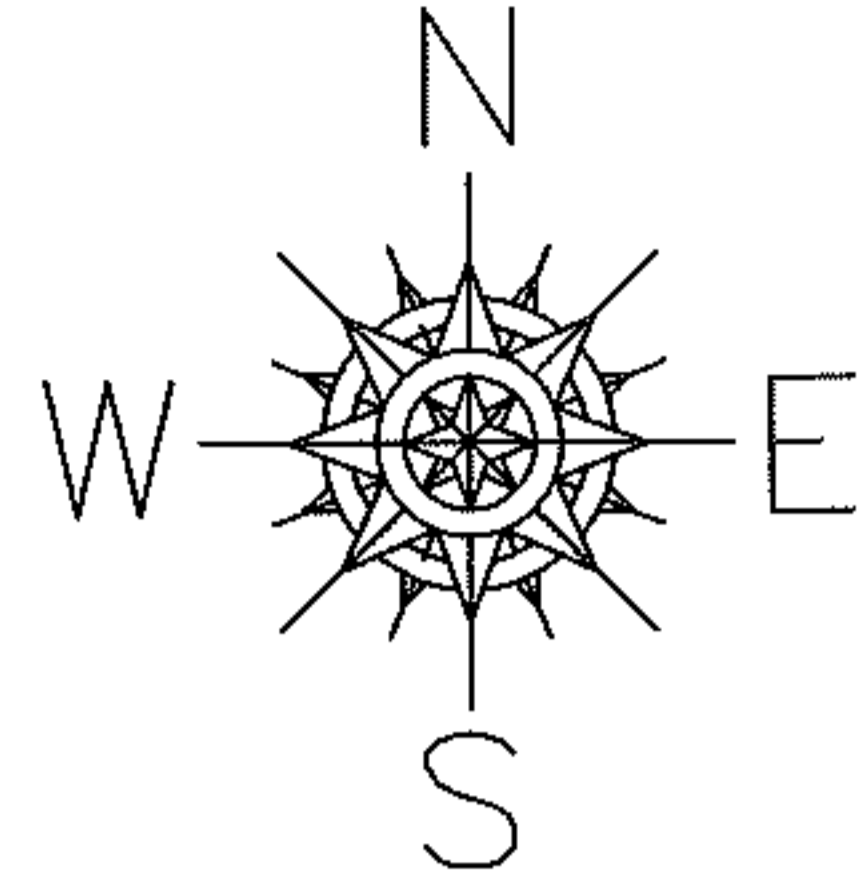

SPLITS/DEEDS PROCESSED
 LORAIN COUNTY TAX MAP DEPARTMENT
 226 MIDDLE AVE. ELYRIA, OHIO

SURVEYED BY: DALE HAYWOOD
 CLOSURE: 1:10,000
 MAP PAGE(S): 14-C
 APPROVED BY: DRH DATE: 2/13/2009
 SCALE: 1" = 300 PRIOR INSTRUMENT: OR 918/857