




PARENT PARCEL: 07-00-025-101-071, 07-00-026-105-007

CHILD PARCEL: 07-00-025-101-080 & -081, 07-00-025-106-062 & -063

07-00-026-105-008 & -009

NO. 09-01757-U

STARTING POINT: MON. BOX, CL OF BUTTERNUT RIDGE & CL OF FUTURE ST RT. 83 RAMP

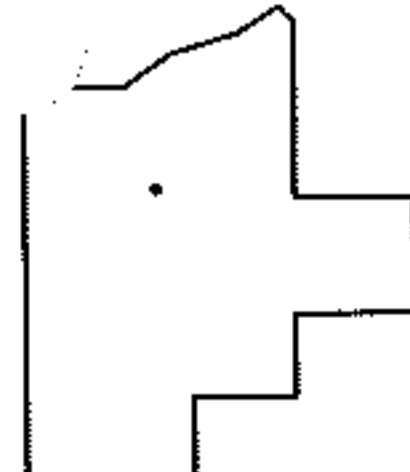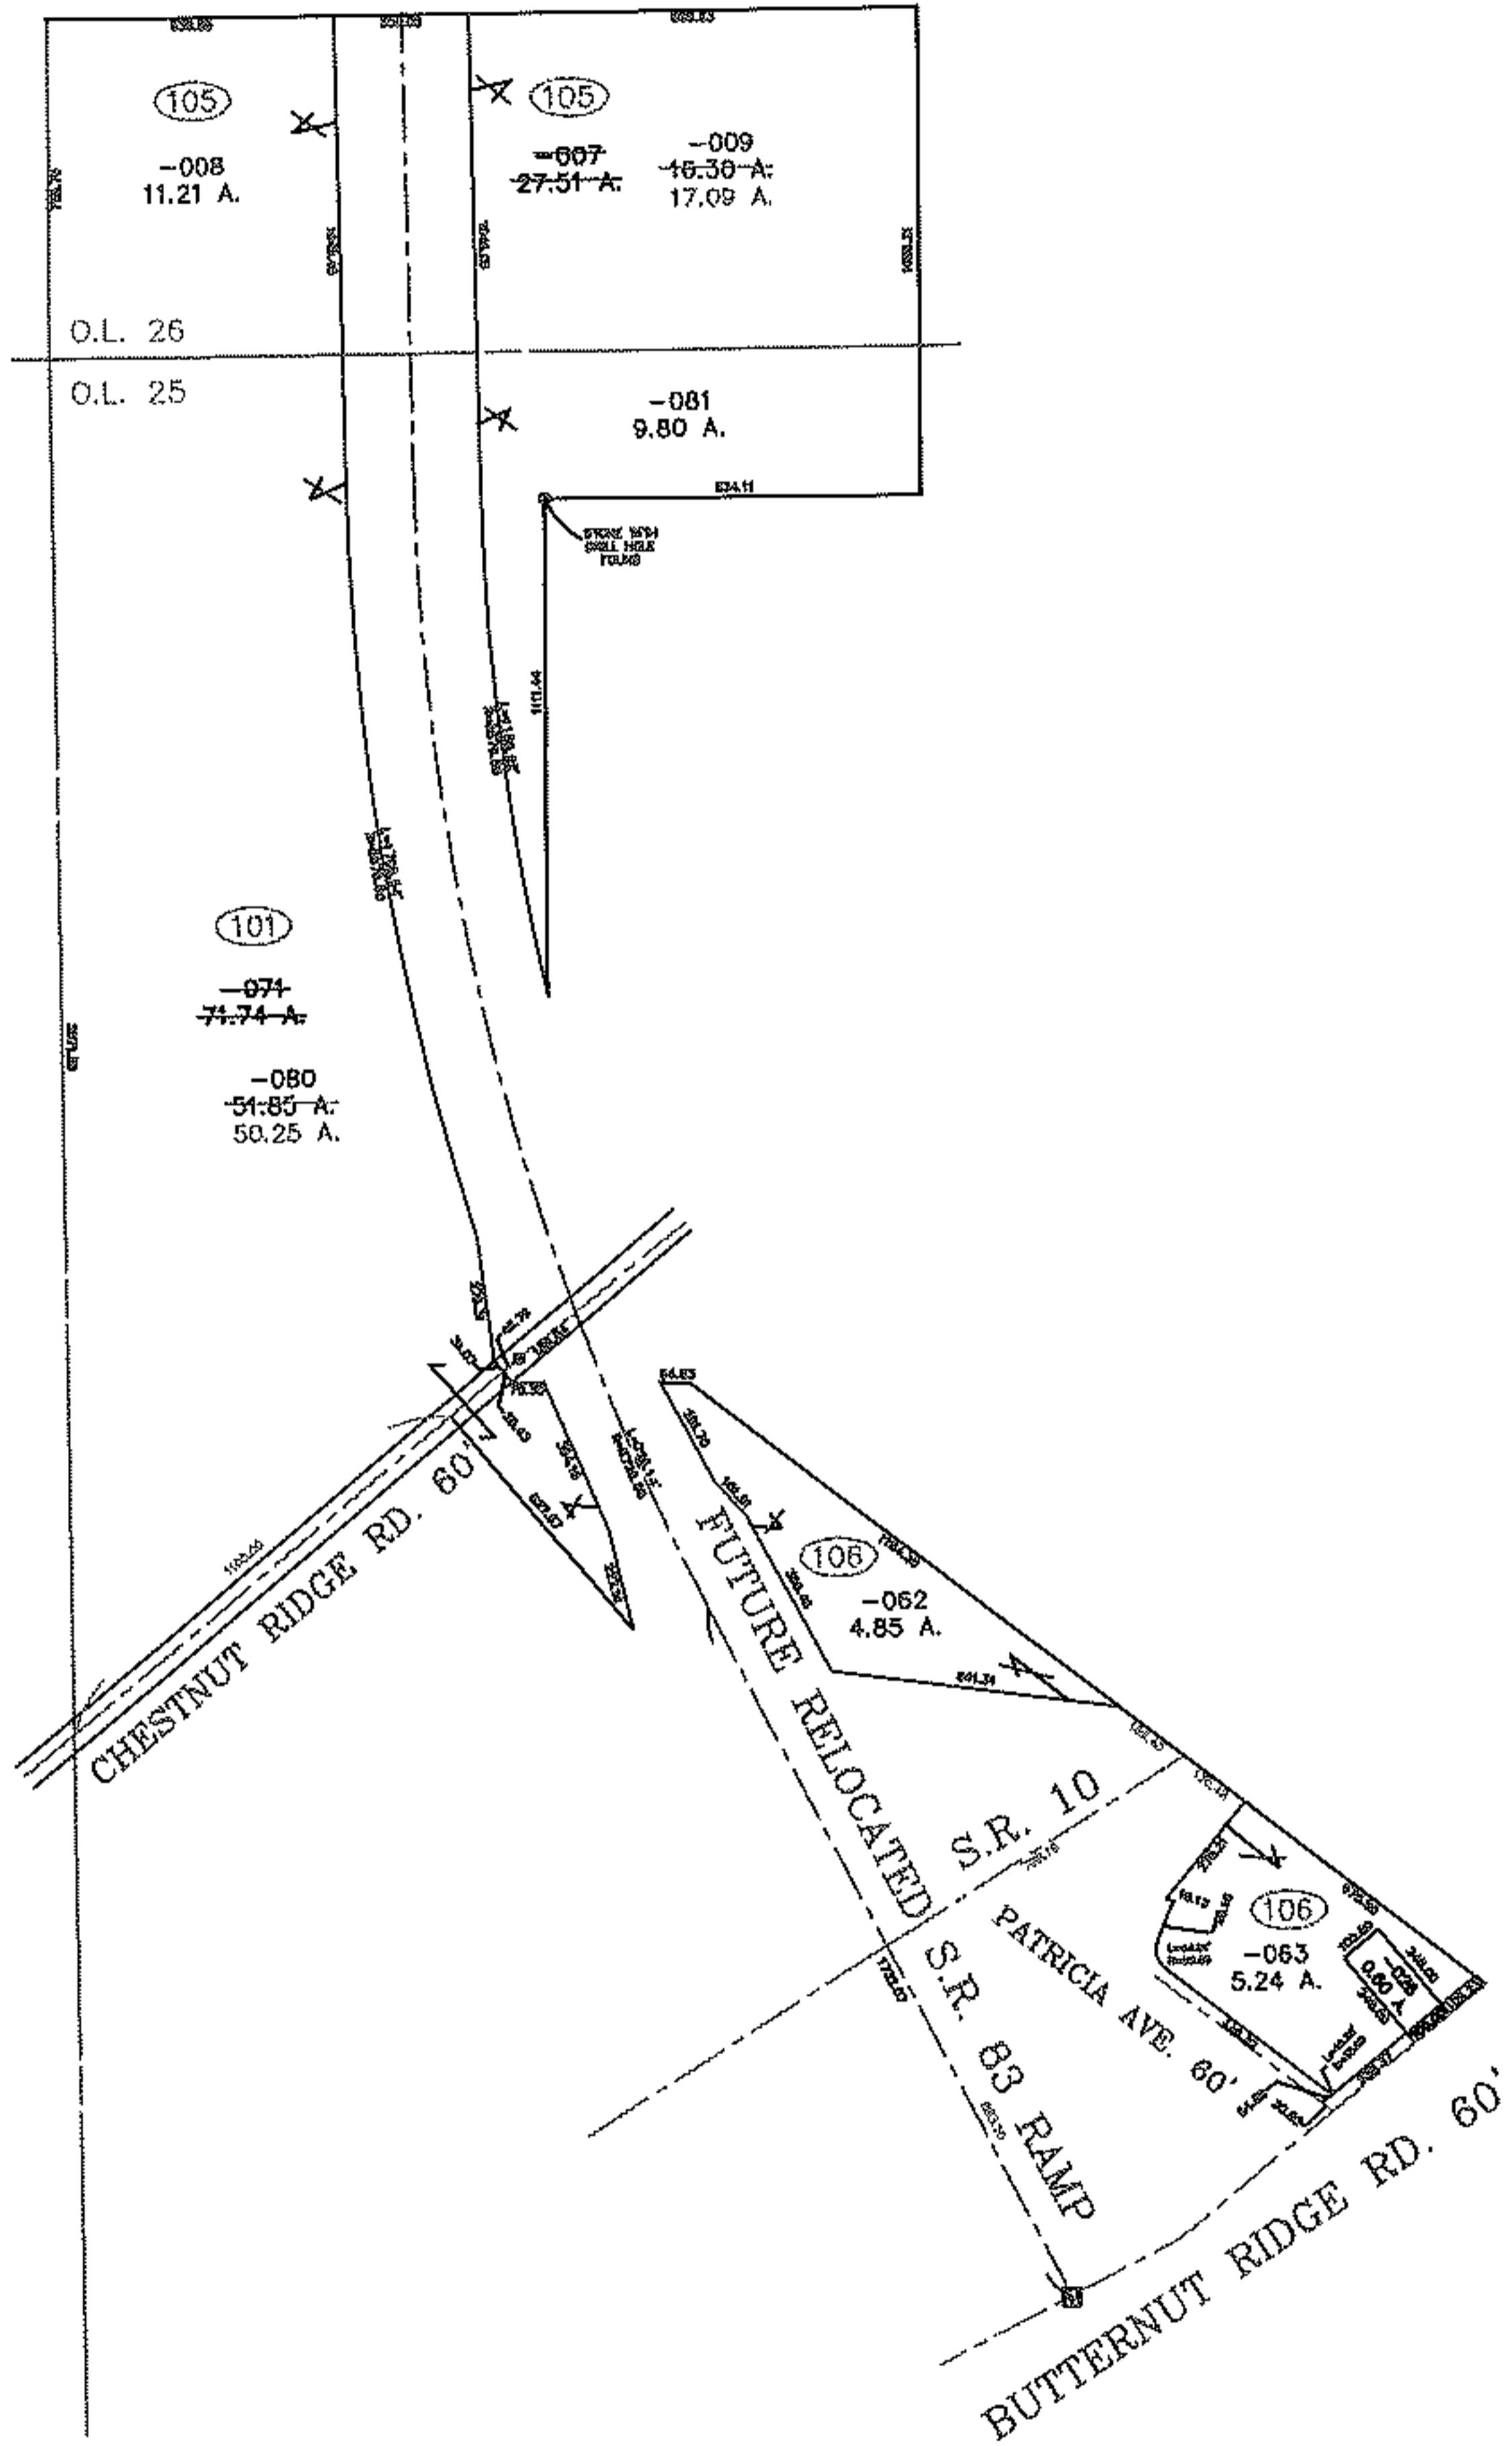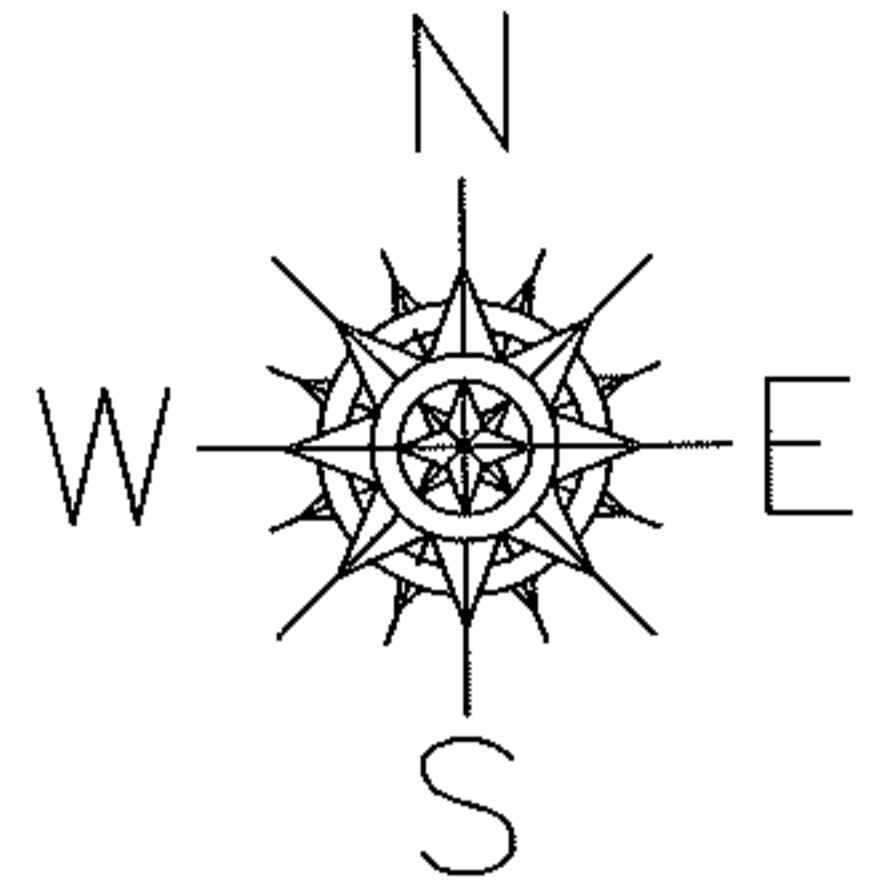

SPLITS/DEEDS PROCESSED

LORAIN COUNTY TAX MAP DEPARTMENT
226 MIDDLE AVE. ELYRIA, OHIO

SURVEYED BY: ANTHONY M. PICONE
CLOSURE: 0.02:10.000
MAP PAGE(S): 07-00-025-A,C,D & 07-00-026-C
APPROVED BY: TJS DATE: 2/6/09
SCALE: 1" = 800' PRIOR INSTRUMENT: 20080271485