

PASTER


PARENT PARCEL: --ADD TO DUP--

09-01765-X

CHILD PARCEL: 02-01-003-240-016 & 02-01-003-241-025



STARTING POINT: N LINE OF 36TH AND LEXINGTON AVE

ADD TO DUP
PER VAC ORD 29-01

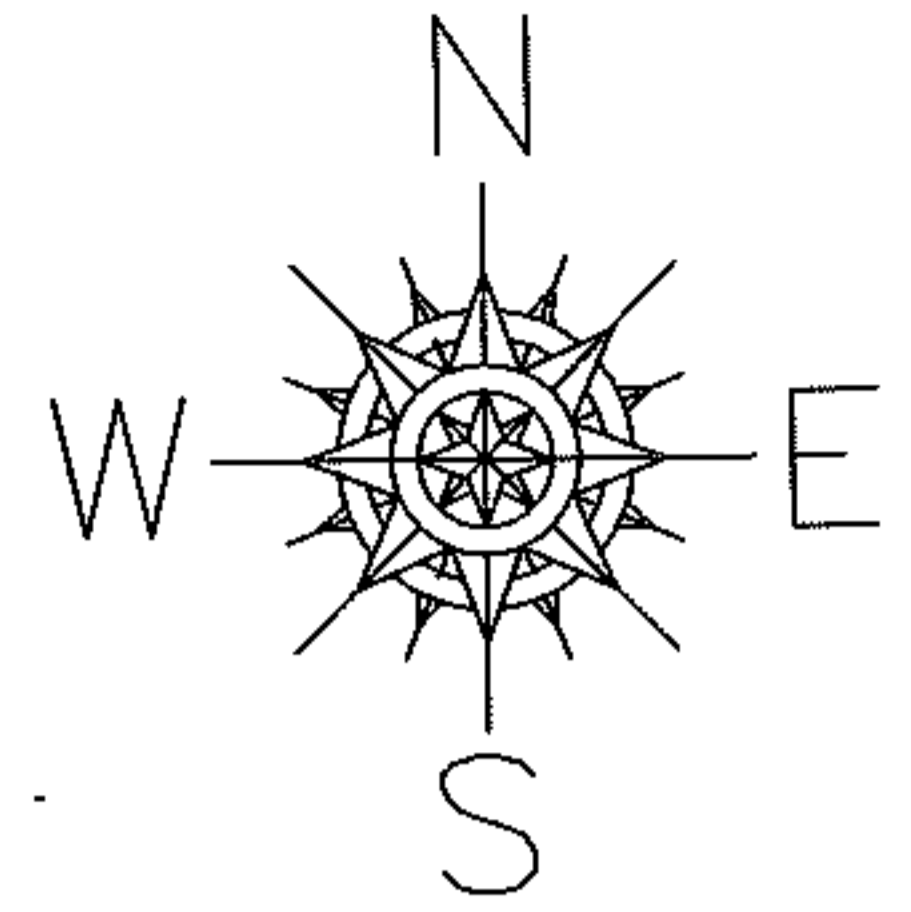

78 62.54

100 31

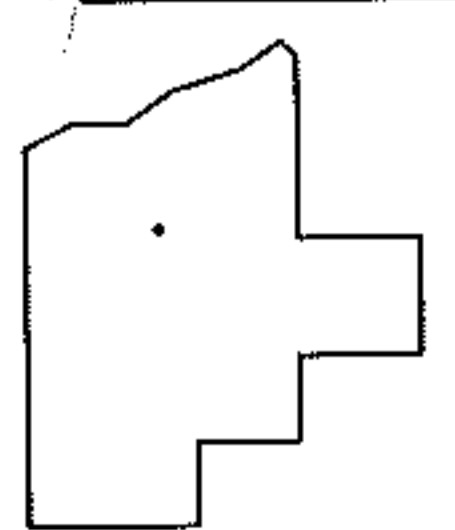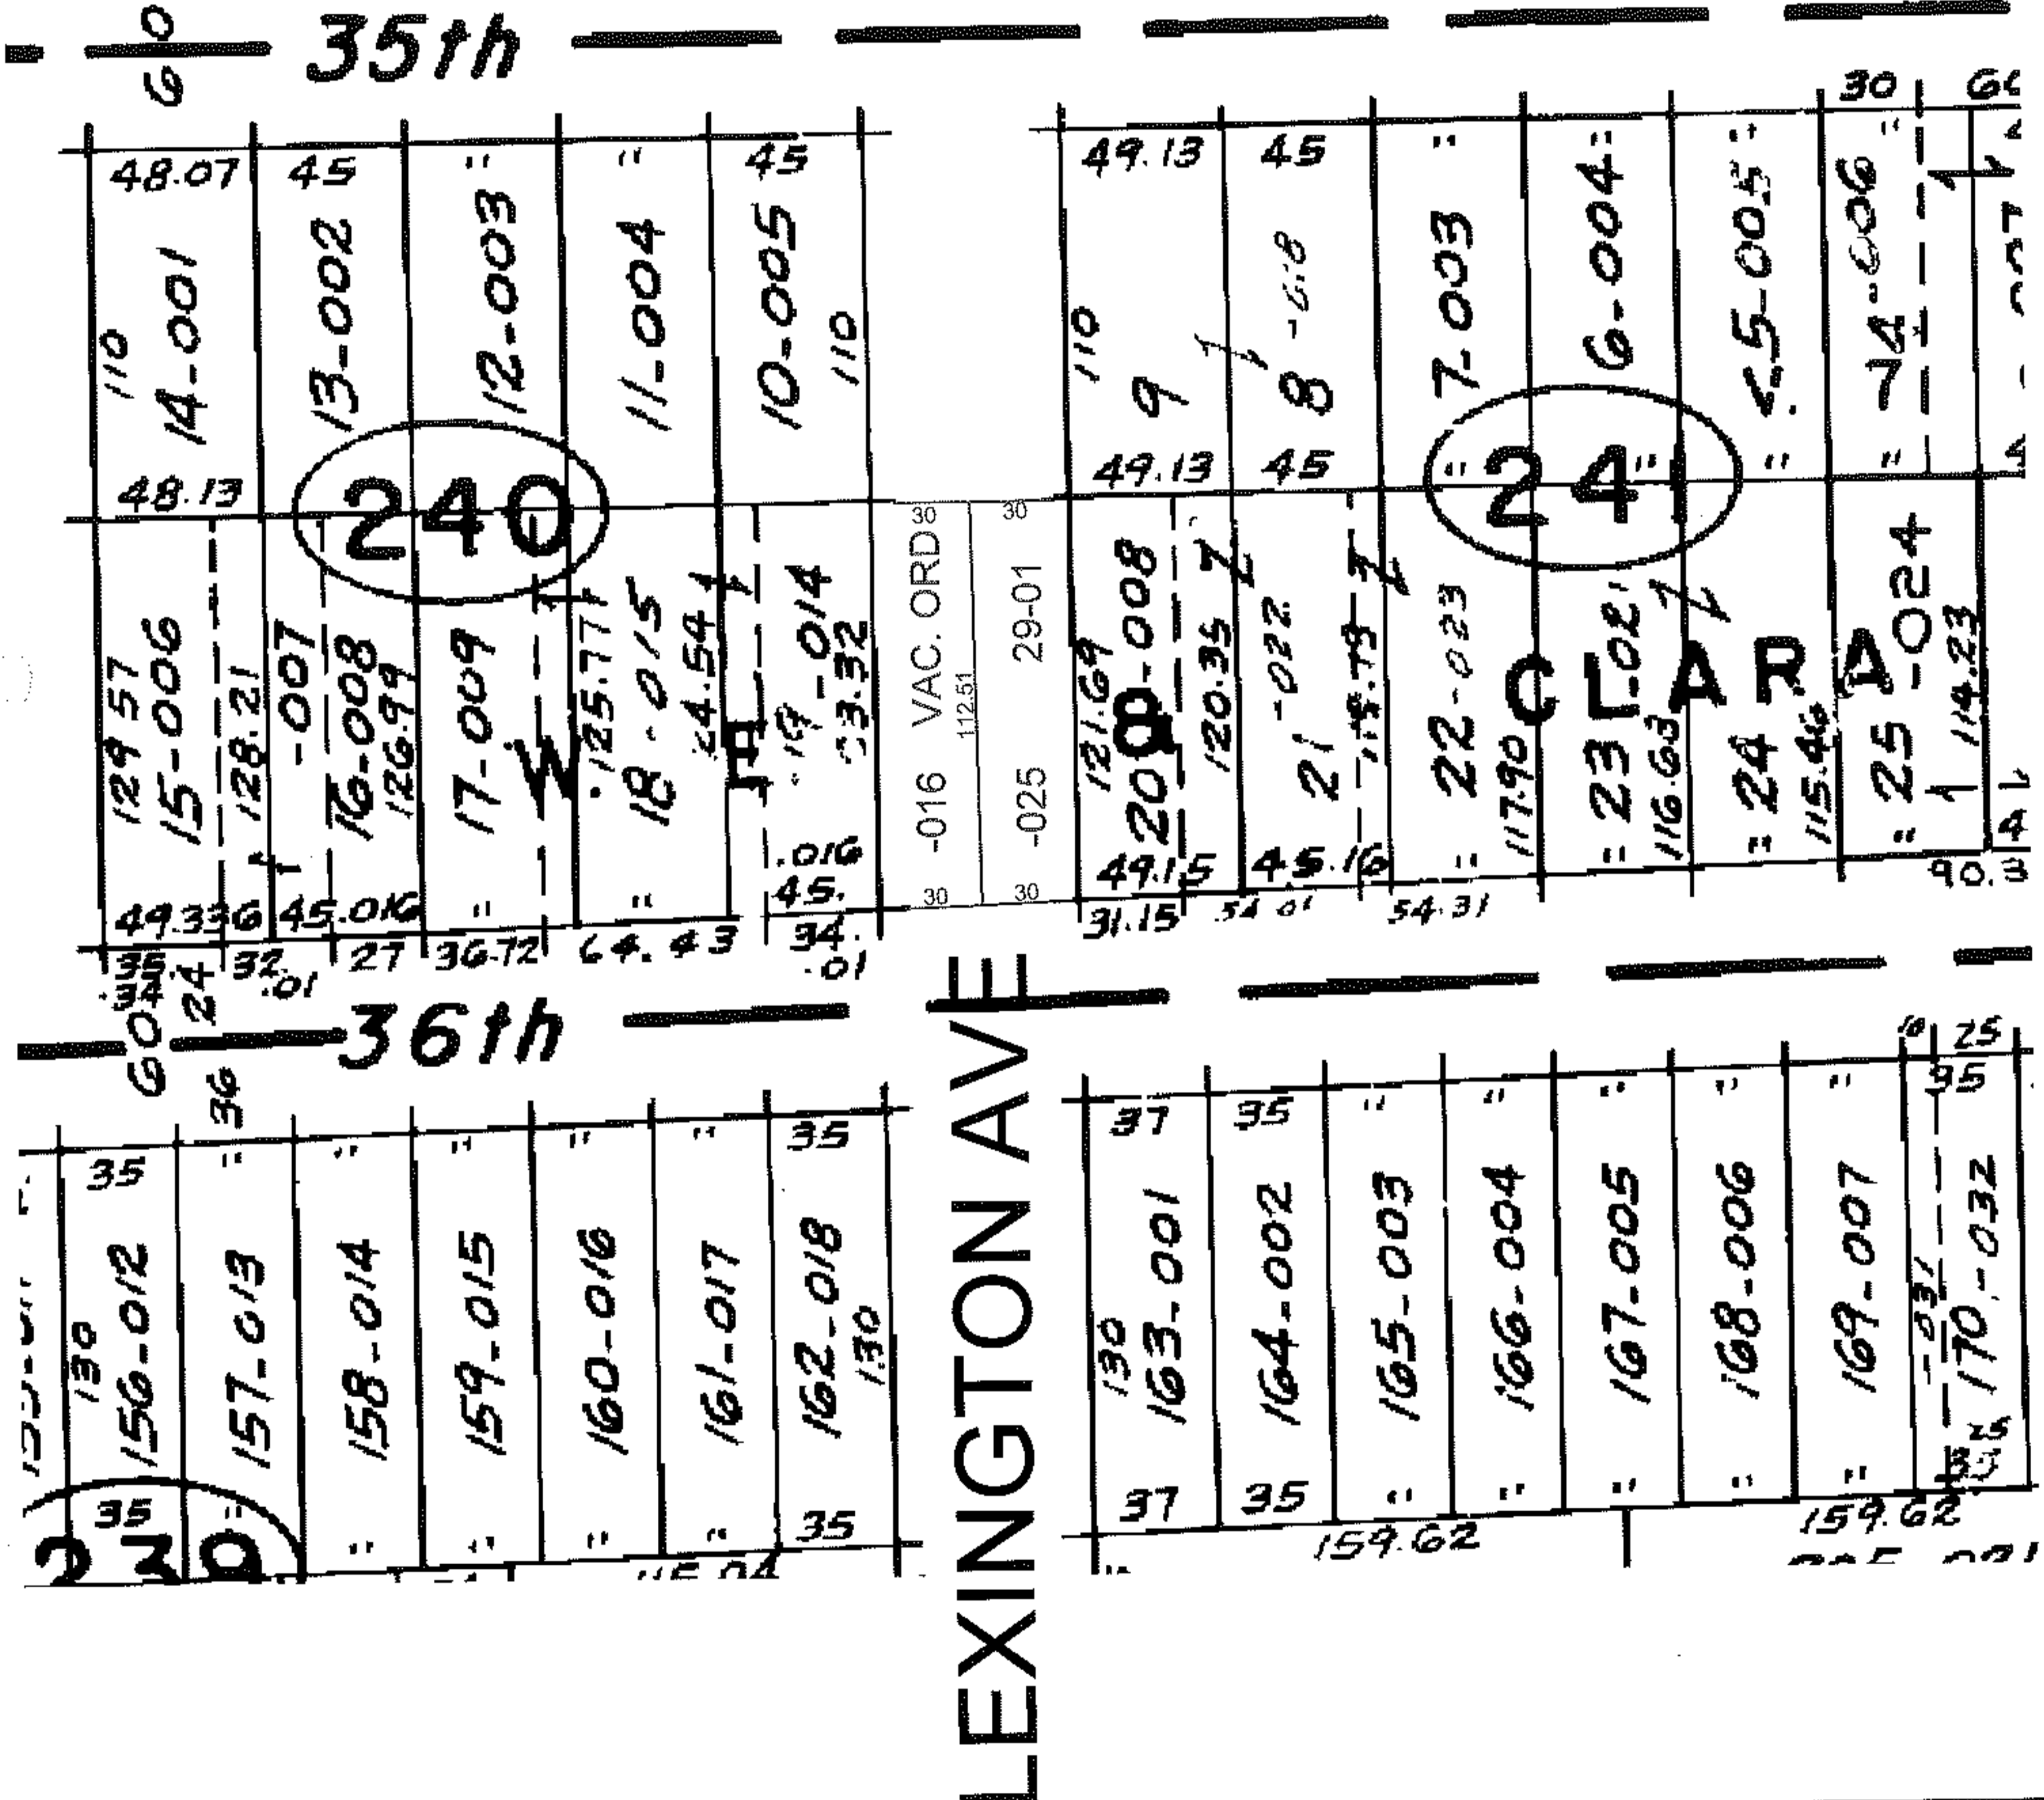

SPLITS/DEEDS PROCESSED

LORAIN COUNTY TAX MAP DEPARTMENT
226 MIDDLE AVE. ELYRIA, OHIO

SURVEYED BY: N/A

CLOSURE: N/A

MAP PAGE(S): 02-01-003-J

APPROVED BY: DRH DATE: 2/11/2009

SCALE: NOT TO SCALE PRIOR INST.: 20030940168