


MASTER

PARENT PARCEL: 19-05-039-000-003 & -004

CHILD PARCEL: 19-05-044-000-009 & -010

STARTING POINT: XXXXXX

NO. 09-01769-C

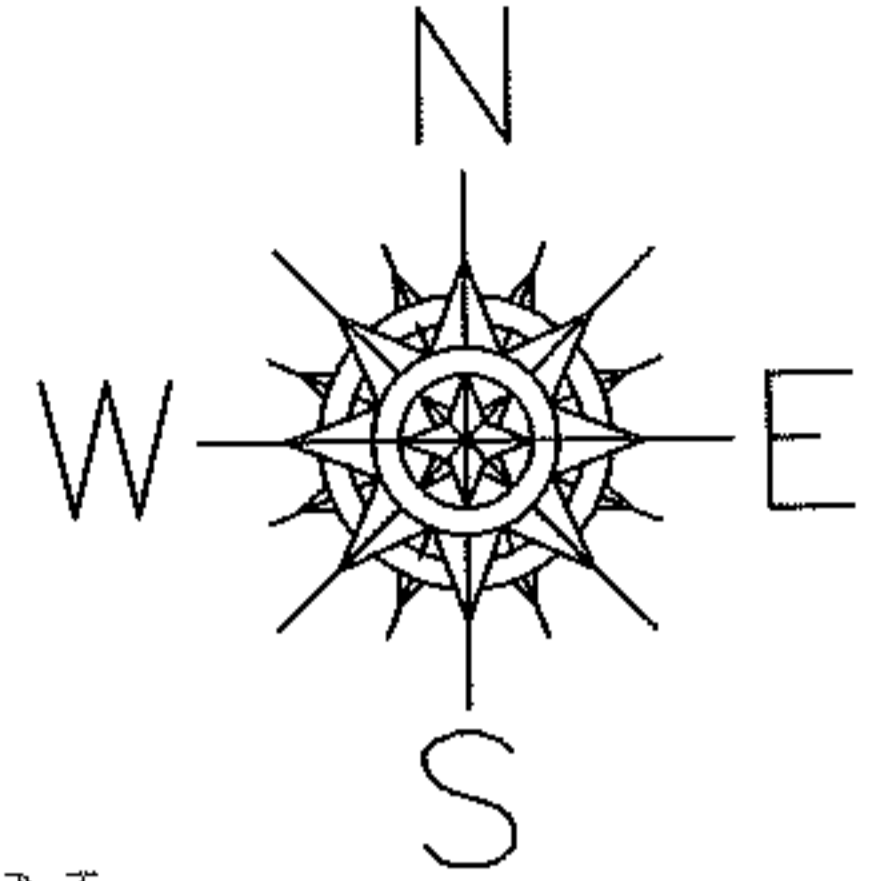

PARCEL NUMBER CORRECTION

~~19-05-039-000-003~~

~~4.24 A.~~

19-05-044-000-009

4.24 A.


~~19-05-039-000-004~~

~~0.50 A.~~

19-05-044-000-010

0.50 A.

PARCELS WERE NUMBERED
IN THE WRONG ORIGINAL LOT

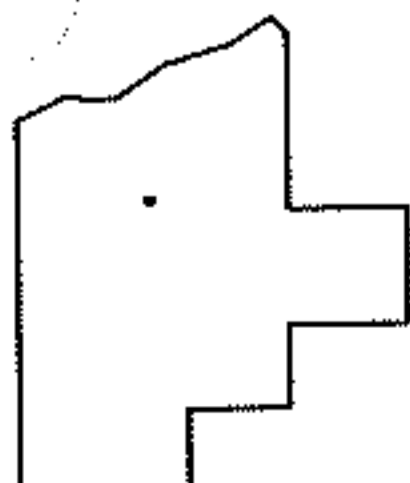

SPLITS/DEEDS PROCESSED

LORAIN COUNTY TAX MAP DEPARTMENT
226 MIDDLE AVE. ELYRIA, OHIO

SURVEYED BY: XXXXXXXXXXXX

CLOSURE: XXXXXX

MAP PAGE(S): 19-D

APPROVED BY: TJS DATE: 2/20/09

SCALE: 1"= 100 PRIOR INSTRUMENT: DV XXXX/XXX