


RASTER

PARENT PARCEL: XX-XX-XXX-XXX-XXX  
CHILD PARCEL: XX-XX-XXX-XXX-XXX  
STARTING POINT: XXXXXX

09-01775-X

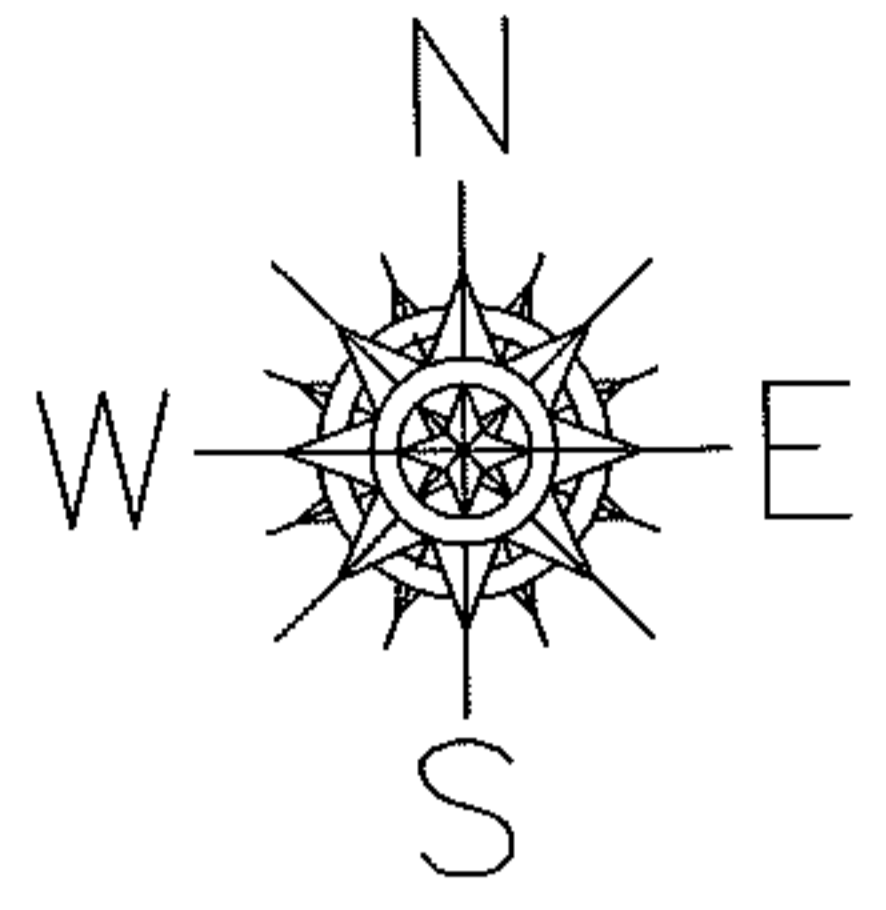


# CERTIFICATE OF CORRECTION

CURVE INFORMATION CORR.  
MEADOW LAKES SUB NO. 1  
PV. 68 PG. 38

| CURVE | DELTA       | RADIUS  | ARC    | TAN.   | CHORD                  |
|-------|-------------|---------|--------|--------|------------------------|
| C66   | 07° 37' 08" | 430.00' | 57.18' | 28.63' | S 87° 52' 01" E 73.82' |

### CORRECT CURVE INFORMATION

| CURVE | DELTA       | RADIUS  | ARC    | TAN.   | CHORD                  |
|-------|-------------|---------|--------|--------|------------------------|
| C66   | 12° 50' 35" | 330.00' | 73.97' | 37.14' | S 49° 28' 09" E 73.82' |

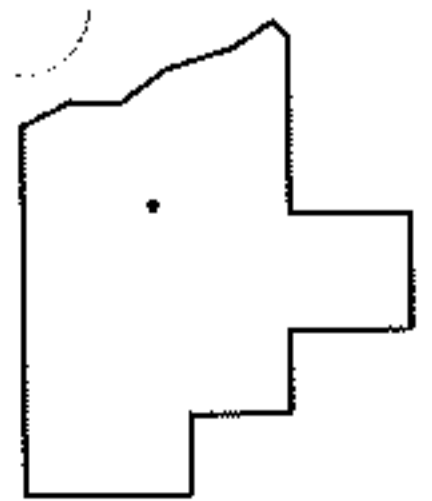

**SPLITS/DEEDS PROCESSED**  
LORAIN COUNTY TAX MAP DEPARTMENT  
226 MIDDLE AVE. ELYRIA, OHIO

SURVEYED BY: DAVID L. ELWELL  
CLOSURE: XXXXXX  
MAP PAGE(S): 07-00-043-C  
APPROVED BY: TJS DATE: 4/8/09  
SCALE: 1"= 100 PRIOR INST.: PV 68/35-40