



PARENT PARCEL: 03-00-005-311-001

09-01782-C

CHILD PARCEL: --SAME--

STARTING POINT: S/L 36 & 37 IN COLORADO PARK ALLOTMENT PV 9 P12

FRONTAGE & DEPTH CORR PER DEED & PLAT NO MAP CORR ON DEPTH

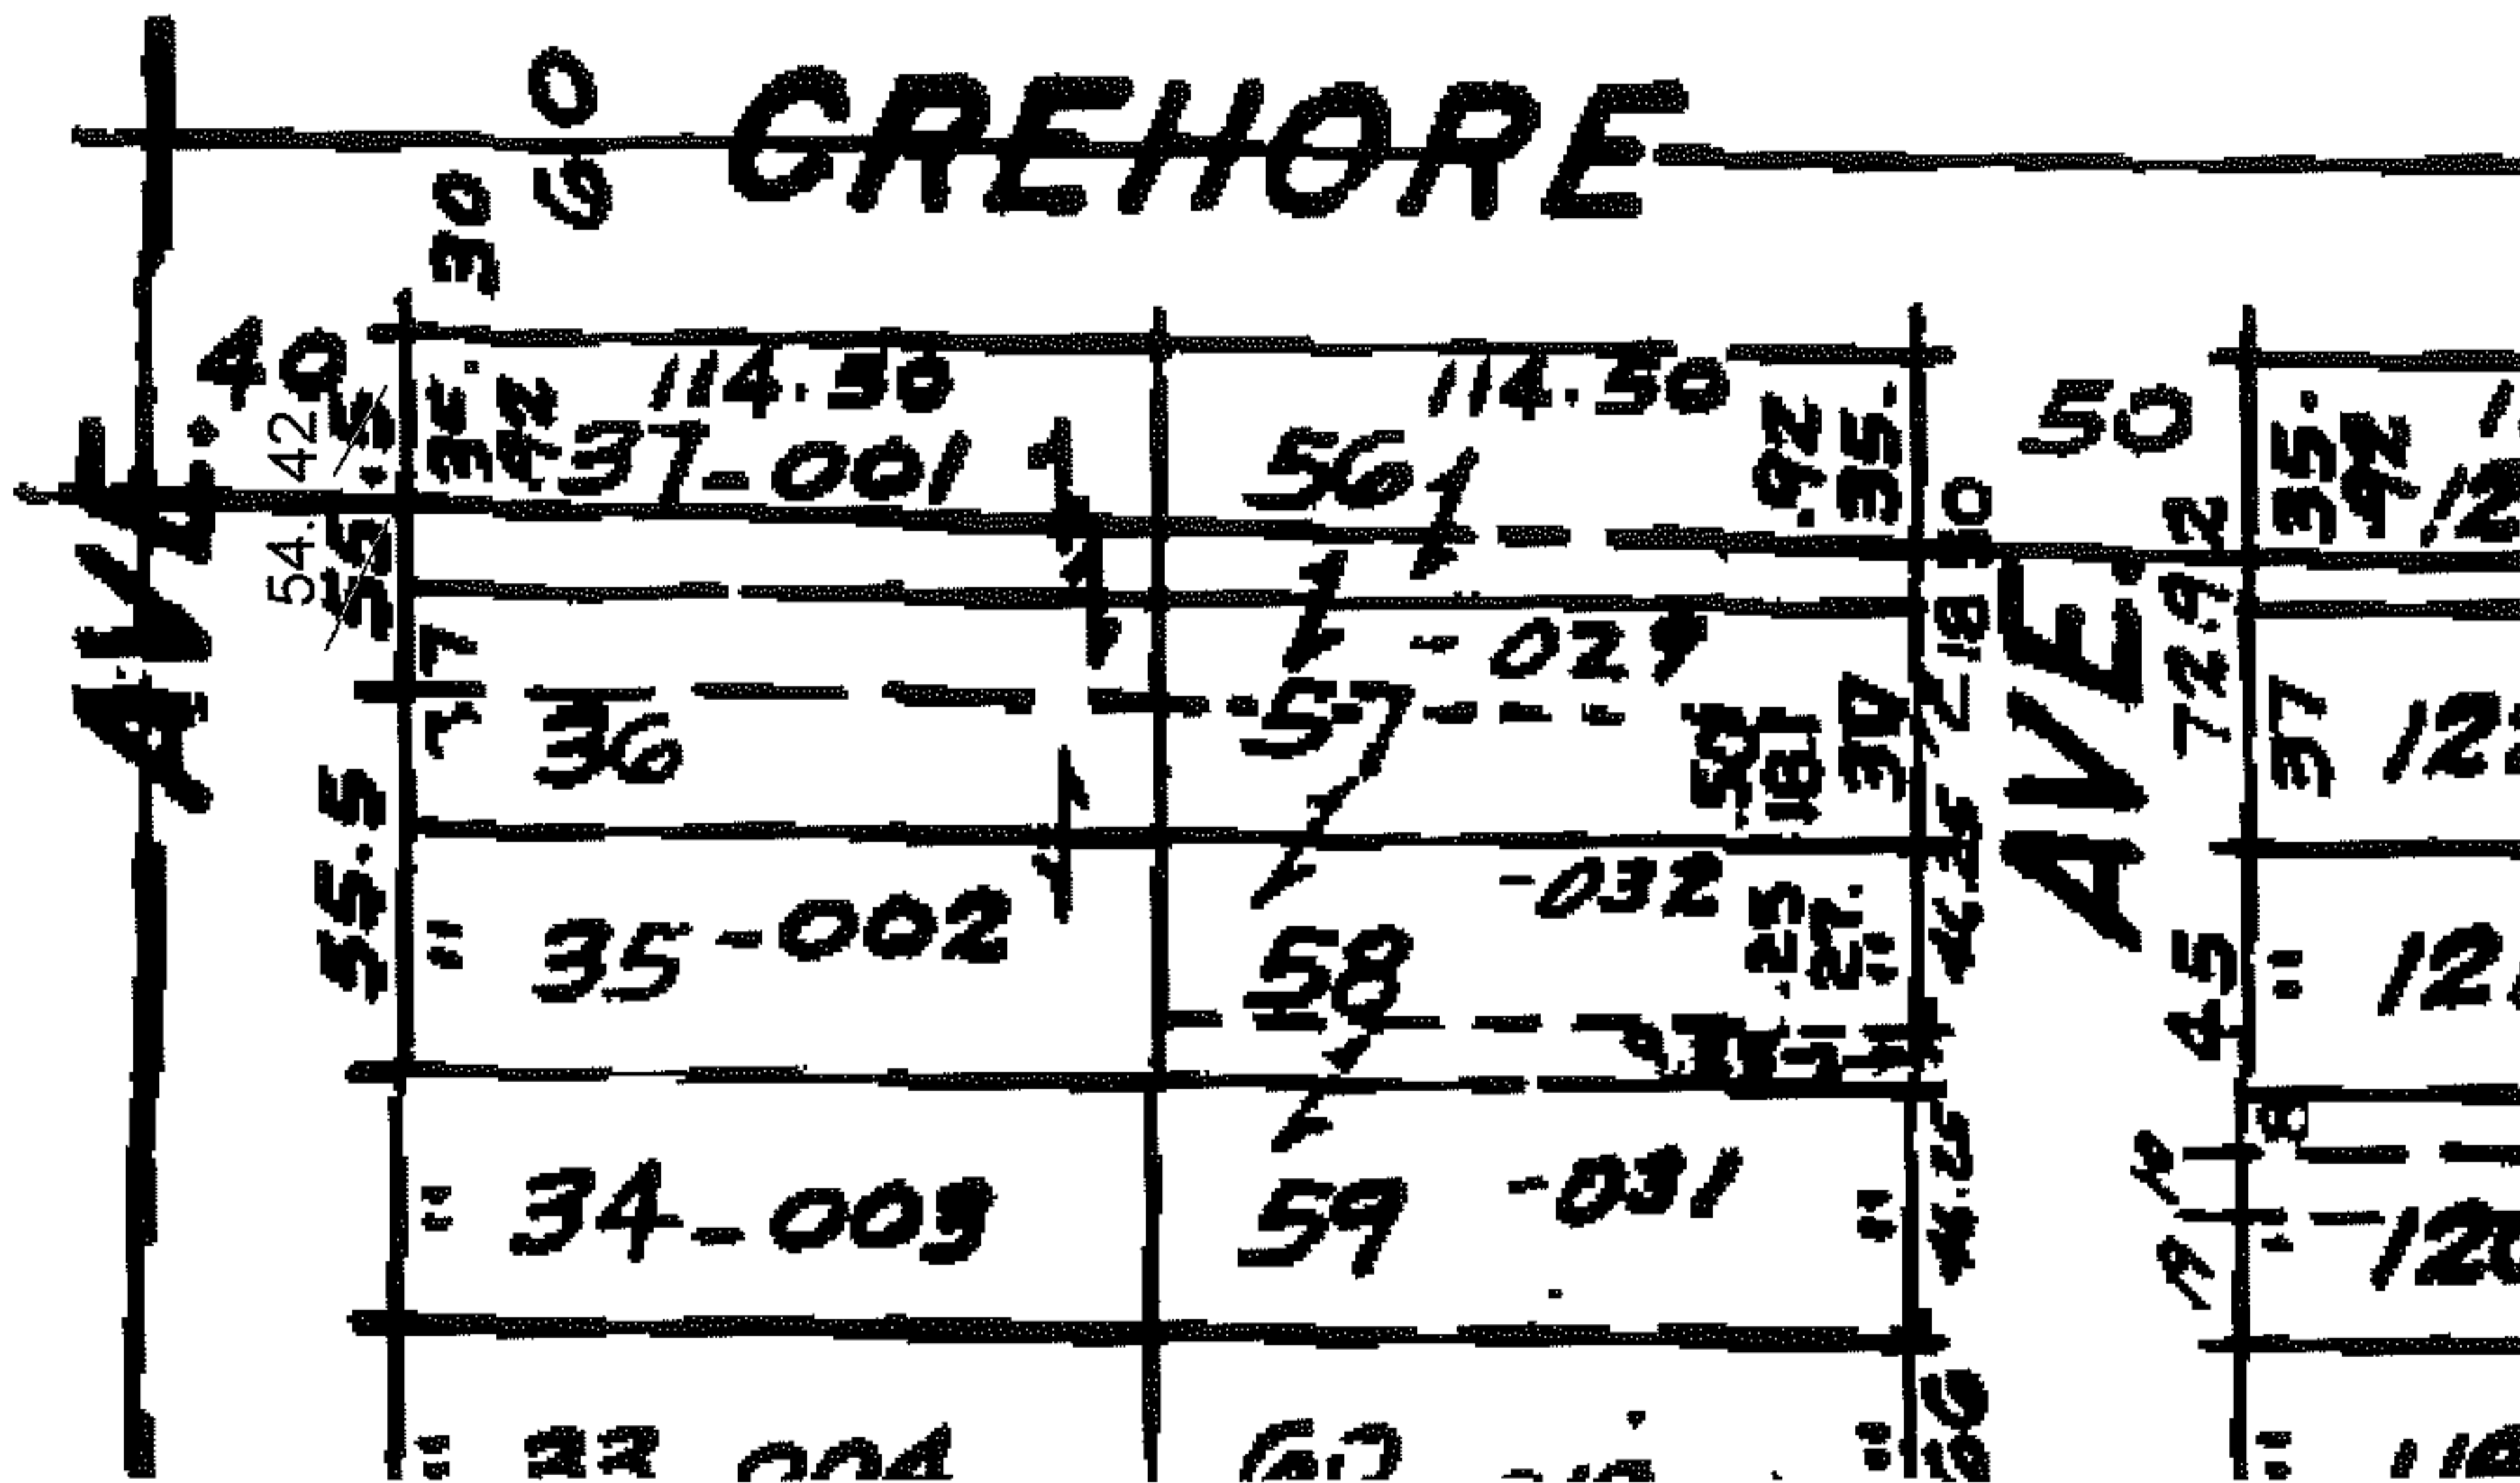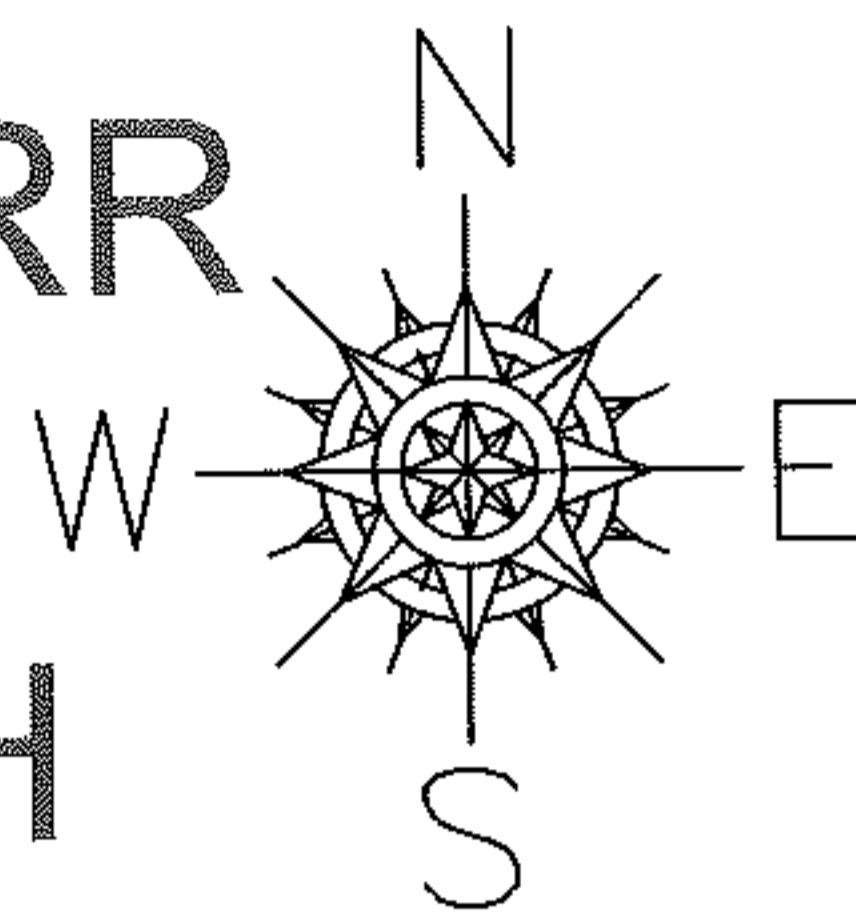

SPLITS/DEEDS PROCESSED

LORAIN COUNTY TAX MAP DEPARTMENT
226 MIDDLE AVE. ELYRIA, OHIO

SURVEYED BY: N/A

CLOSURE: N/A

MAP PAGE(S): 03-00-053-A

APPROVED BY: DRH DATE: 6/15/2009

SCALE: NOT TO SCALE PRIOR INST.: 20090287388