

RASTER


PARENT PARCEL: 09-00-096-113-093

CHILD PARCEL: XX-XX-XXX-XXX-XXX

STARTING POINT: I.P. FOUND, N.E. CORNER OF SUBLOT 10 IN GLADYS SUBDIVISION

09-01786-D

~~SMITH ST. 50'~~

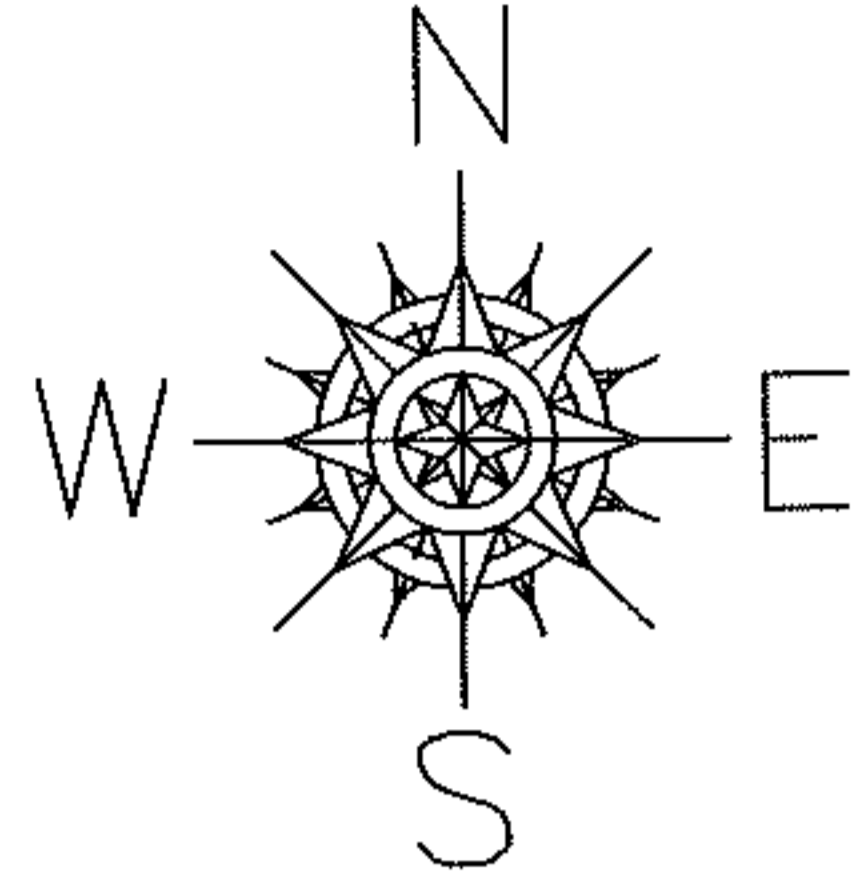

90.02
~~90~~

310.19
~~309~~

~~093~~

0.64 A.

~~309~~
309.75

113

~~90~~
90.33

I.P. FD
P.P.B.

SPLITS/DEEDS PROCESSED

LORAIN COUNTY TAX MAP DEPARTMENT
226 MIDDLE AVE. ELYRIA, OHIO

SURVEYED BY: SCOTT A. ENGLAND

CLOSURE: 0.01 : 10,000

MAP PAGE(S): 09-00-096-A

APPROVED BY: TJS DATE: 4/1/09

SCALE: 1" = 50' PRIOR INST.: 20090284376