




RASTER

PARENT PARCEL: 08-00-099-000-023

CHILD PARCEL: 08-00-099-000-025 THRU -027

STARTING POINT: CENTERLINE OF MYLAN-ELYRIA RD. & BAIRD RD.

NO. 01802

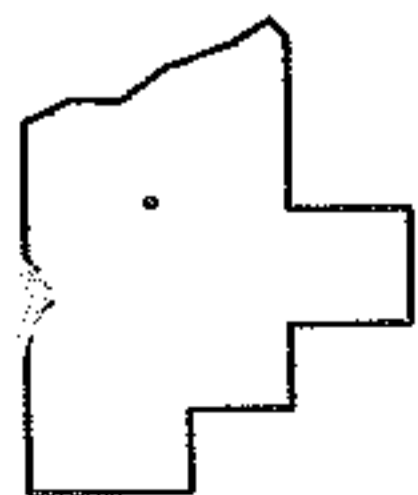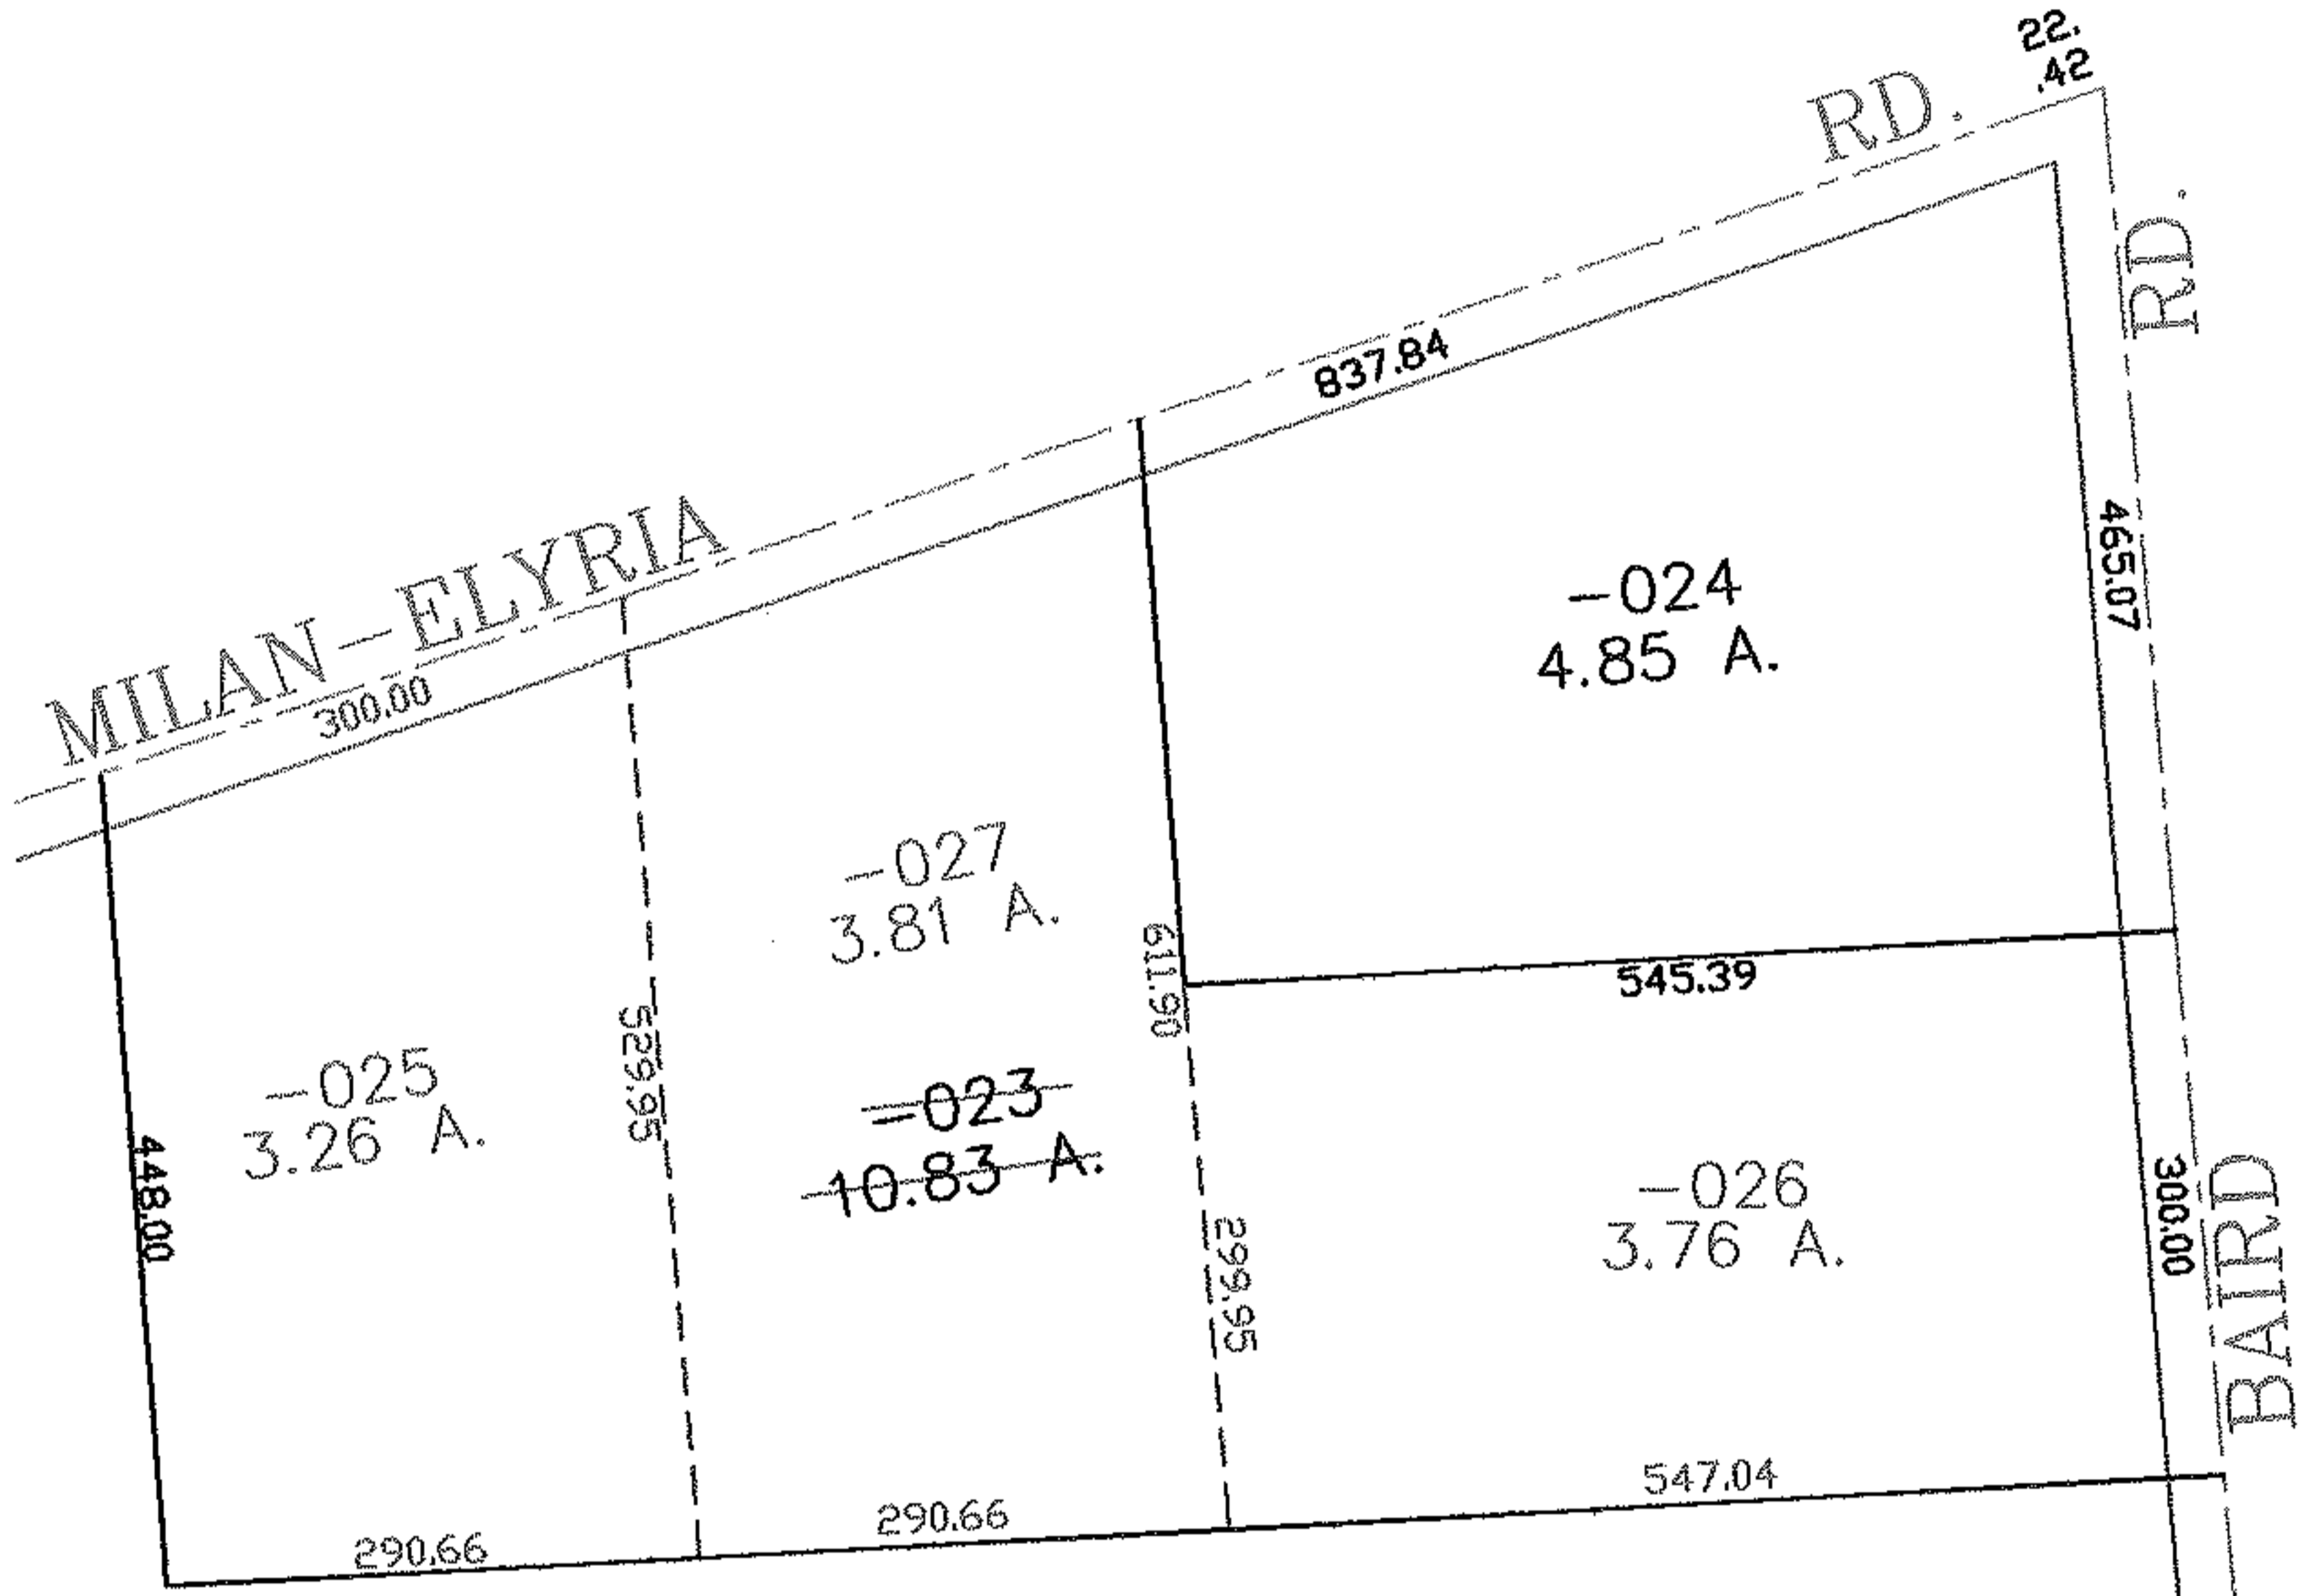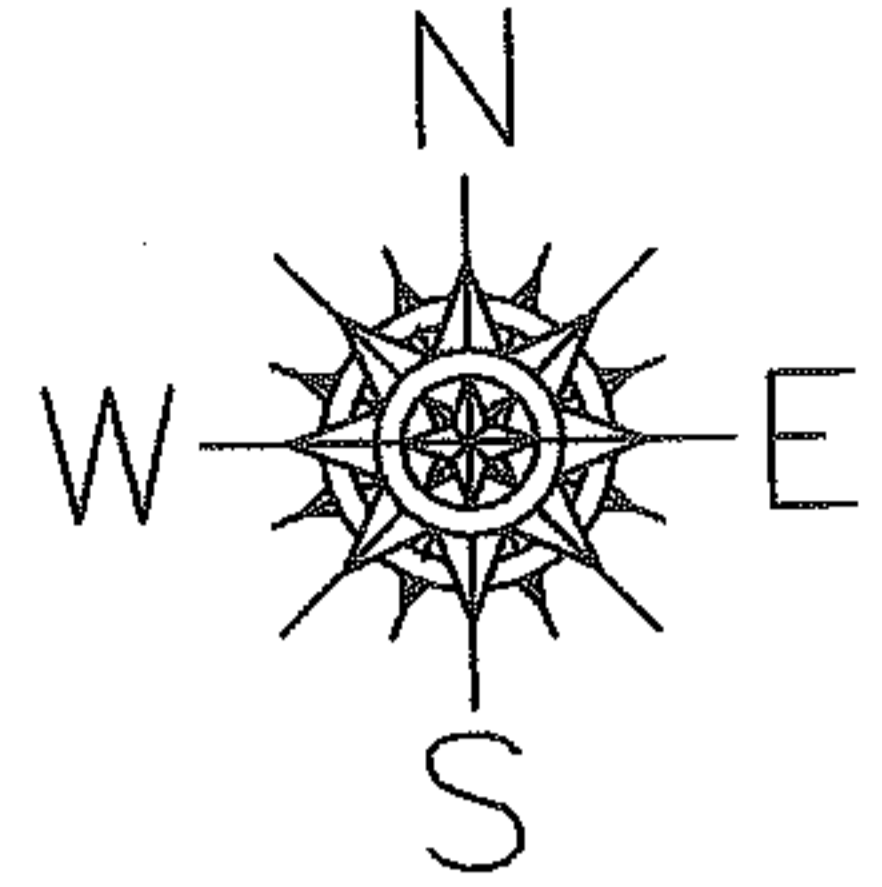

SPLITS/DEEDS PROCESSED
LORAIN COUNTY TAX MAP DEPARTMENT
 226 MIDDLE AVE. ELYRIA, OHIO

SURVEYED BY: RICHARD CARLSON
 CLOSURE: 0.00 : 10.000
 MAP PAGE(S): 08-00-099-A
 APPROVED BY: JAH DATE: 12-2-04
 SCALE: 1" = 200 PRIOR INSTRUMENT: 20040014422