
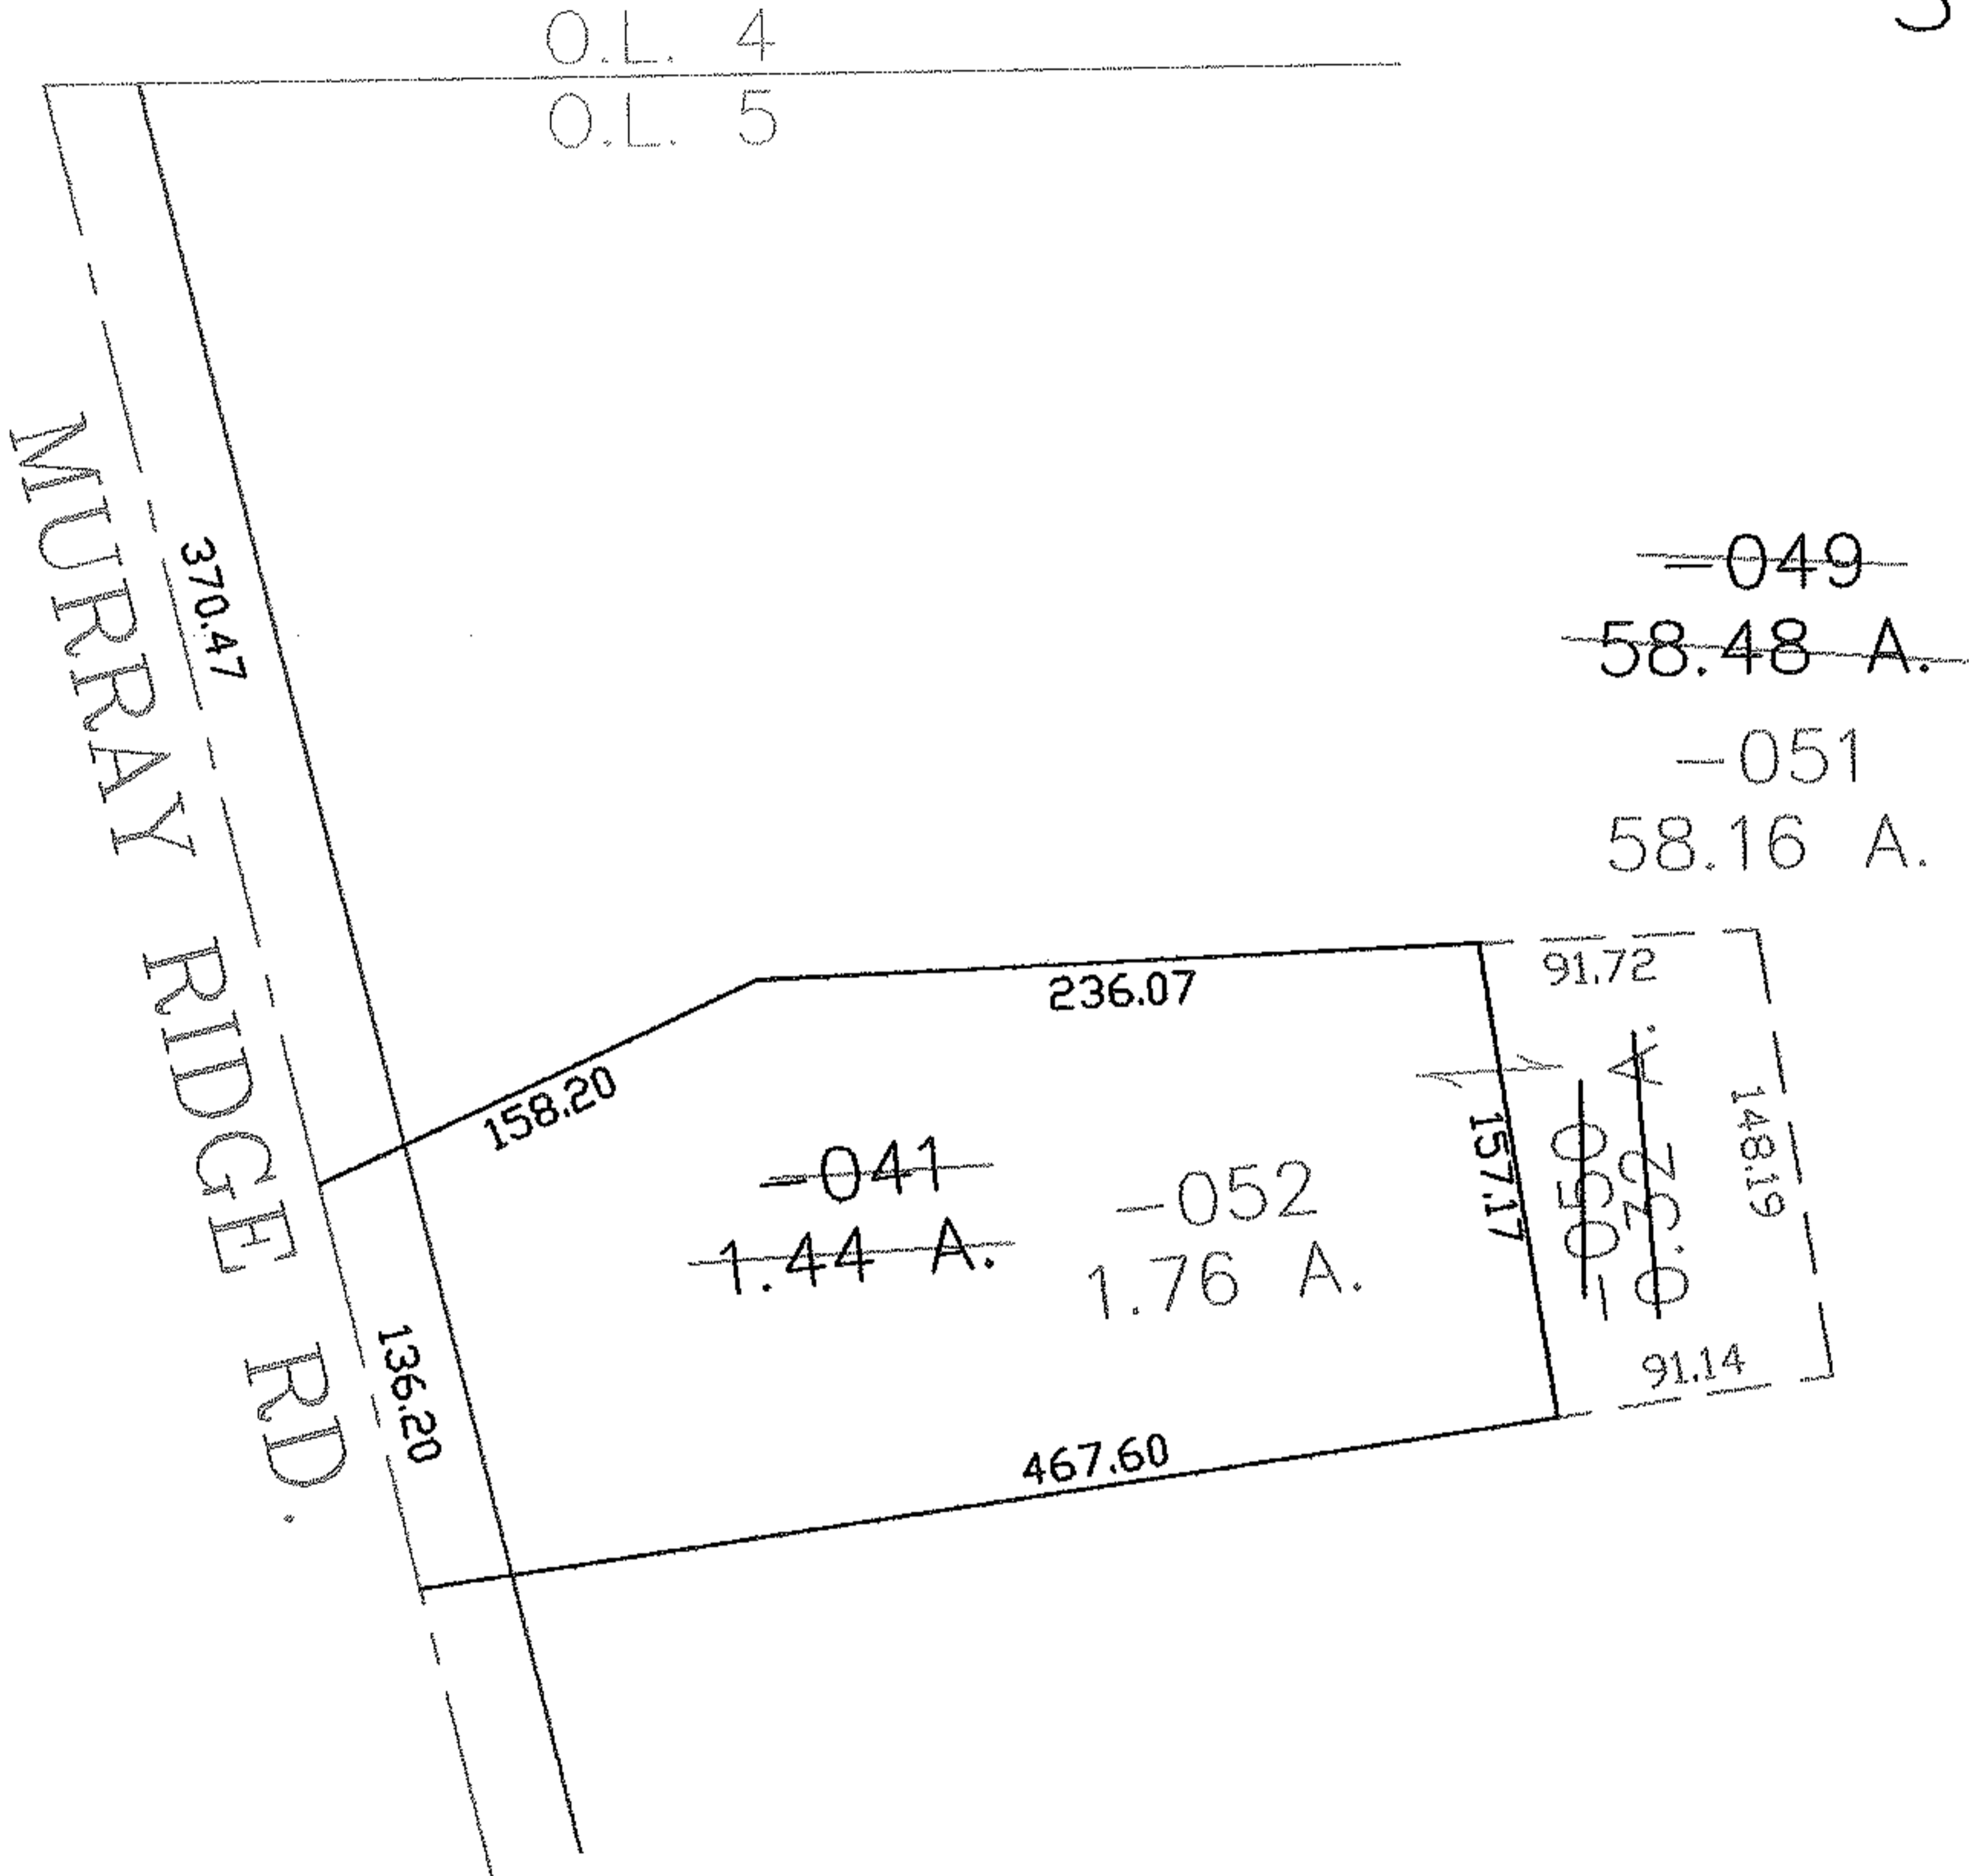


RASTER

PARENT PARCEL: 06-24-005-000-049, -041
CHILD PARCEL: 06-24-005-000-050 THRU -052
STARTING POINT: CENTERLINE OF MURRAY RIDGE RD. & O.L. 5

NO. 01805

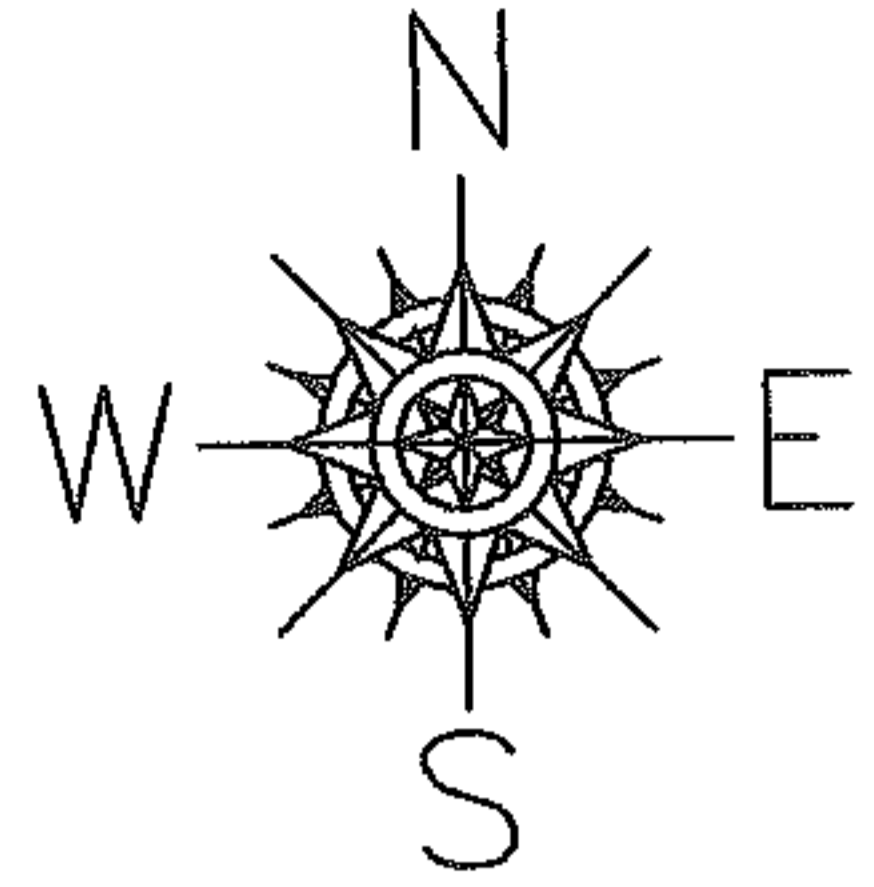

~~-049~~
~~58.48 A.~~
~~-051~~
58.16 A.

91.72
148.19
157.17
91.14



SPLITS/DEEDS PROCESSED
LORAIN COUNTY TAX MAP DEPARTMENT
226 MIDDLE AVE. ELYRIA, OHIO

SURVEYED BY: RICHARD D. CARLSON
CLOSURE: 0.00 : 10.000
MAP PAGE(S): 6-131
APPROVED BY: JAH DATE: 12-7-04
SCALE: 1" = 100' PRIOR INSTRUMENT: 20030904377