
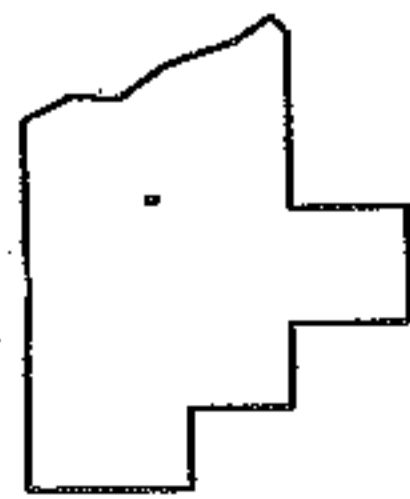
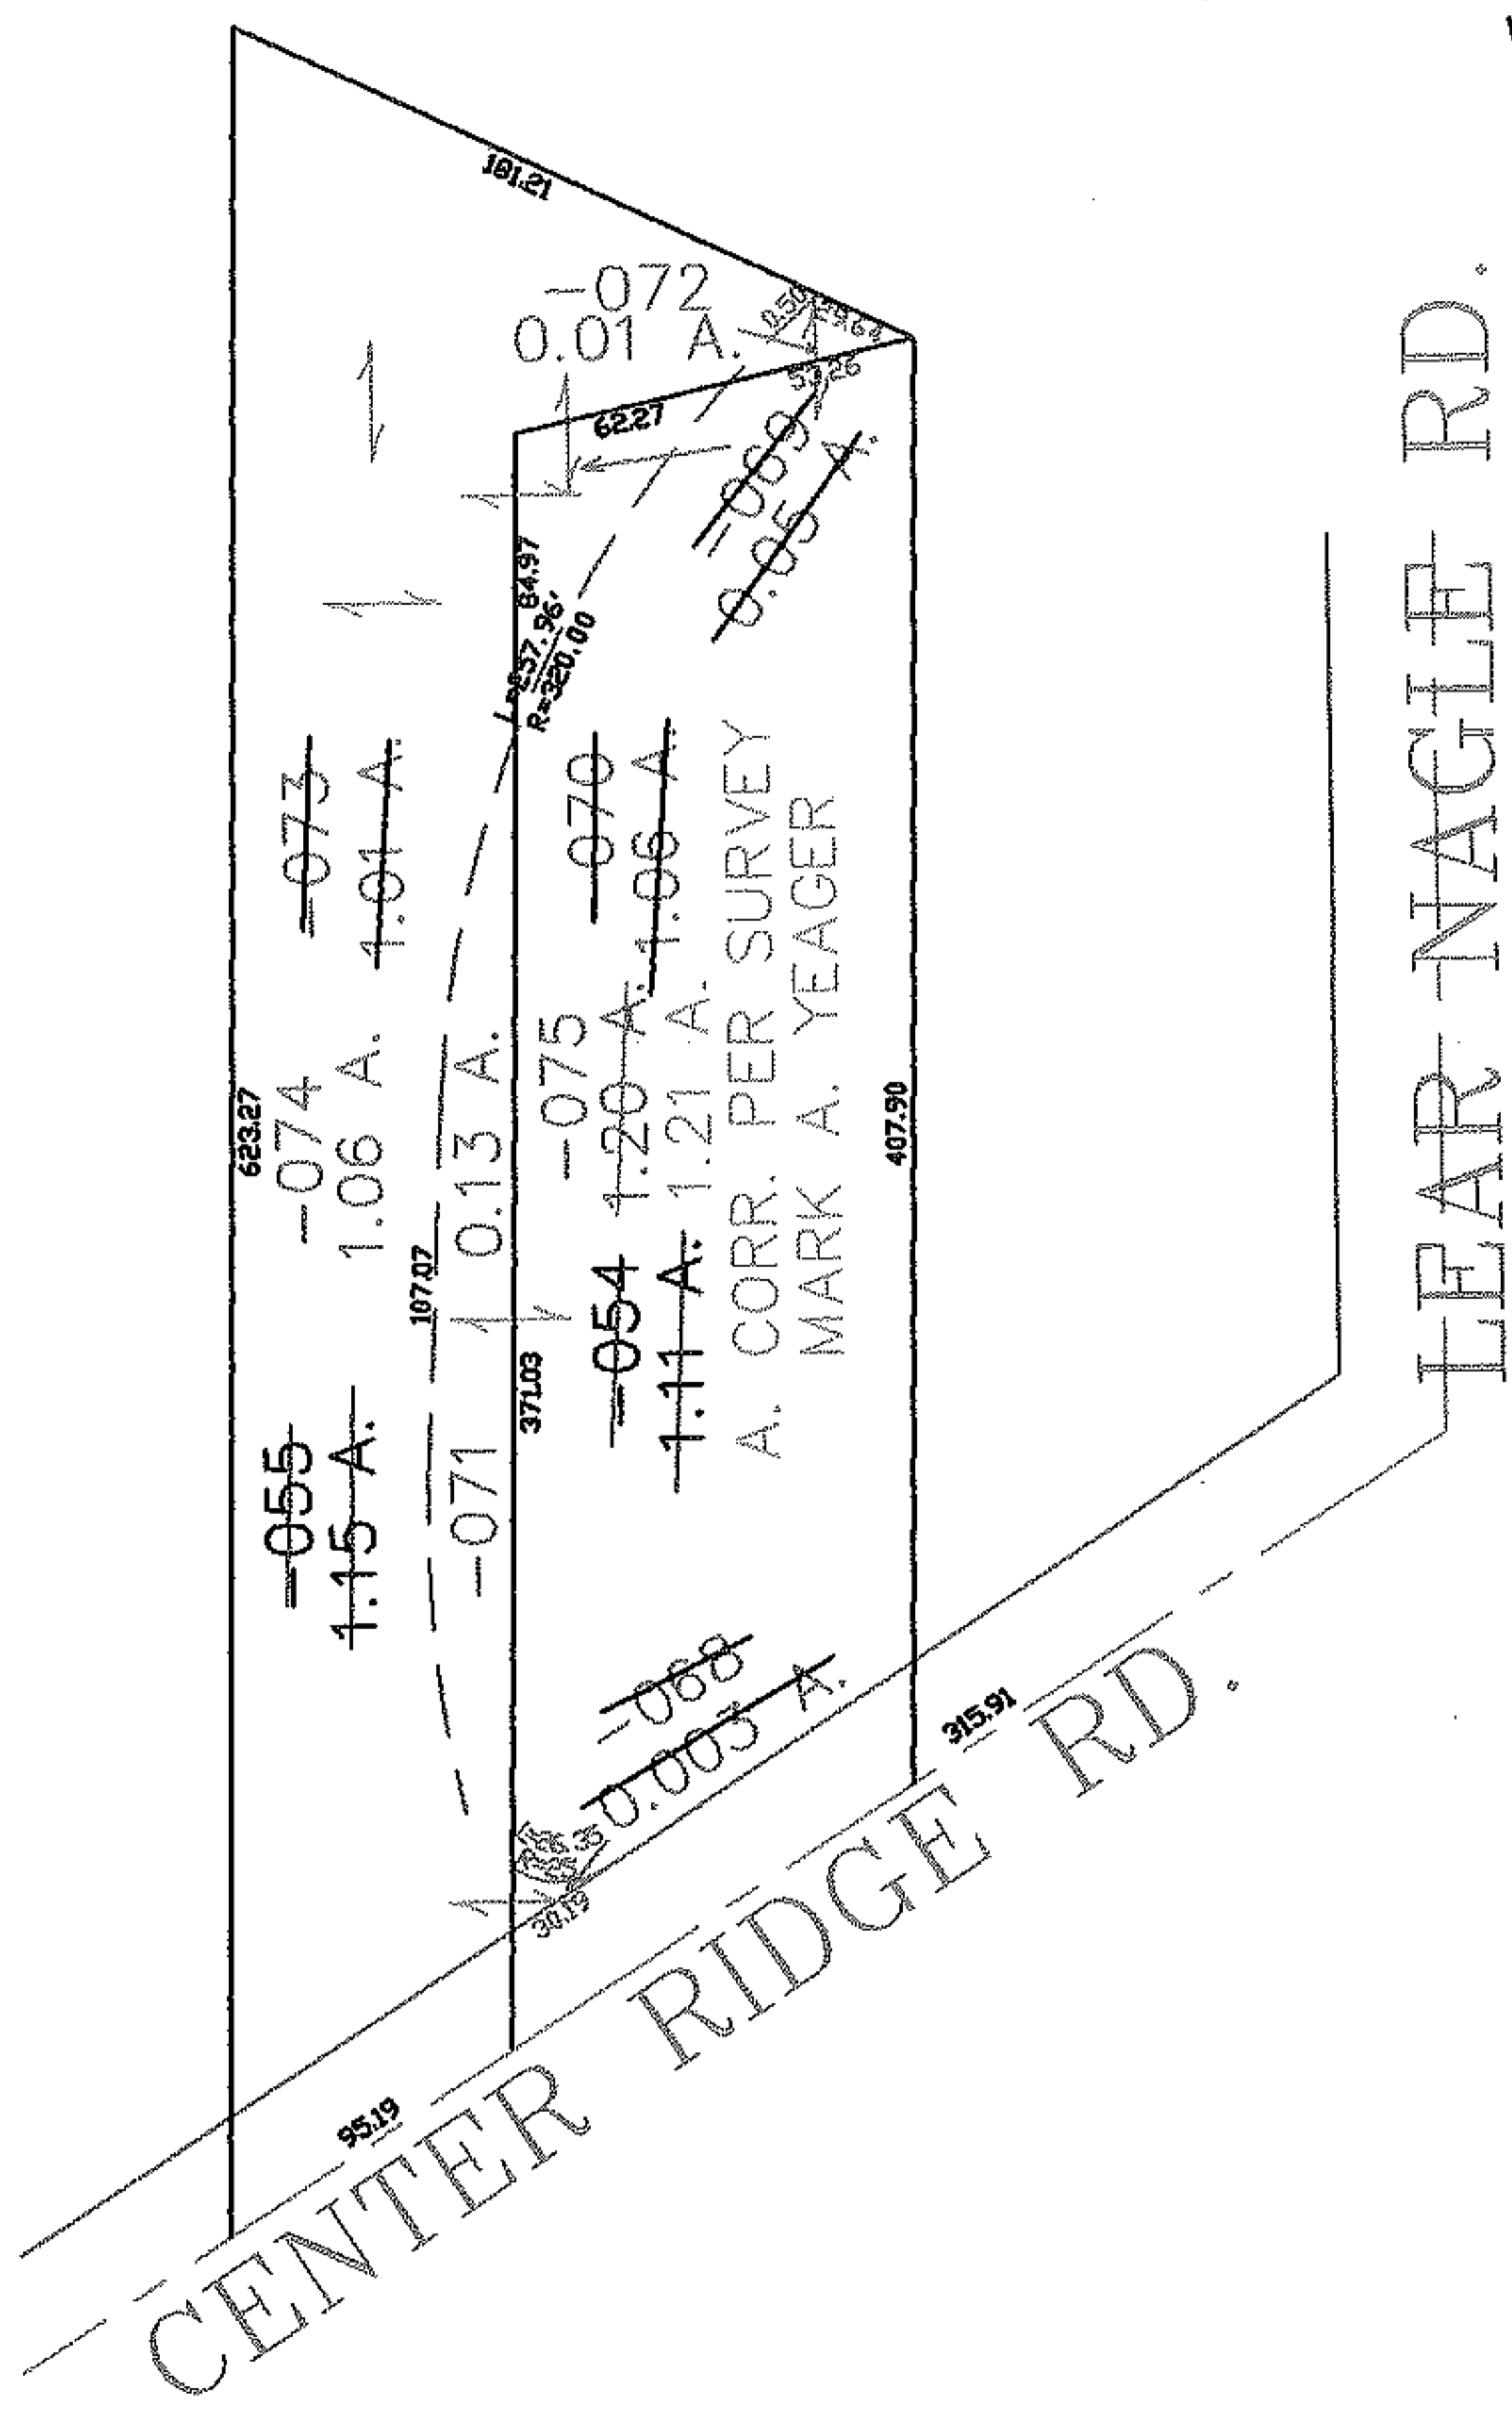


RASTER

PARENT PARCEL: 07-00-008-117-054, -055  
CHILD PARCEL: 07-00-008-117-068 THRU -075  
STARTING POINT: CENTERLINE OF CENTERRIDGE RD. & LEAR NAGLE RD.

NO. 01810

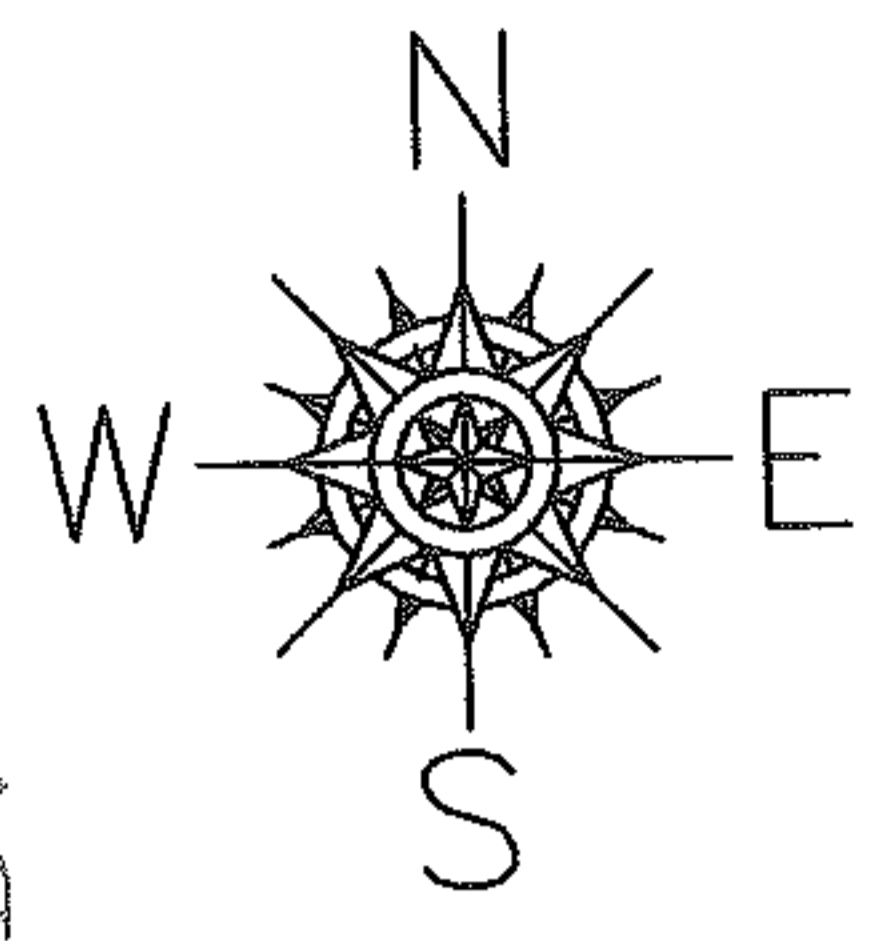

**SPLITS/DEEDS PROCESSED**  
LORAIN COUNTY TAX MAP DEPARTMENT  
226 MIDDLE AVE. ELYRIA, OHIO

SURVEYED BY: MARK A YEAGER  
CLOSURE: 0.00 : 10.000  
MAP PAGE(S): 07-00-008-C  
APPROVED BY: JAH DATE: 12-14-04  
SCALE: 1" = 100 PRIOR INSTRUMENT: 990600272