




RASTER

PARENT PARCEL: 04-00-019-143-036, -037, -252

CHILD PARCEL: 04-00-019-143-465 THRU -474

STARTING POINT: CENTERLINE OF GABLE RD. & JAYCOX RD.

NO. 01813

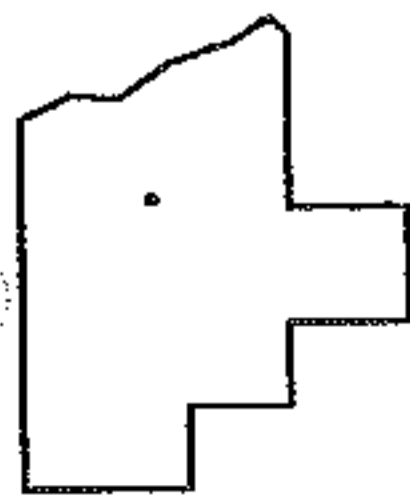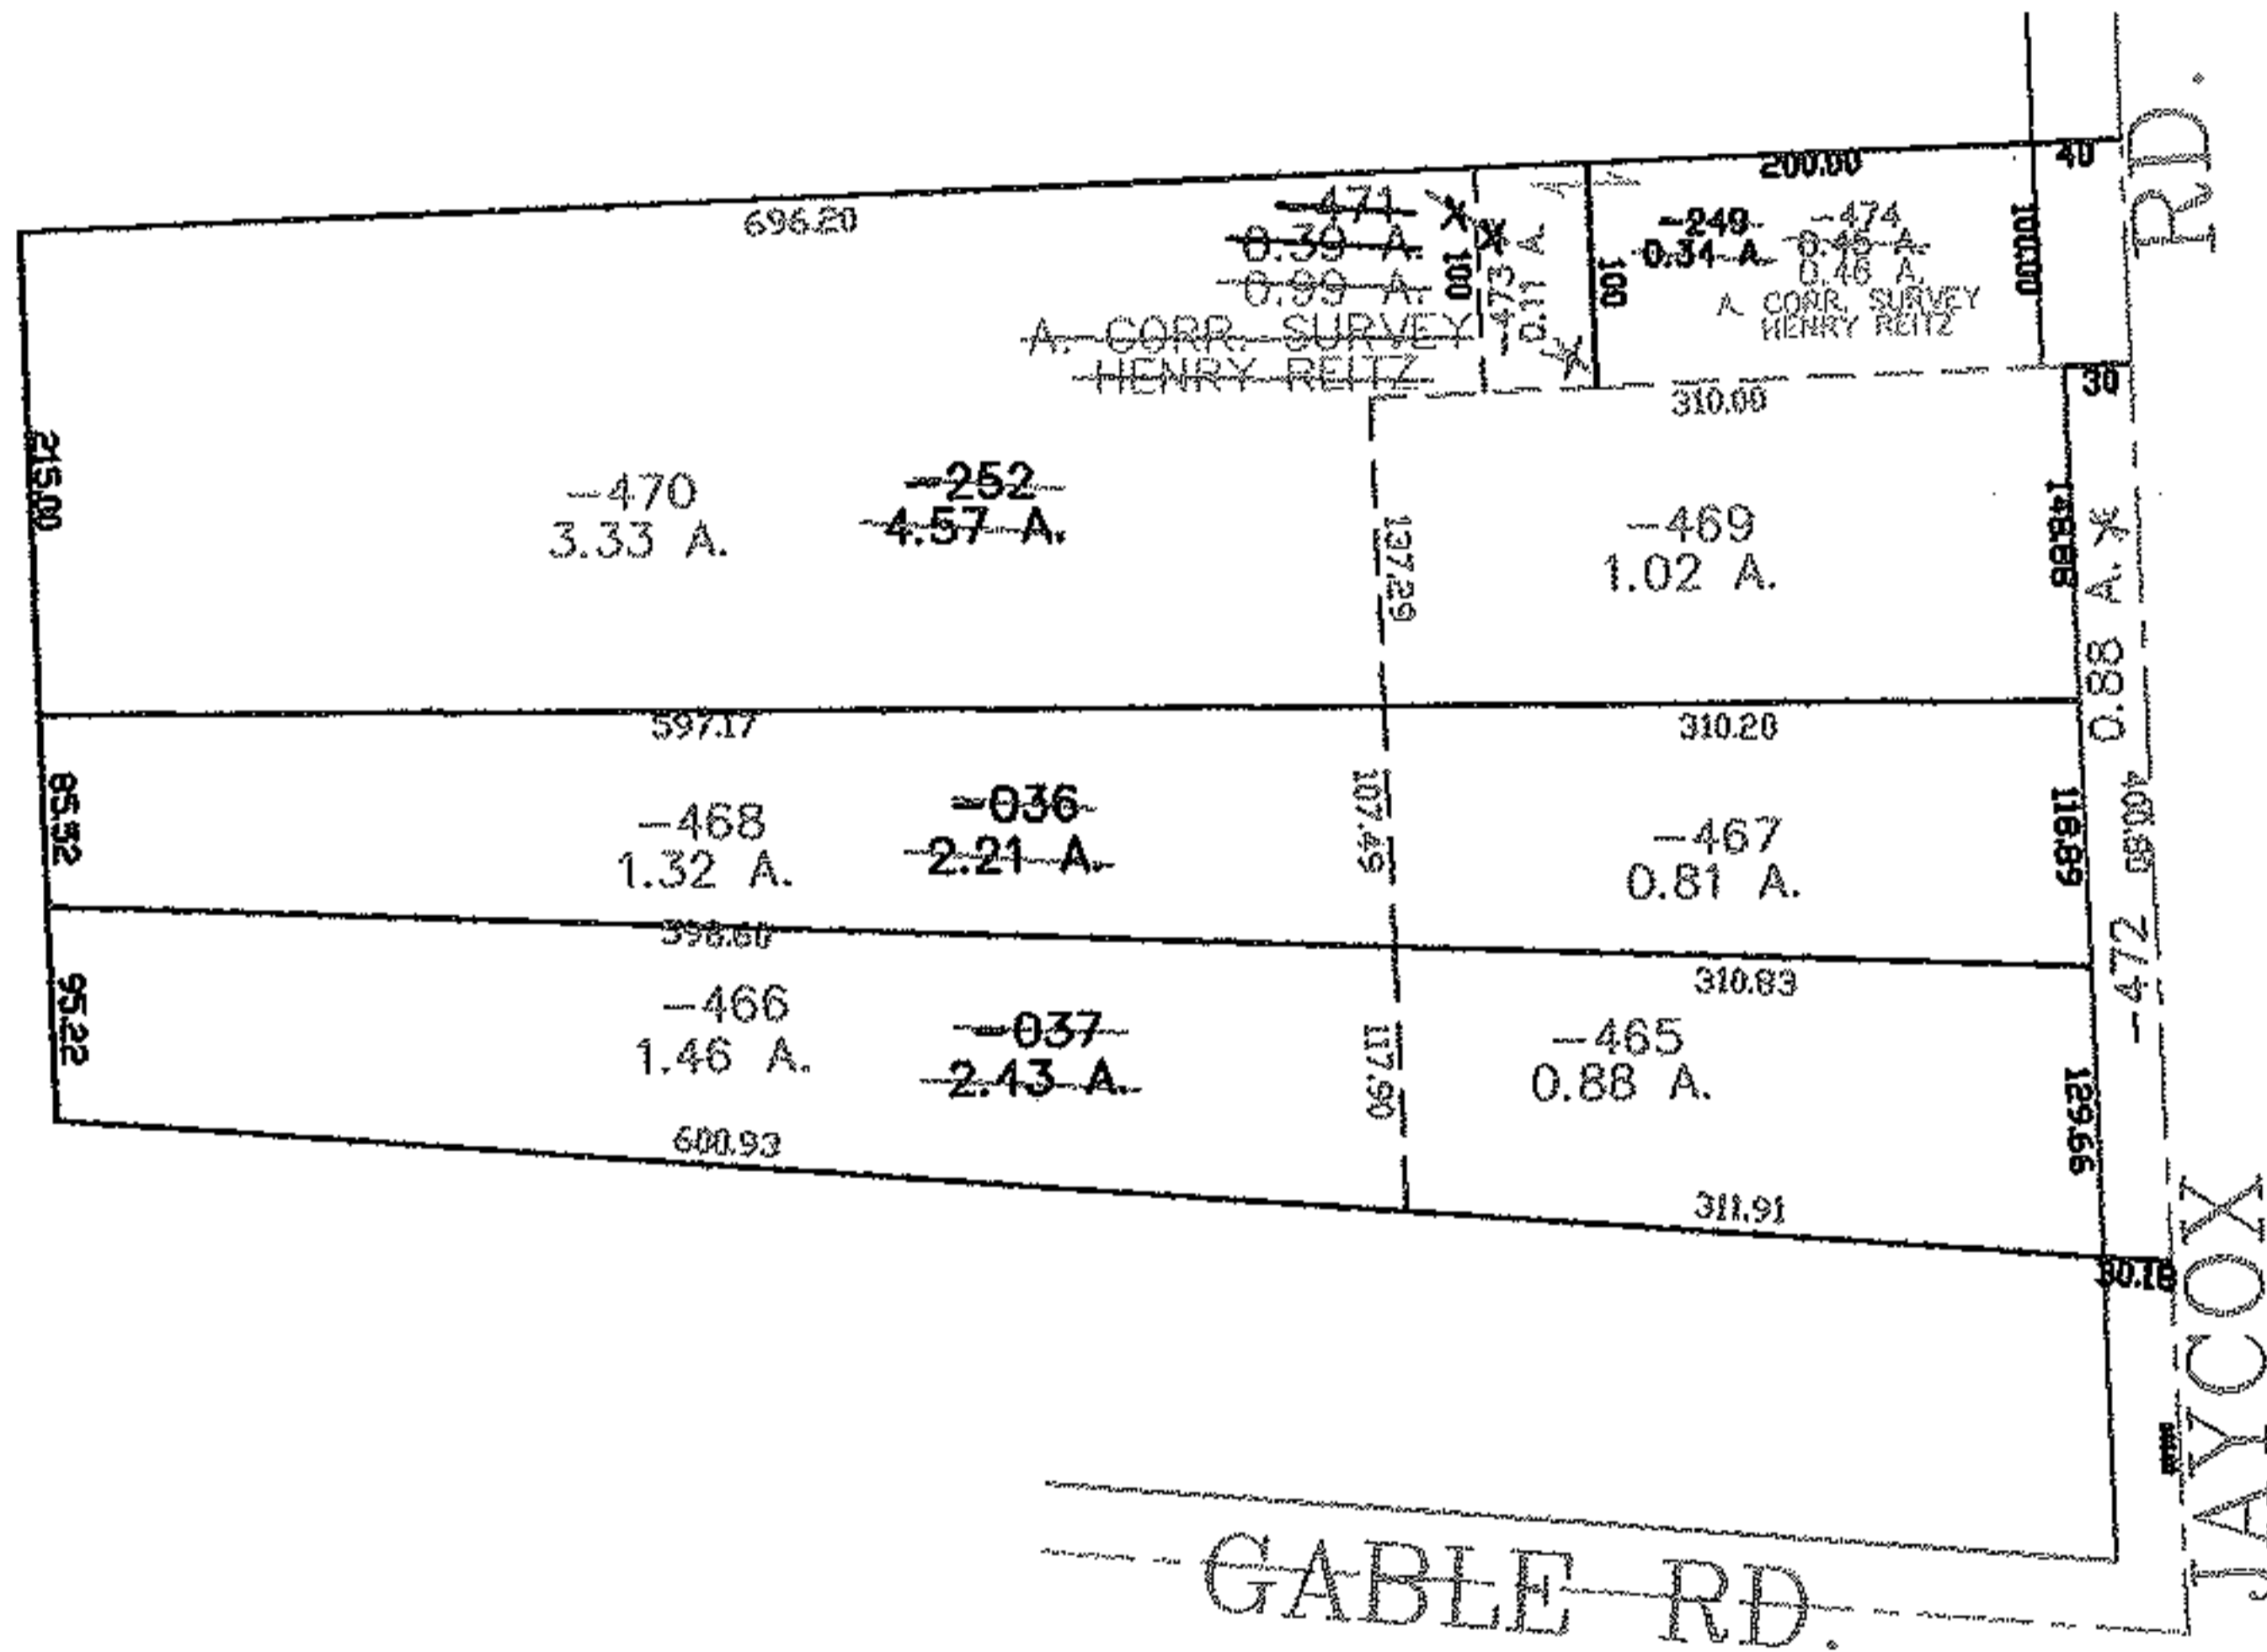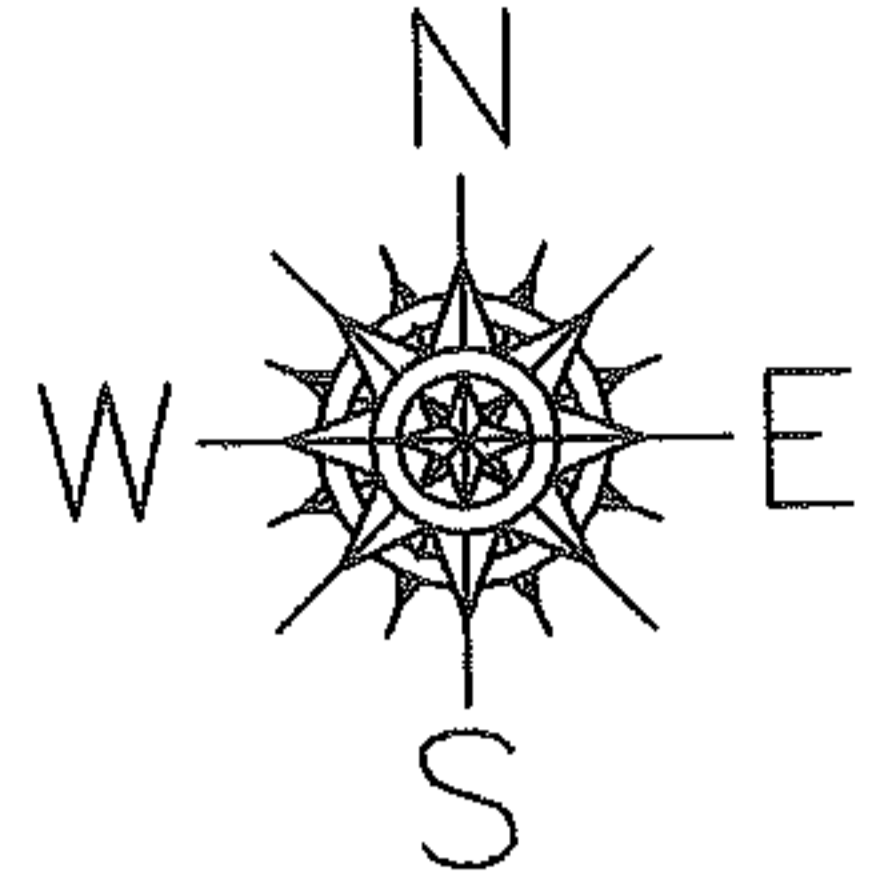

SPLITS/DEEDS PROCESSED
 LORAIN COUNTY TAX MAP DEPARTMENT
 226 MIDDLE AVE. ELYRIA, OHIO

SURVEYED BY: HENRY REITZ
 CLOSURE: 0.00 : 10.000
 MAP PAGE(S): 04-00-019-F
 APPROVED BY: JAH DATE: 12-15-04
 SCALE: 1" = 200 PRIOR INSTRUMENT: OR 1283/612