


PARENT PARCEL: 01-00-043-000-030

09-01817-C

CHILD PARCEL: --SAME--

STARTING POINT: MON BOX AT INT CL NORTH RIDGE AND BAUMHART RD

# NORTH RIDGE


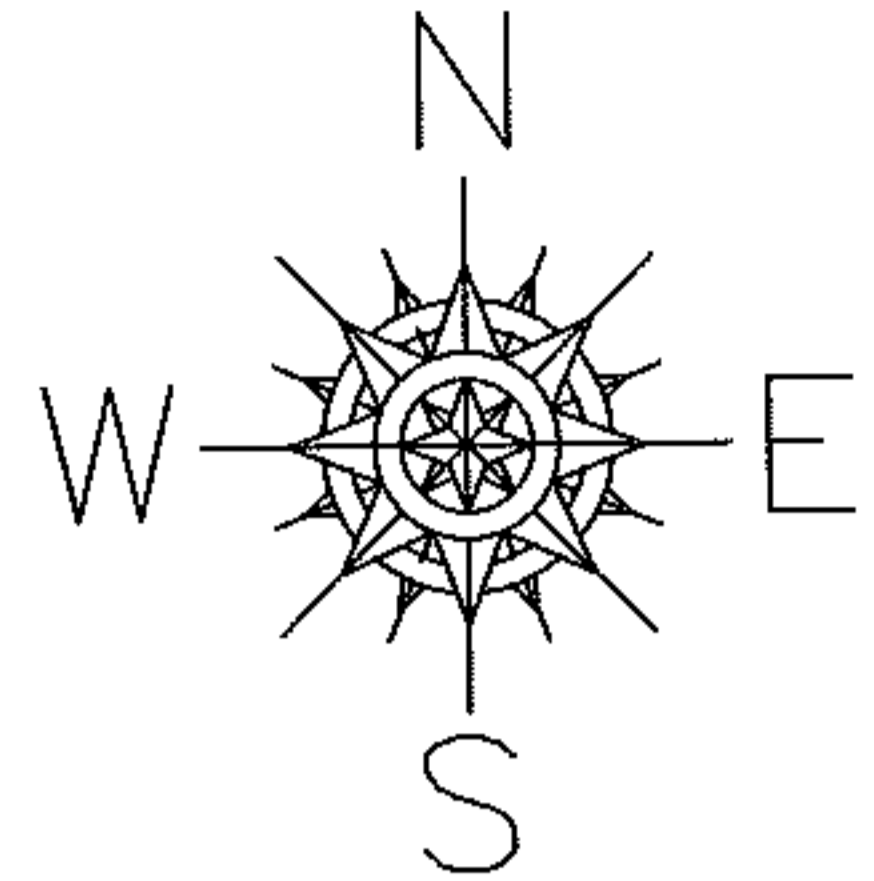


M

# BAUMHART ROAD

375.00

AC. CORR.  
PER SURVEY  
EDWARD DUDLEY

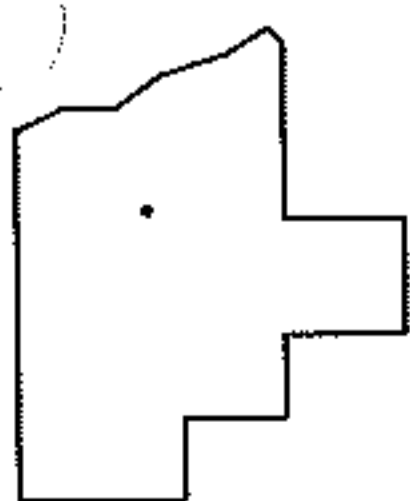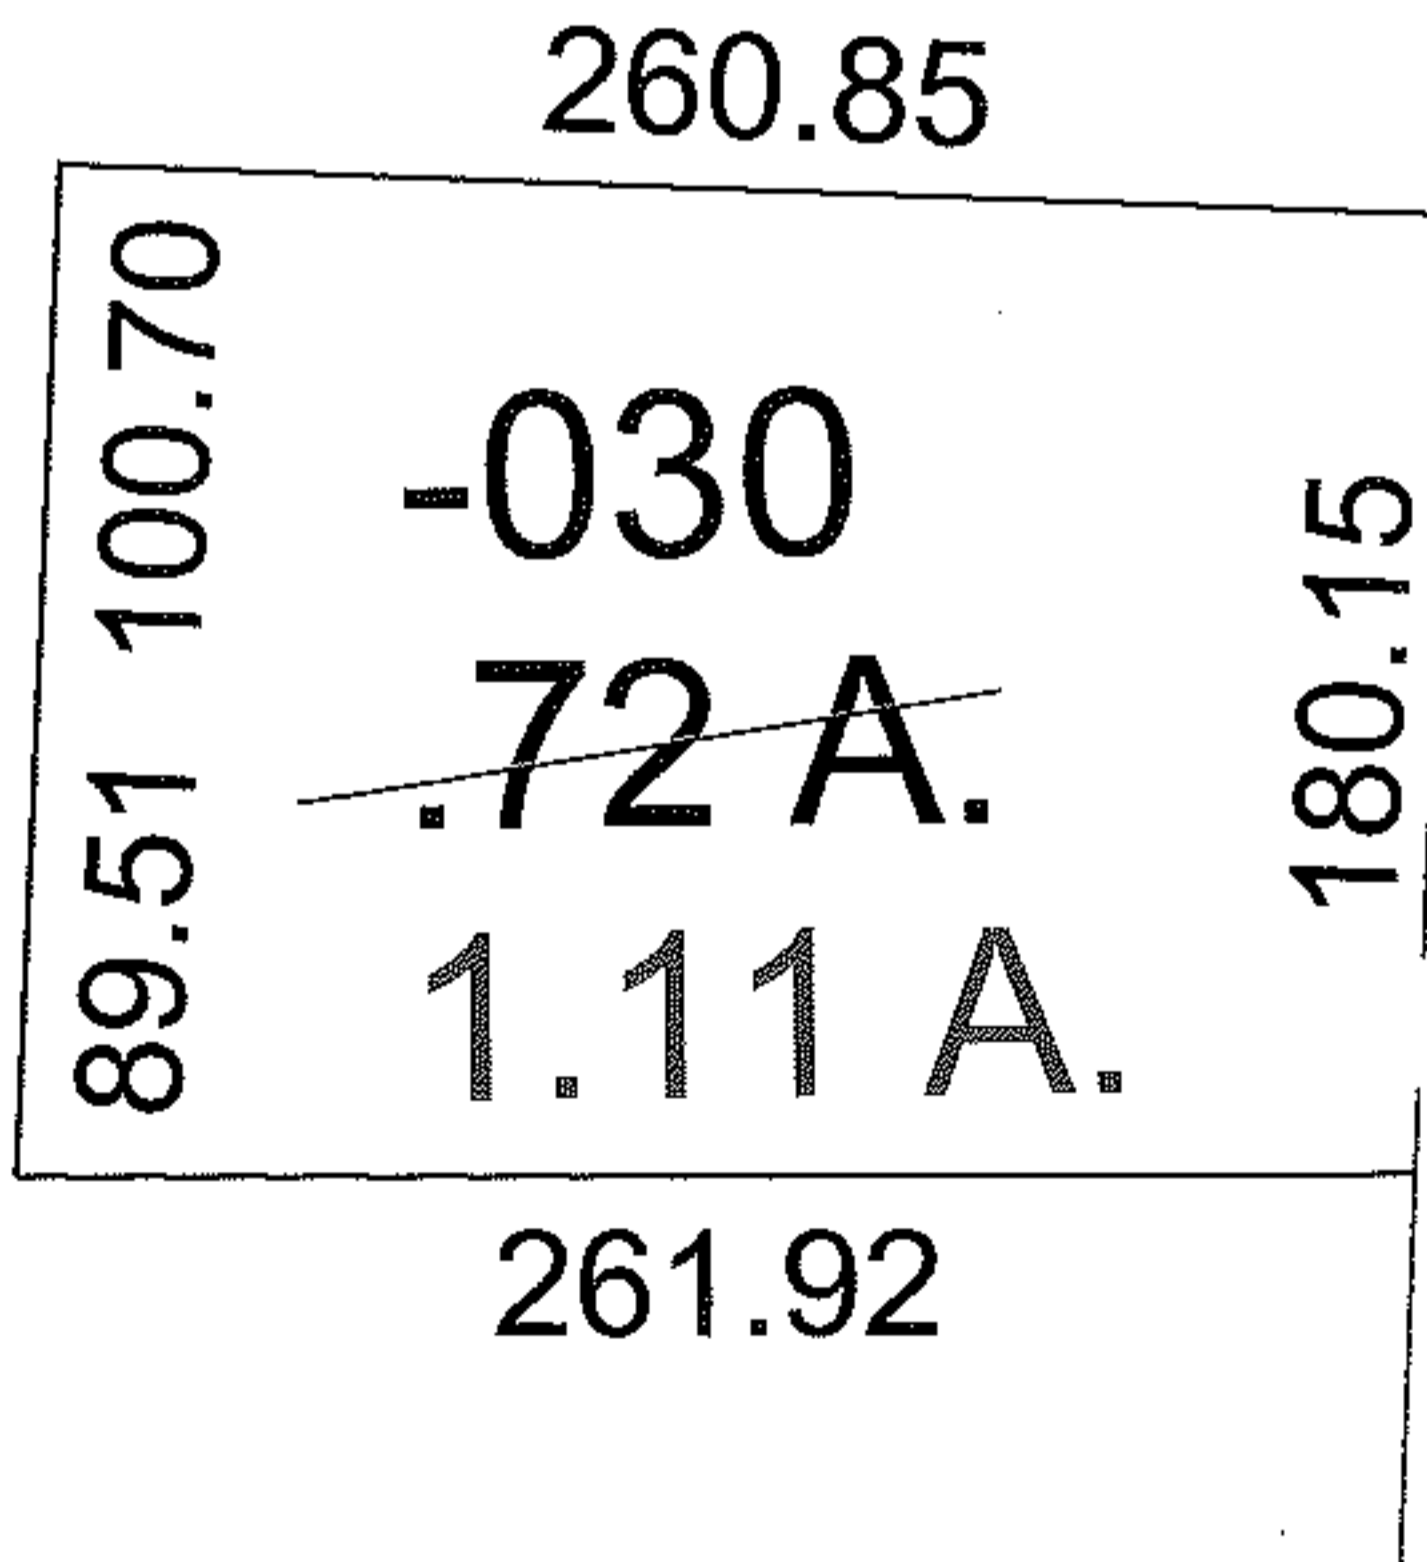

### SPLITS/DEEDS PROCESSED

LORAIN COUNTY TAX MAP DEPARTMENT  
226 MIDDLE AVE. ELYRIA, OHIO

SURVEYED BY: EDWARD B. DUDLEY

CLOSURE: 1:10,000

MAP PAGE(S): 01-00-043-B

APPROVED BY: DRH DATE: 6/15/2009

SCALE: 1"= 100 PRIOR INST.: 20090294206